


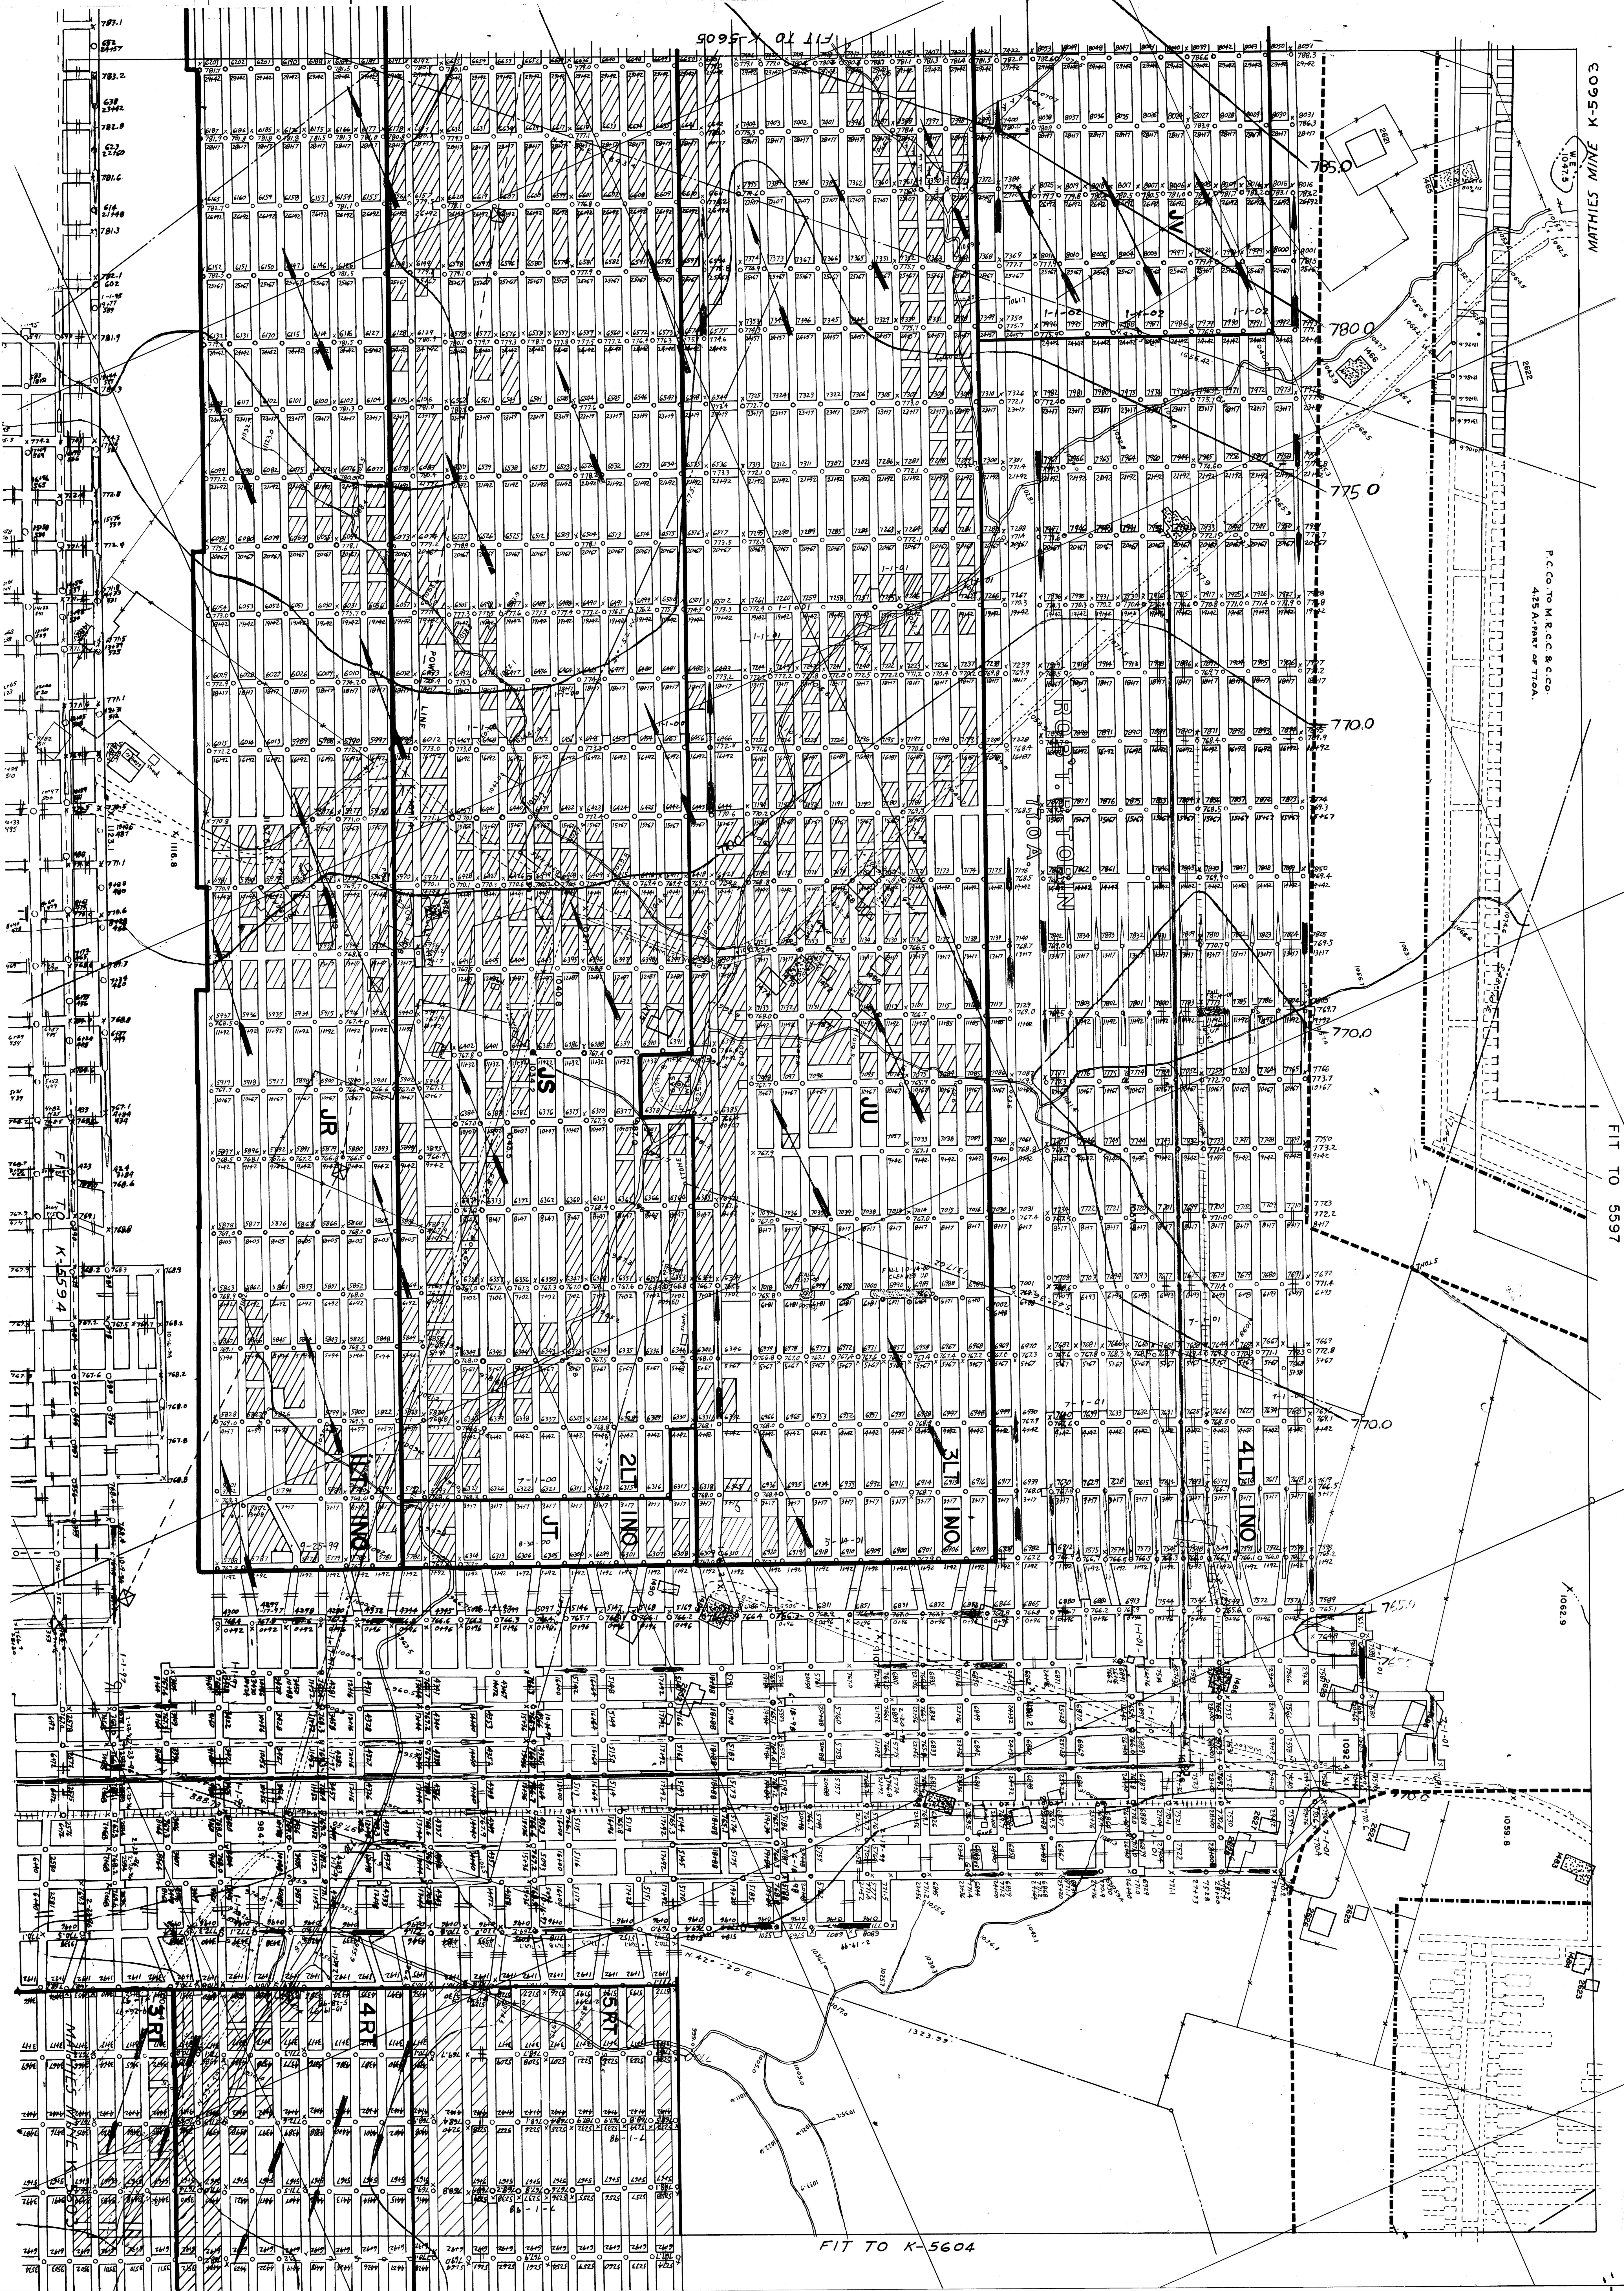


P.C. CO. TO M.R.C.C. & C. CO.
425 A PART OF T10A.


X 1062.9

1059.8

1059.8

FIT TO K-5604