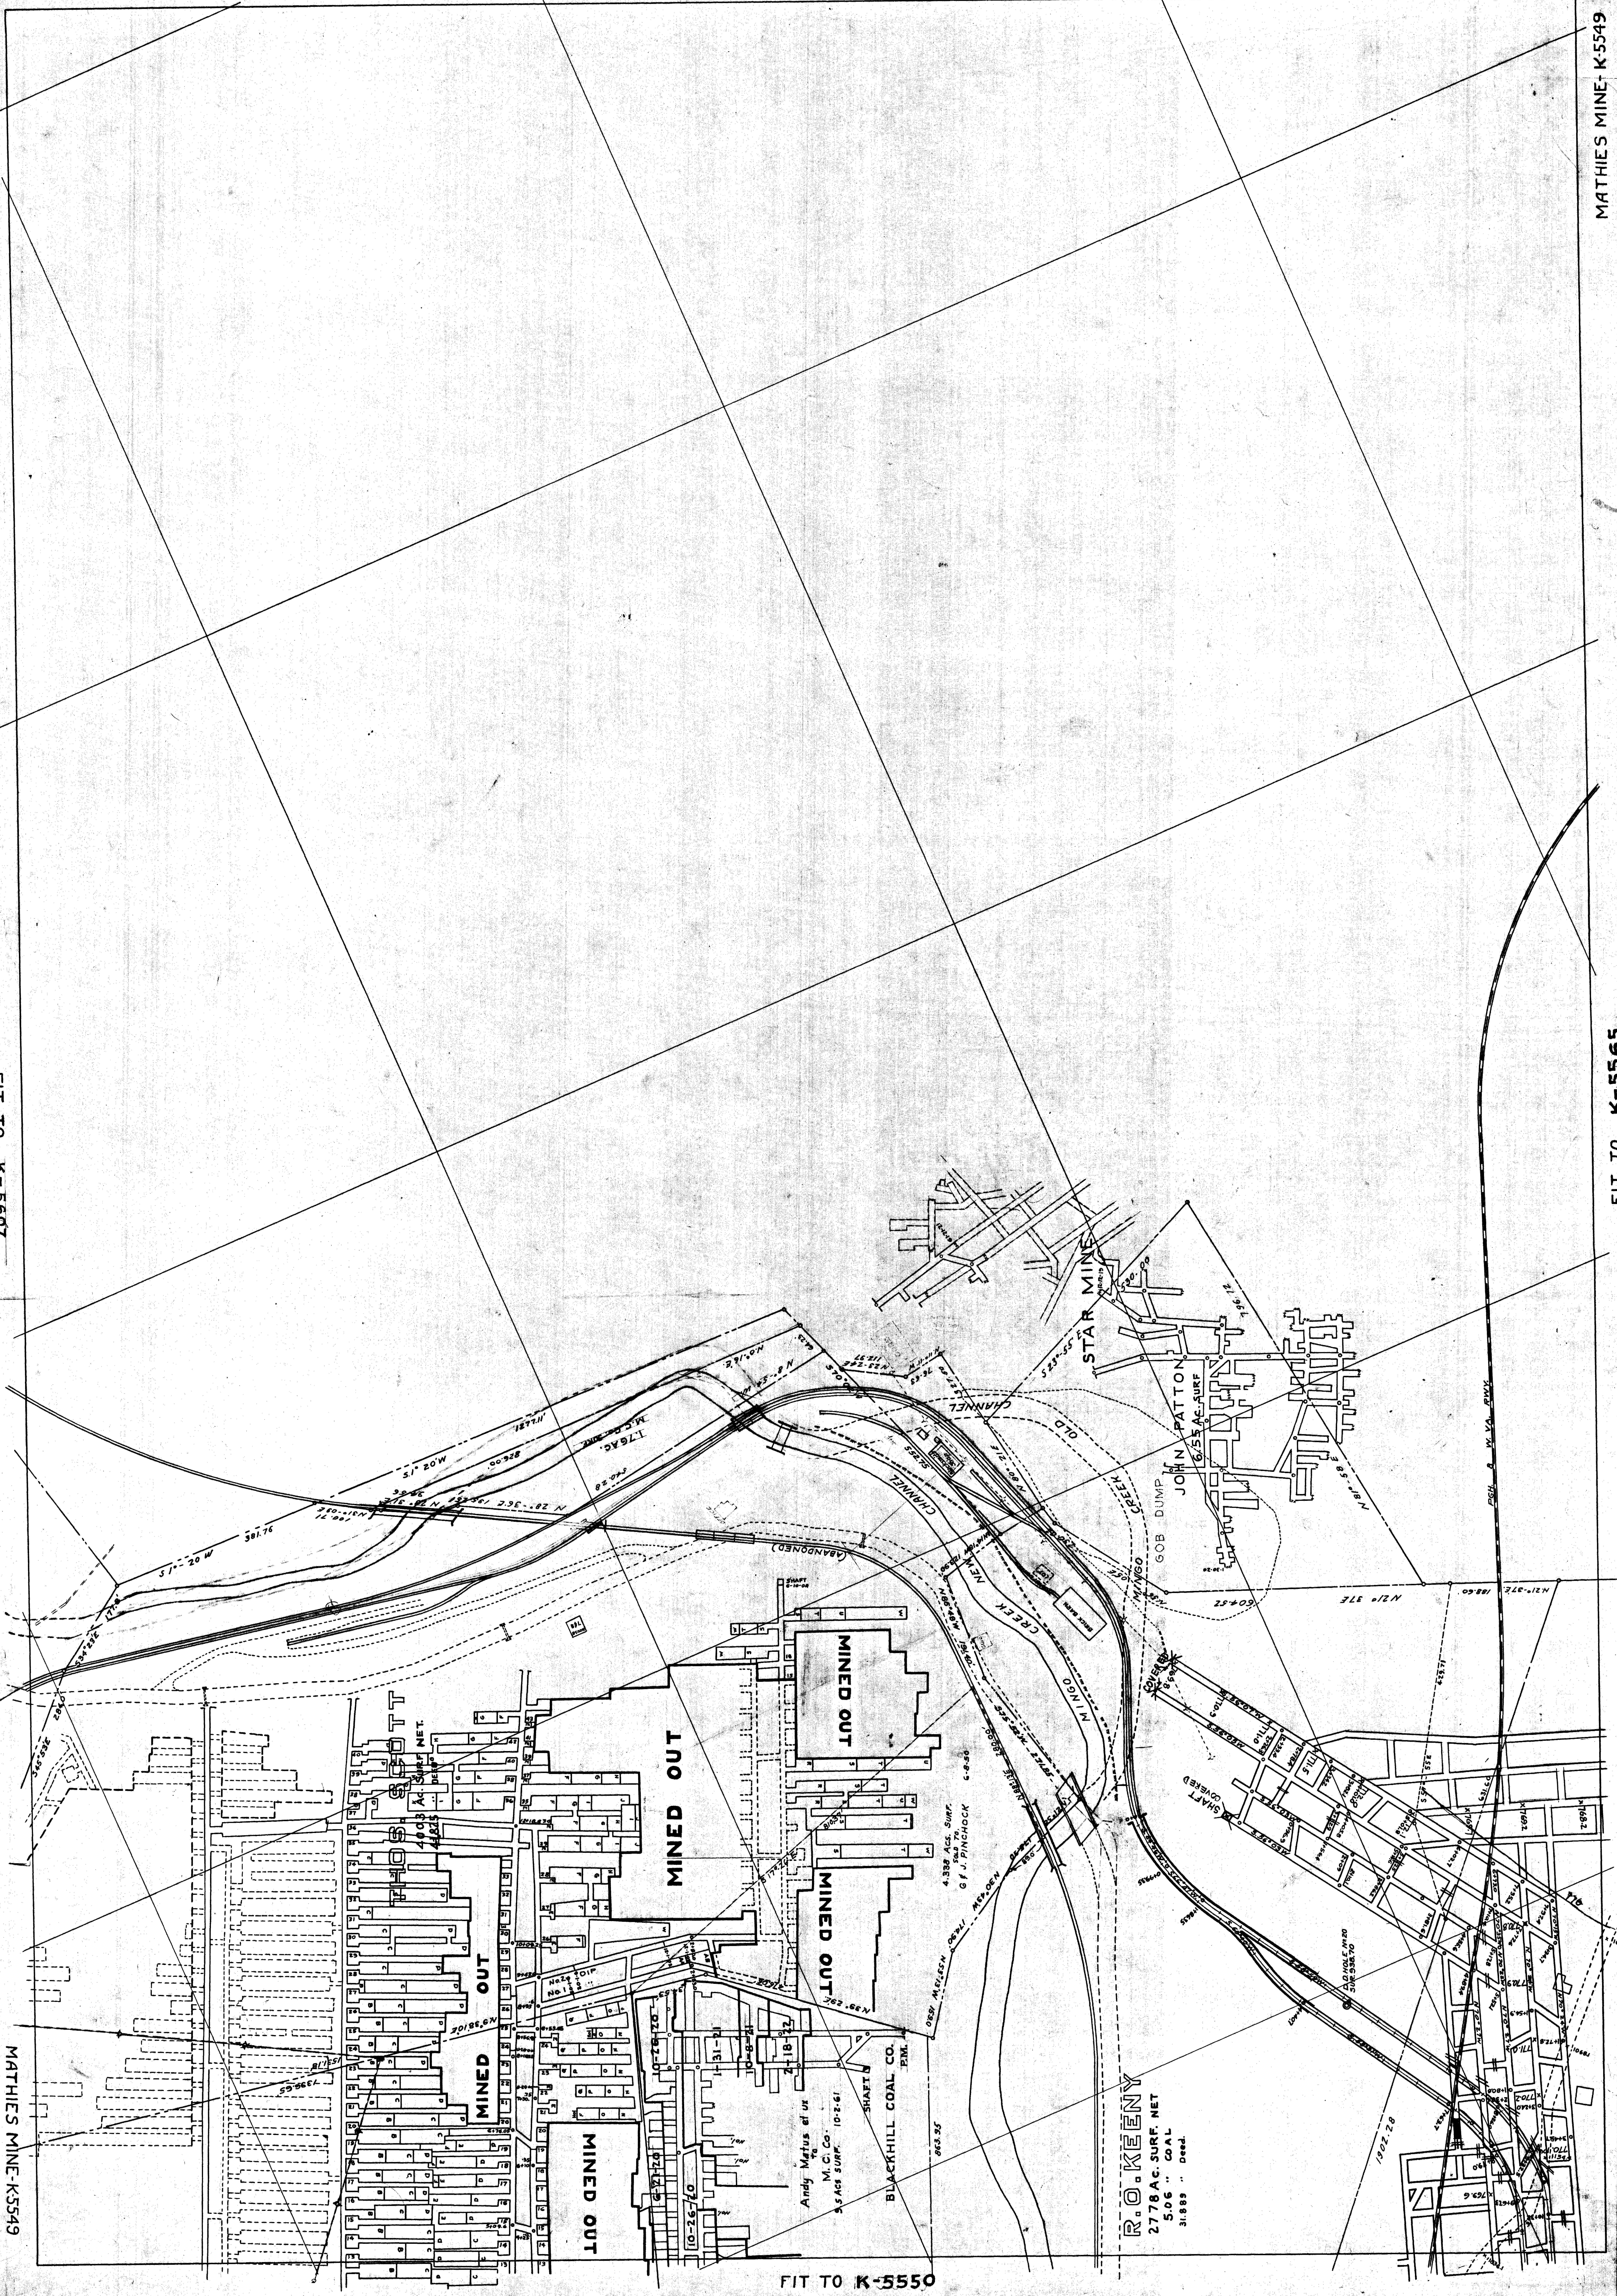
STAR MINE
JOHN PATTON
6.55 AC. SURF
GOB DUMP
OLD
CHANNEL
NEW
CHANNEL
MINGO CREEK
MINGO
CREEK
(ABANDONED)
PGH. & W. VA. RWY.
BRICK BARN
M.C.Co. 1.76 AC.
THOS SCOTT
40.03 Ac. SURF. NET.
41.825 " DEED
MINED OUT
MINED OUT
MINED OUT
MINED OUT
MINED OUT
MINED OUT
SHAFT 6-10-08
No.2 DIP
No.1
10-26-20
1-31-21
10-8-21
2-18-22
6-21-20
10-26-20
Andy Matus et ux to M.C. Co. 9.5 ACS SURF. 10-2-61
SHAFT
BLACKHILL COAL CO. P.M.
4.338 ACS. SURF. SOLD TO G & J. PINCHOCK 6-8-50
R.O. KEENY
2778 Ac. SURF. NET
5.06 " COAL
31.889 " Deed.
SHAFT COVERED
COVERED
D.D. HOLE No 20 SUR. 938.70
S 1° 20' W
381.76
S 1° 20' W
1277.11'
826.00
540.28
N 28°-36'E
N 31°-03'E
100.71
S 34°23'E
284.0
S 45°53'E
171.8
N 8°-54'W
N 0°16'E
64.23
S 70°-05'E
N 23-24E
112.37
N 11-01 W
S 23°-55'E
530.00
796.72
N 81°-58'E
N 80° 21'E
N 21° 37'E
604.52
188.60
N 21°-37'E
1902.28
863.95
N 39° 29'E
S 17°24'E
1-30-20
12-12-19

FIT TO

MATHIES MINE-K-5549

FIT TO K-5565

FIT TO K-5607

FIT TO K-5550

MATHIES MINE-K5549