


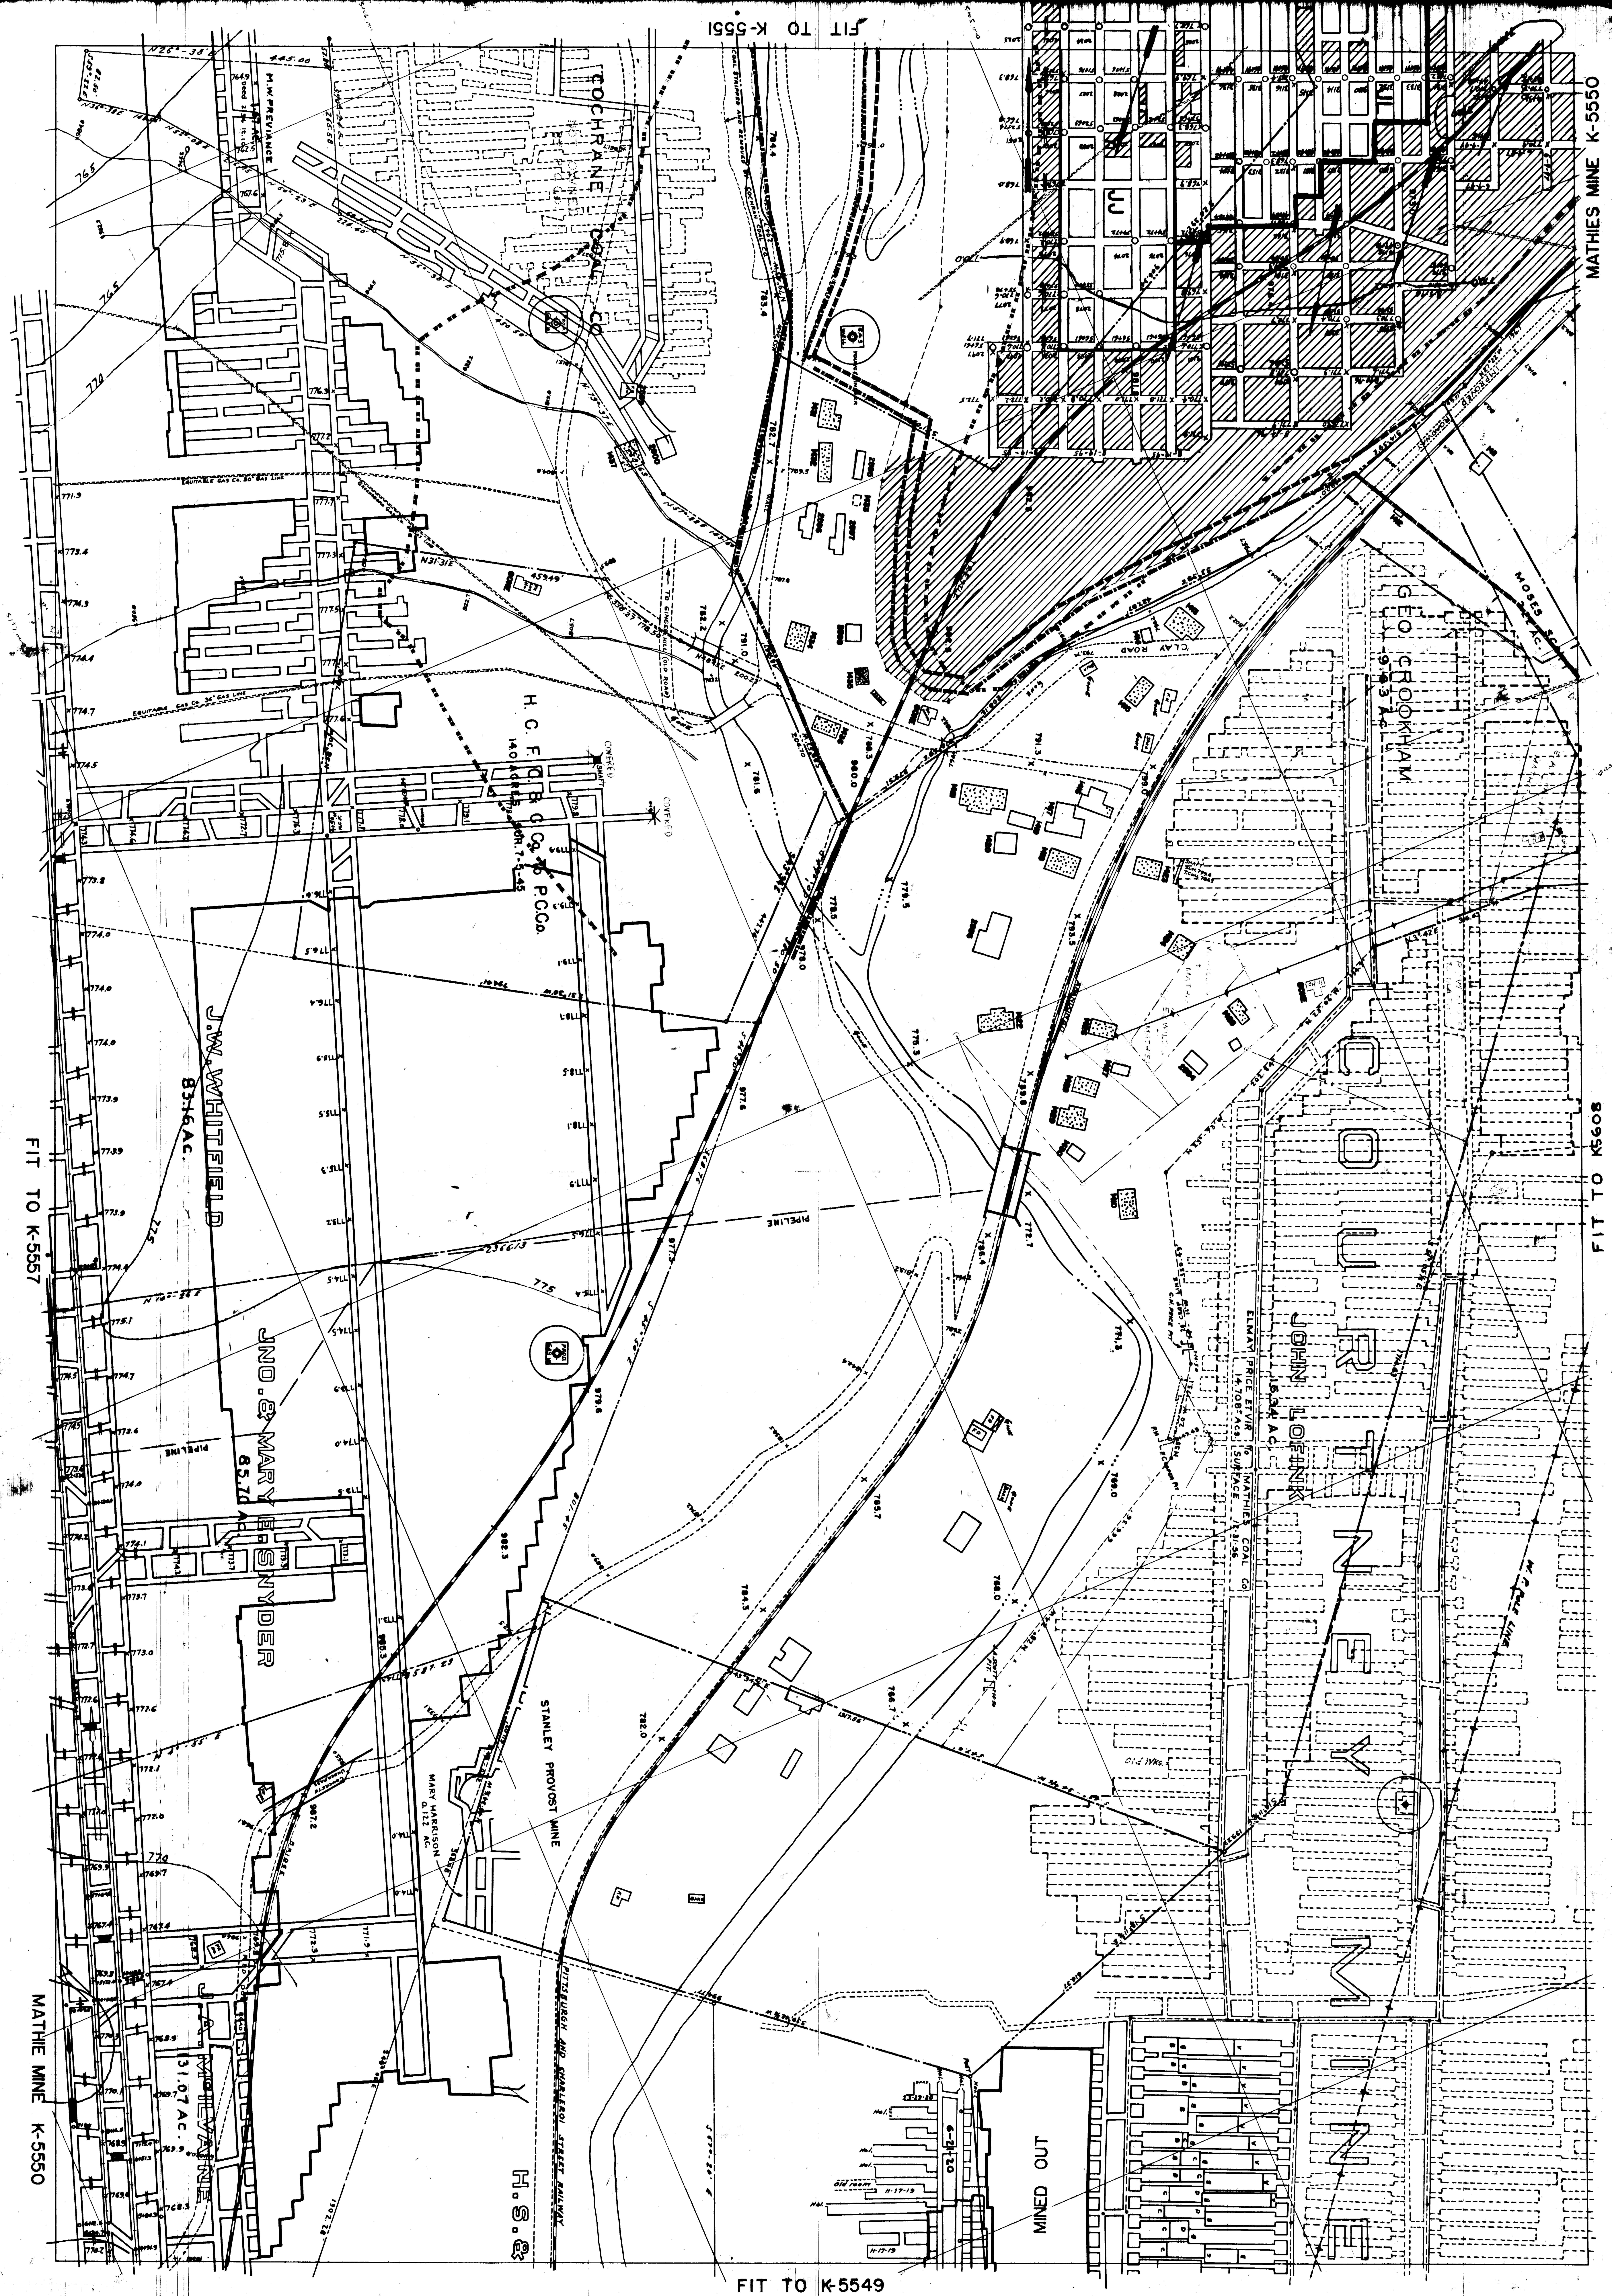

MATHIES MINE K-5550

FILE TO K5608

FIT TO K-5549