


FIT TO K-5559

FIT TO

FIT TO K-5589

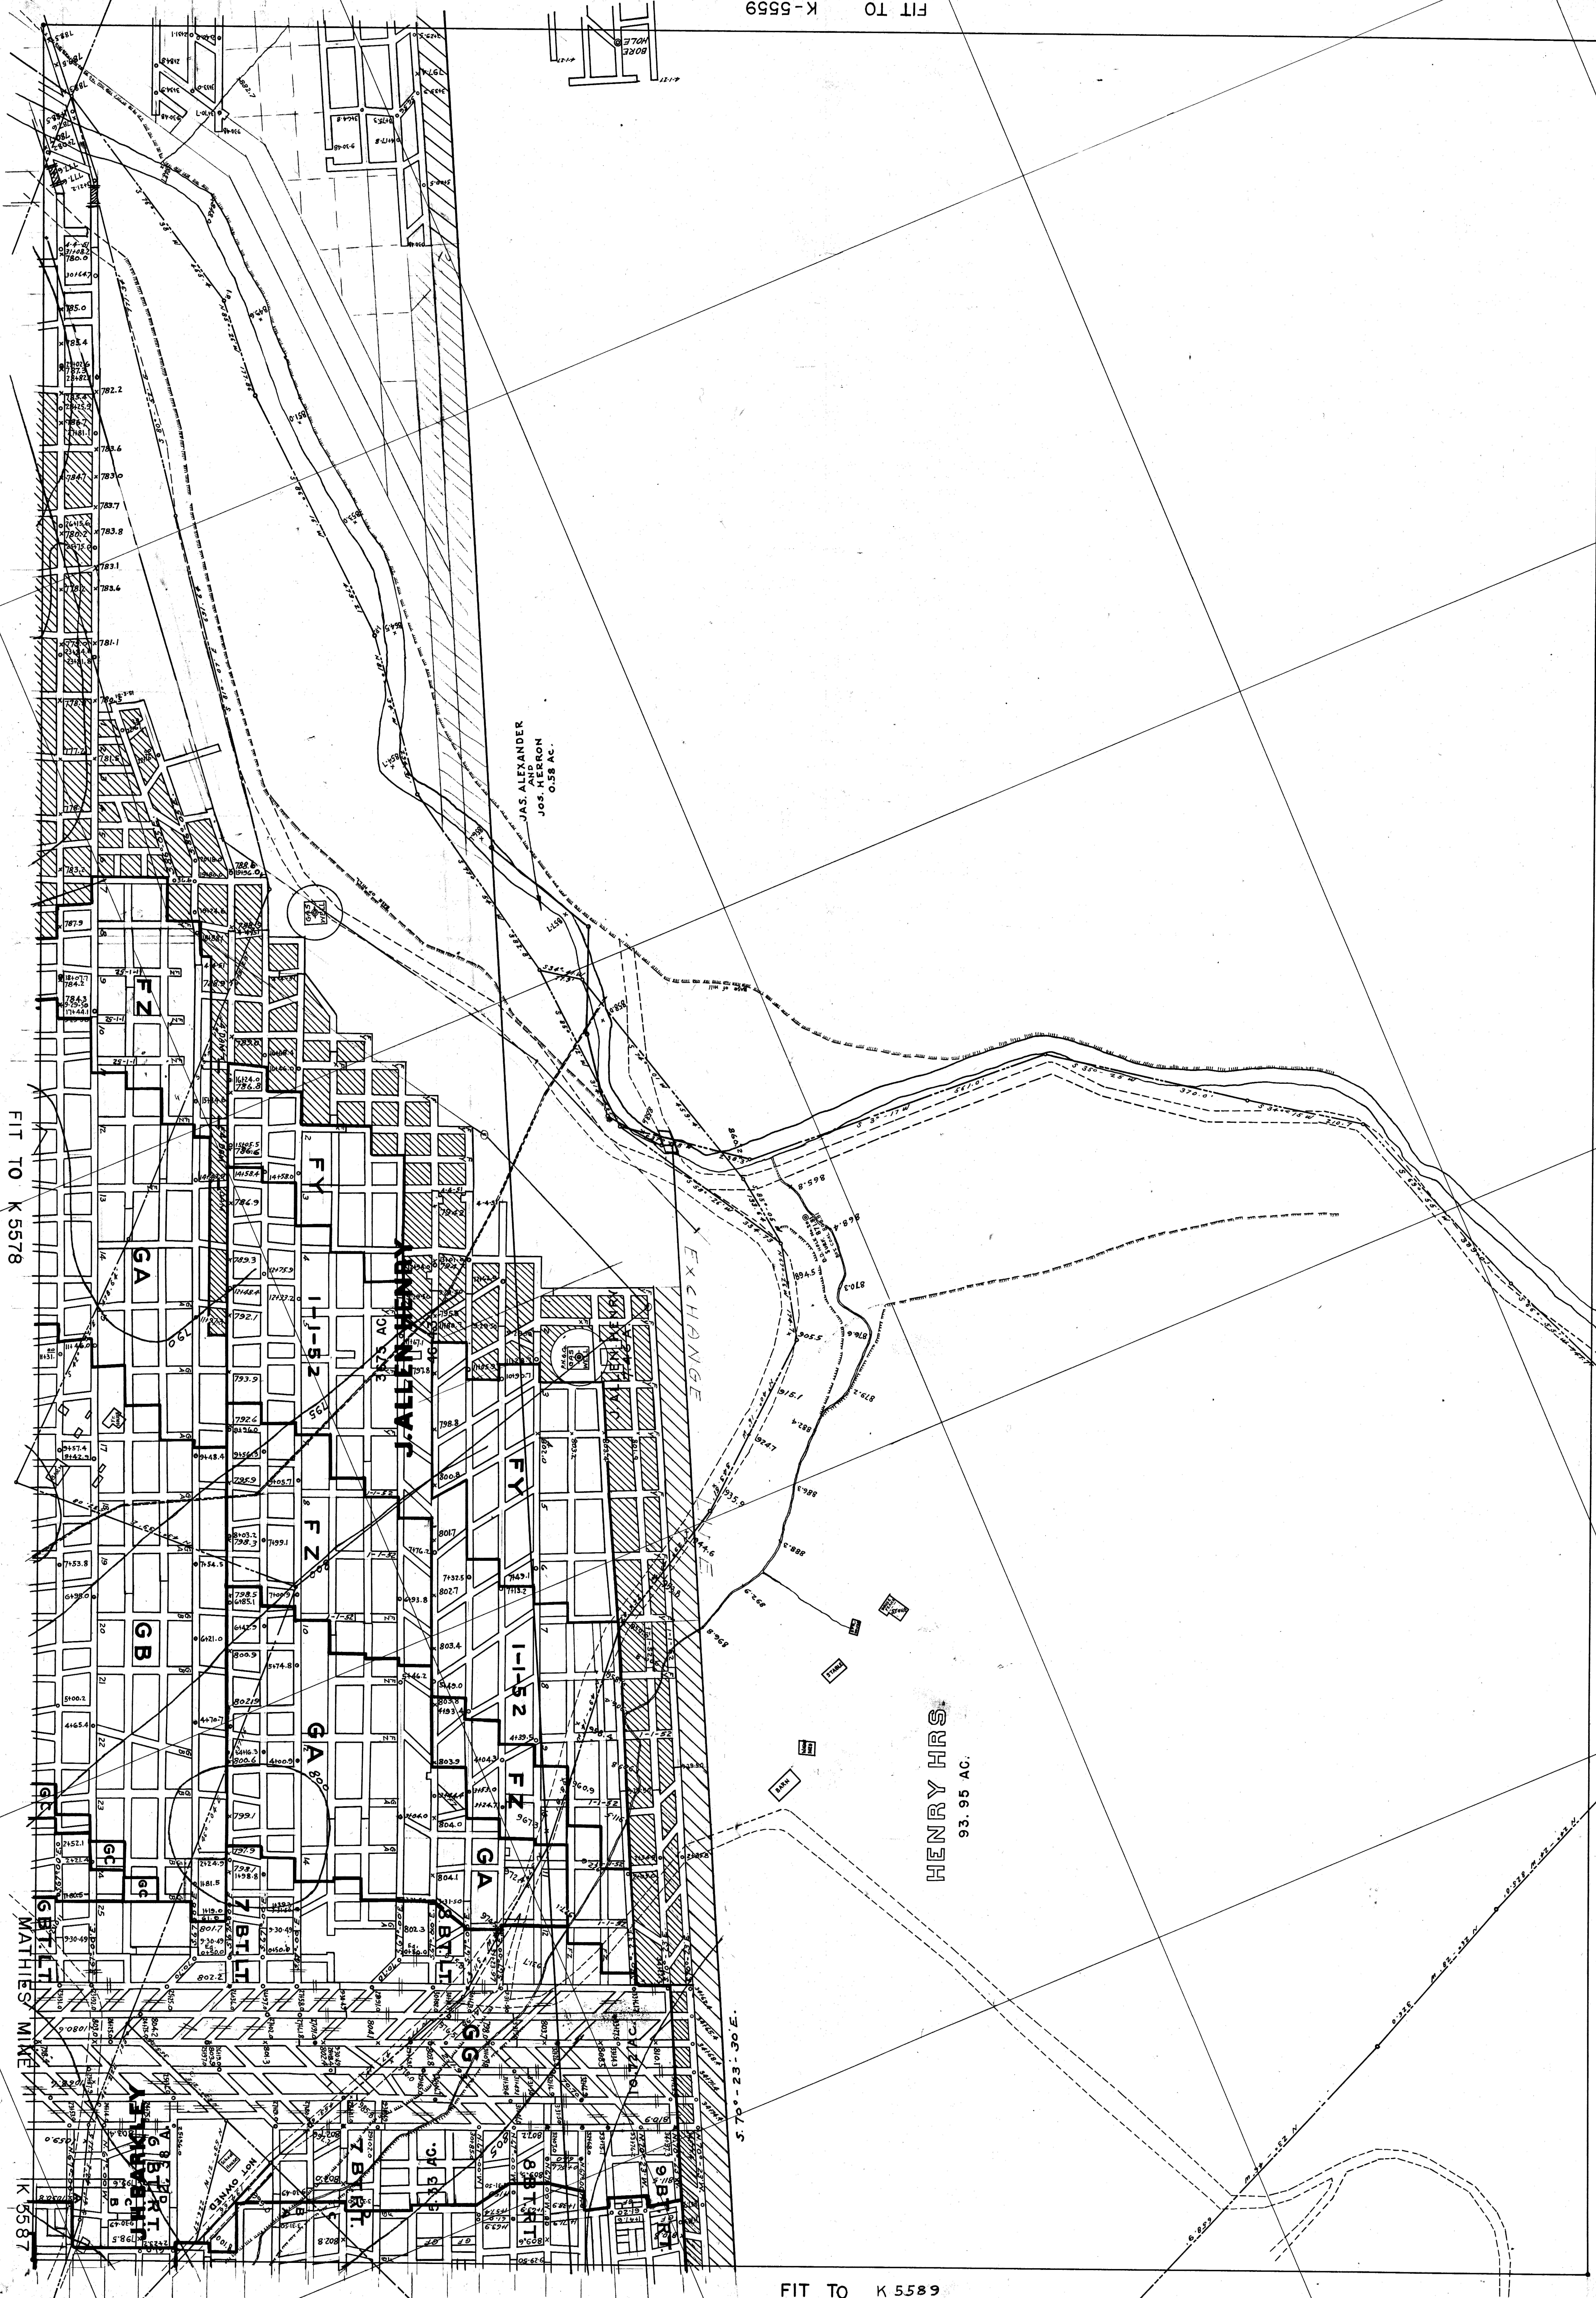

FIT TO K-5578

MATHIES MINE K-5587