


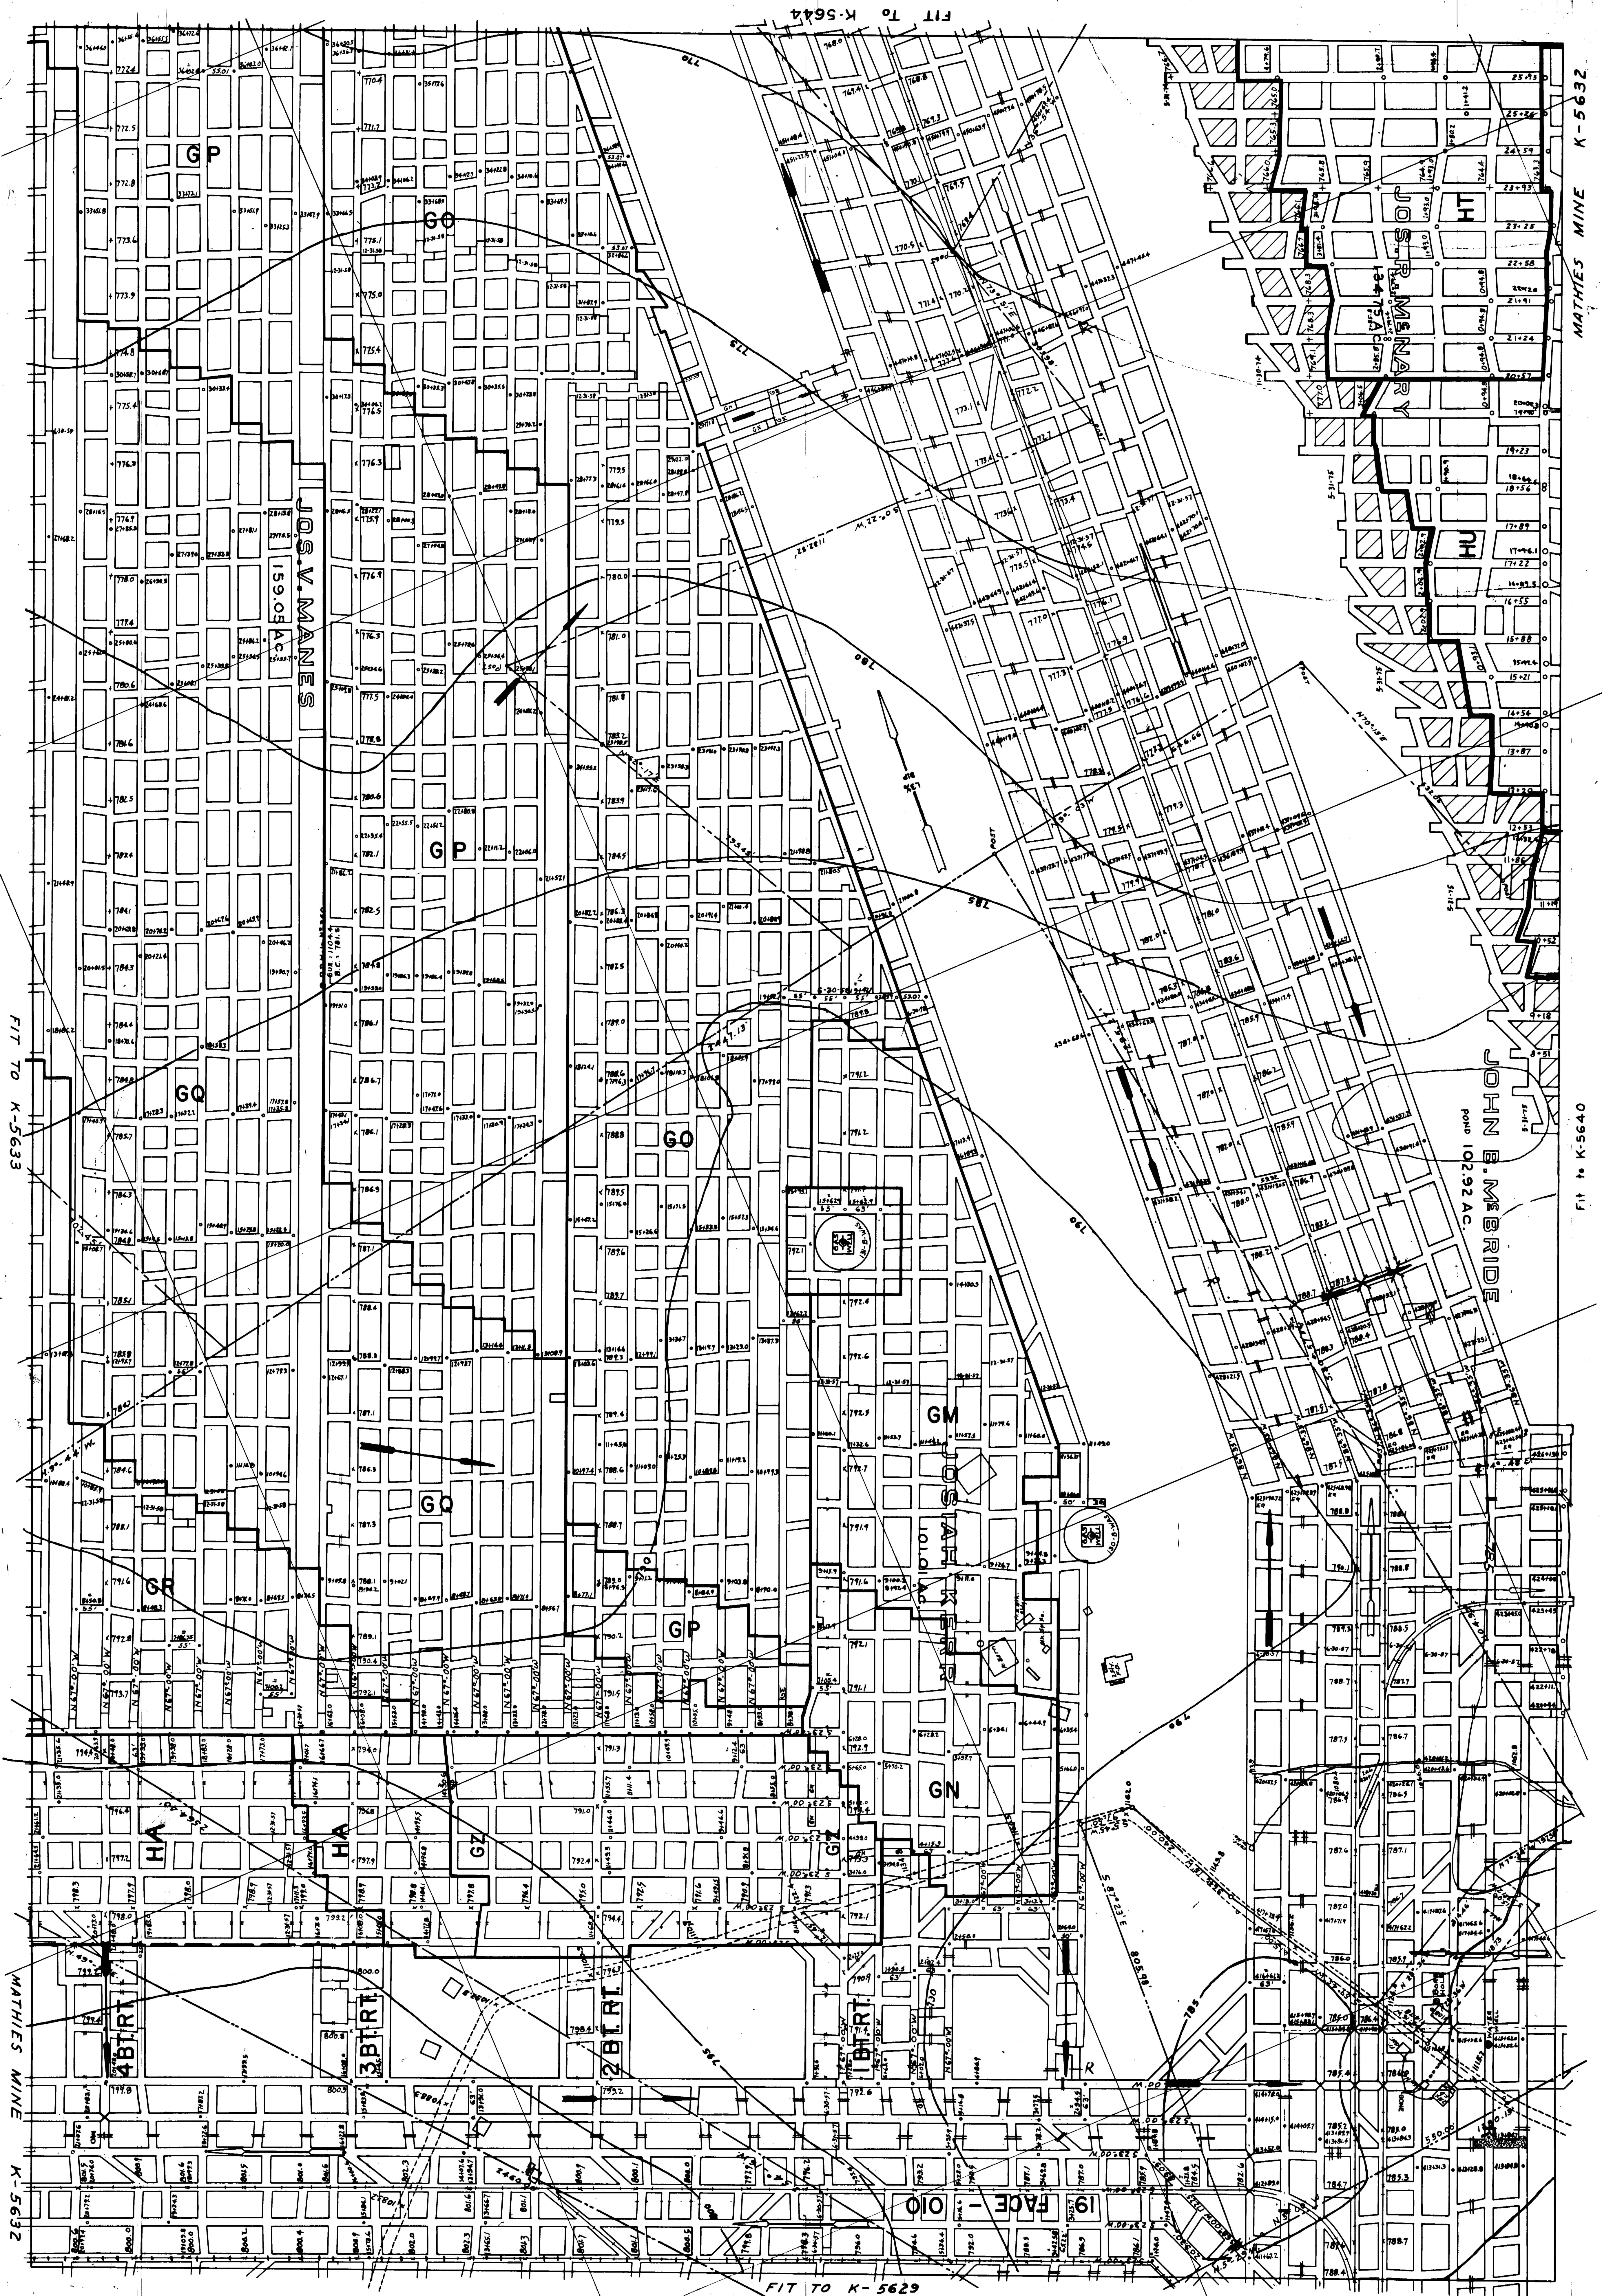

FIT TO K-5633

MATHIES MINE K-5632

FIT TO K-5629

FIT TO K-5640

MATHIES MINE K-5632