


FIT T. K-5647

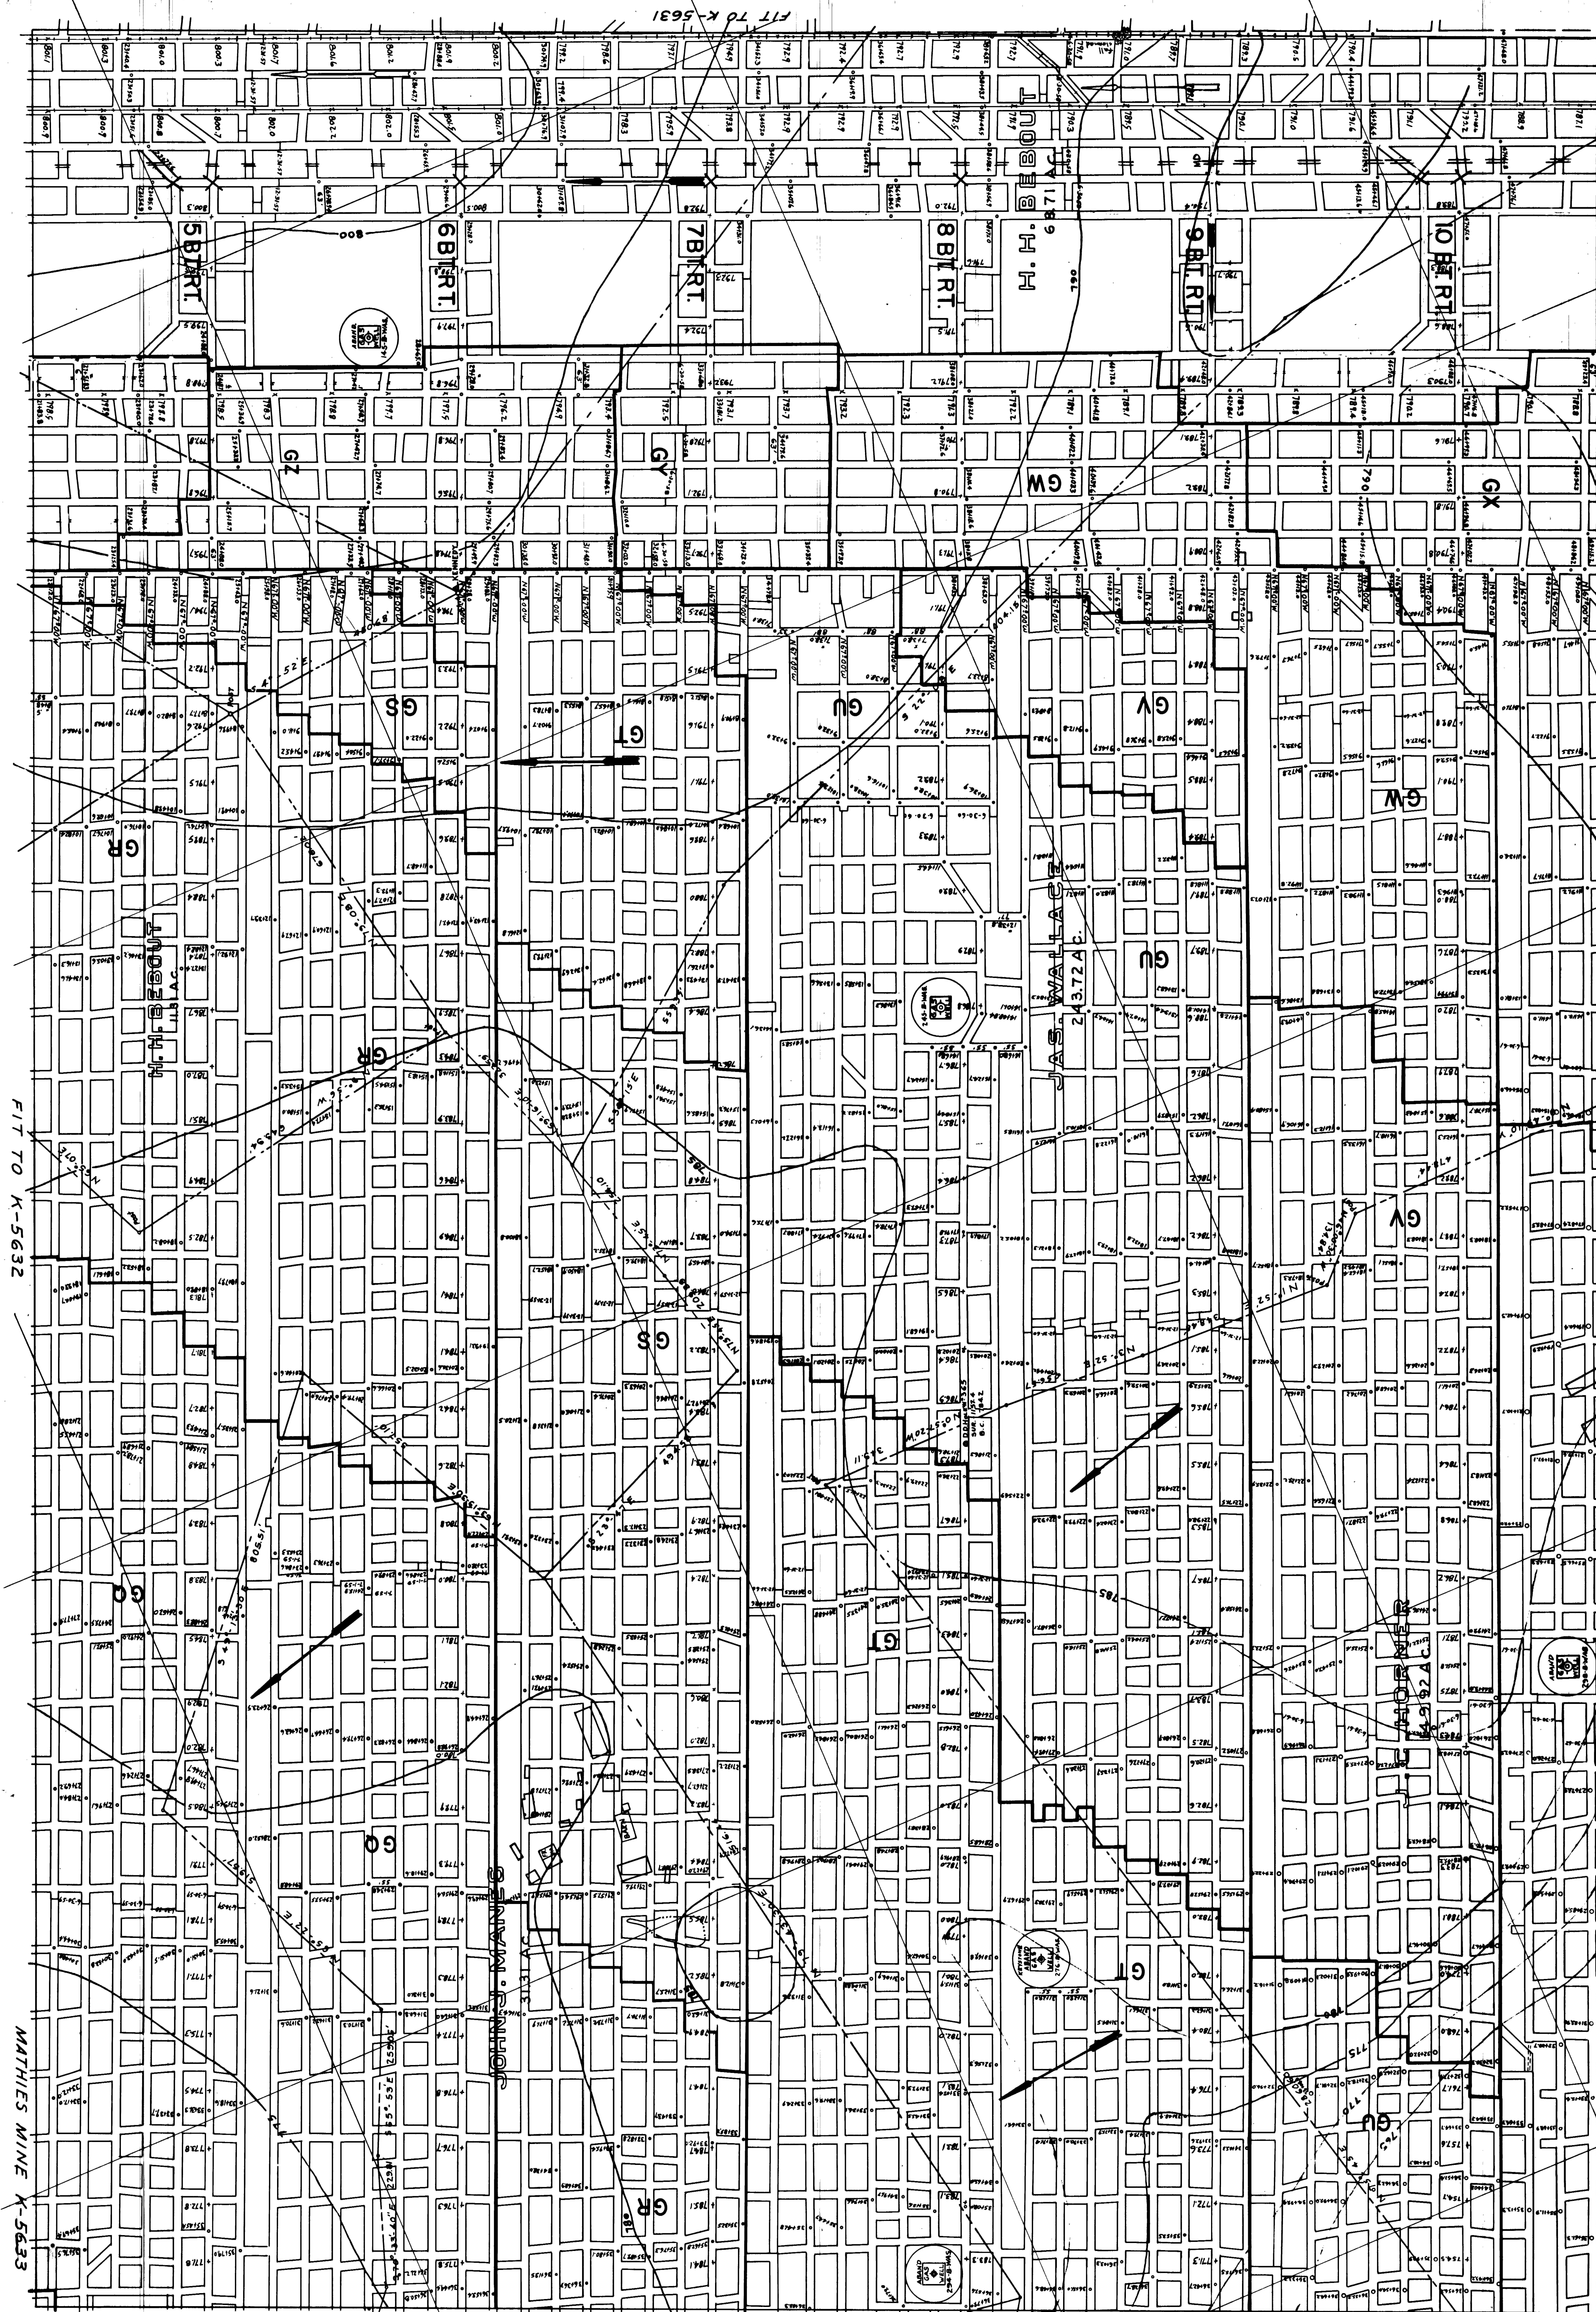

Fit to K-5643