


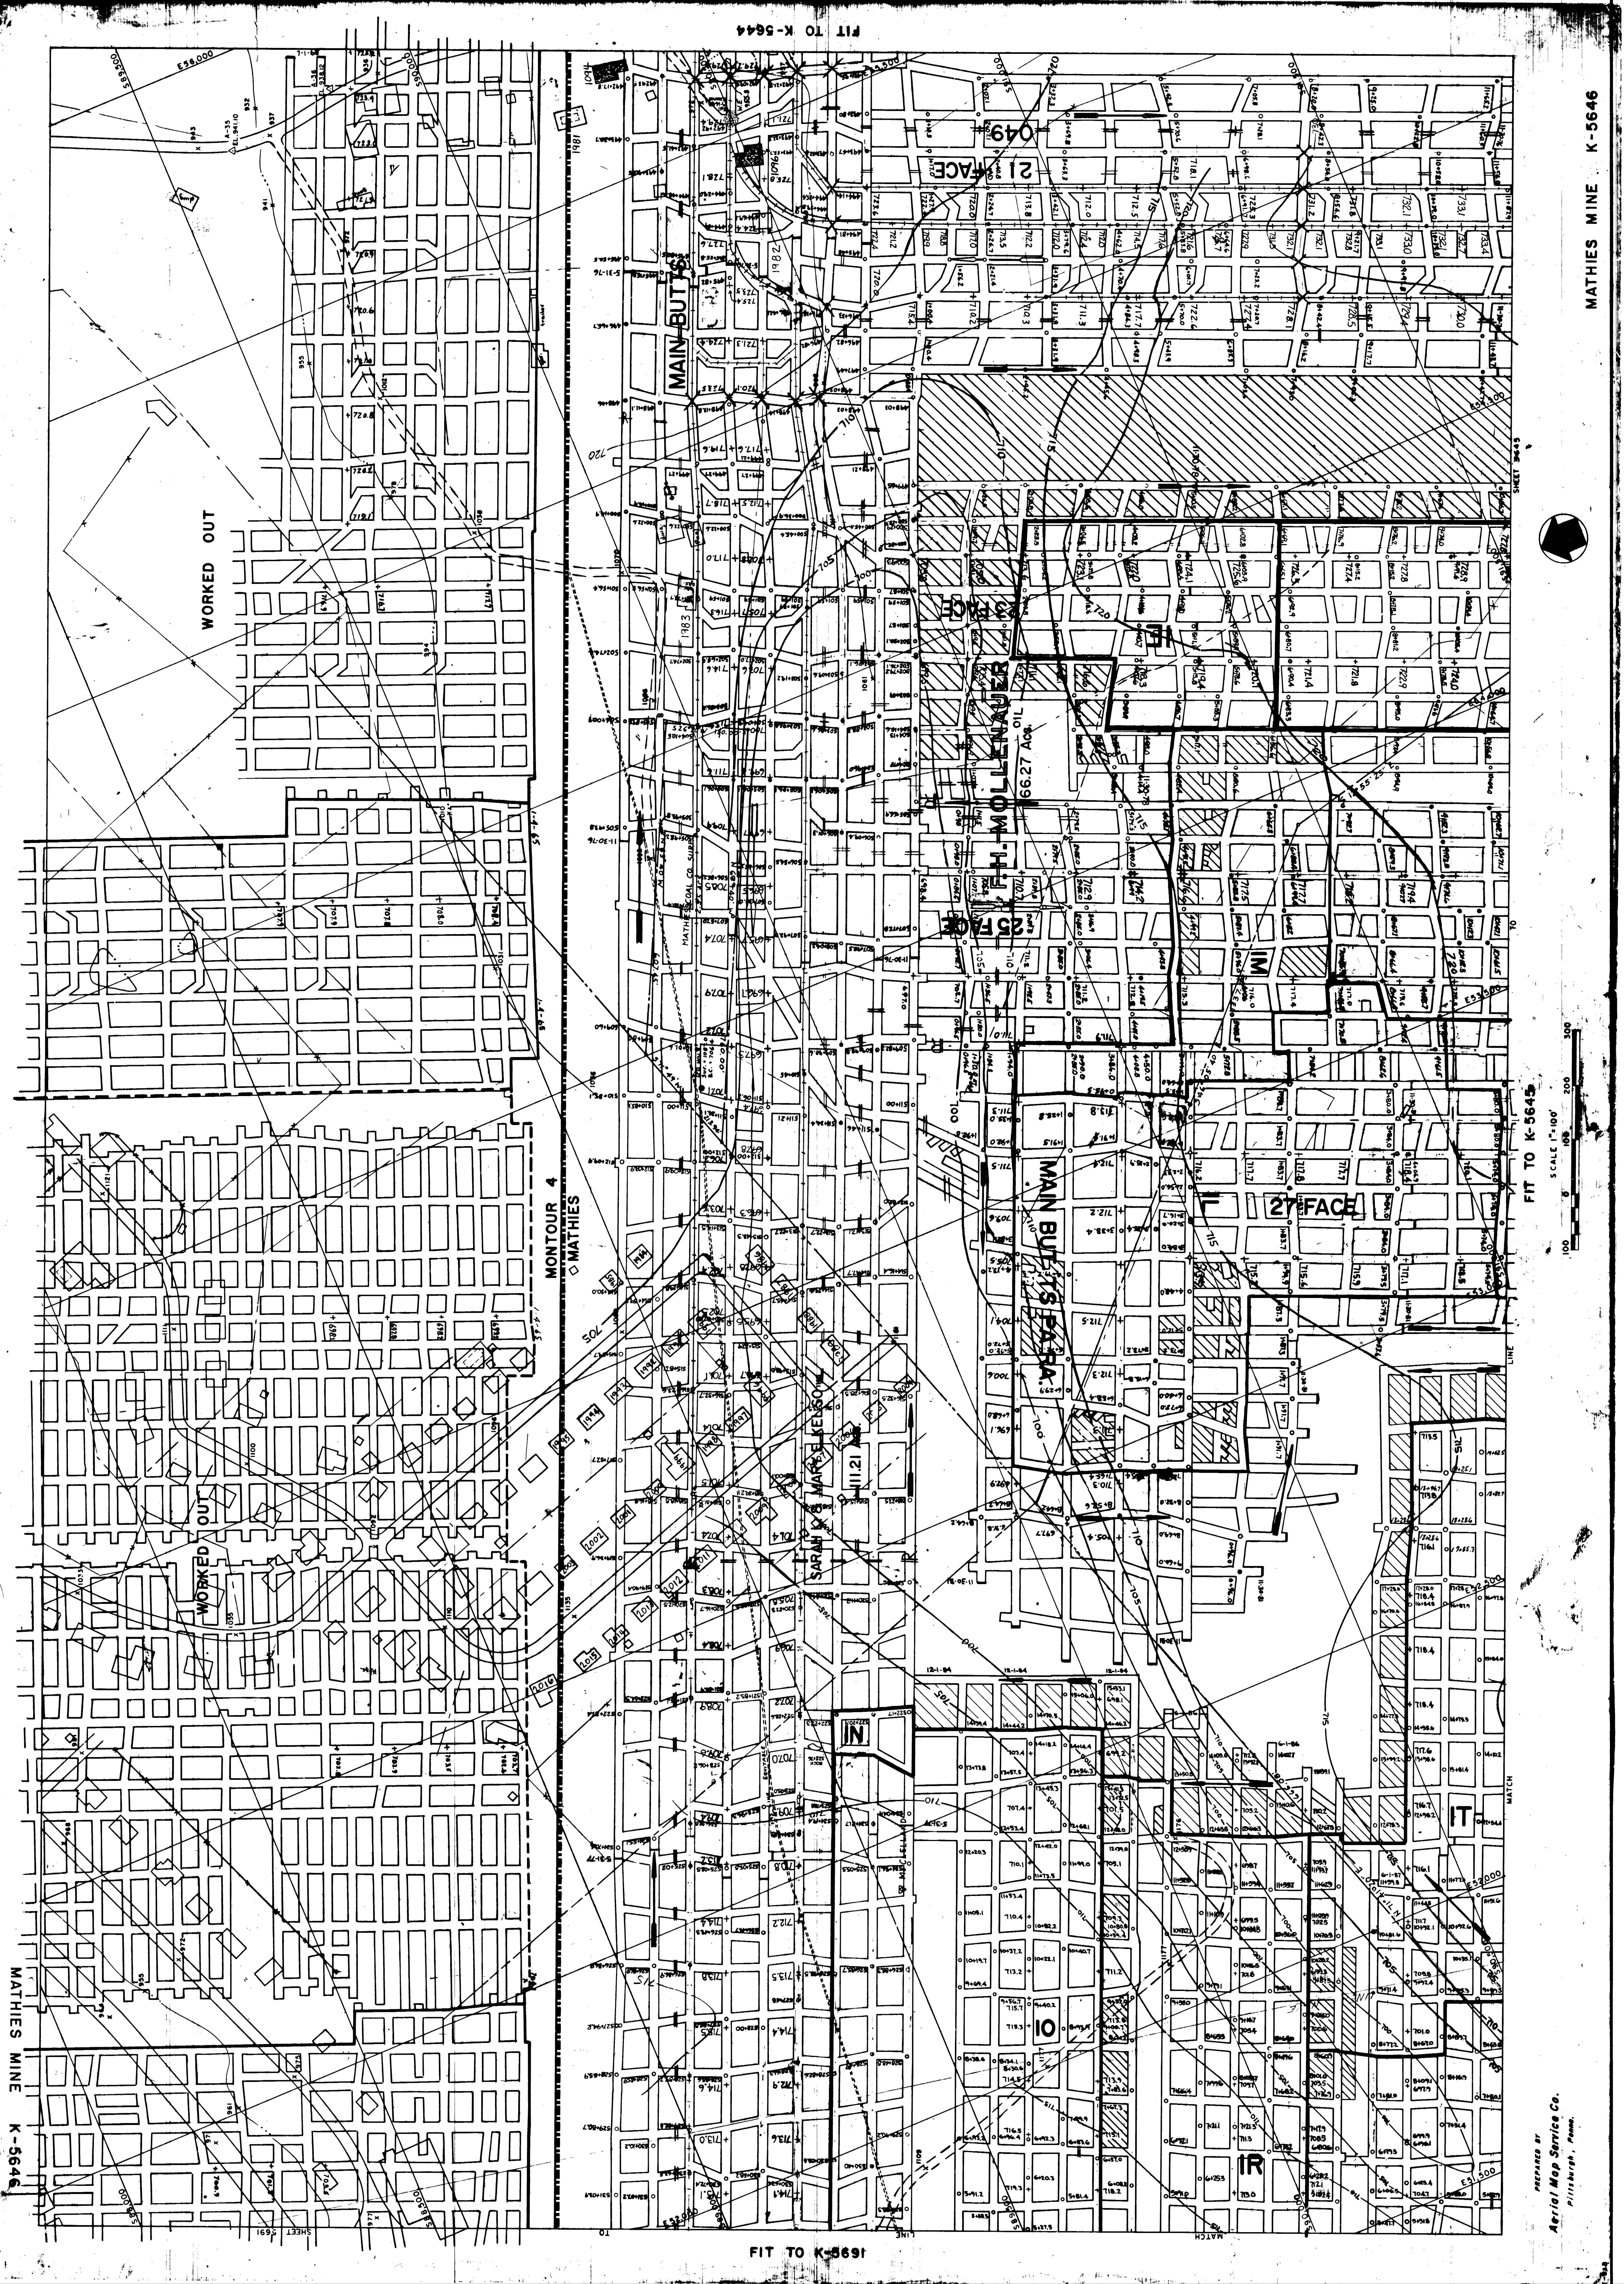

WORKED OUT

MATHIES

MAIN BUTTS

66.27 Acs

MAIN BUTTS


21st FACE

FIT TO K-5645

SCALE 1"=100'
0 100 200 300

PREPARED BY
Aerial Map Service Co.
Pittsburgh, Penn.

MATHIES MINE K-5646

FIT TO K-5691