


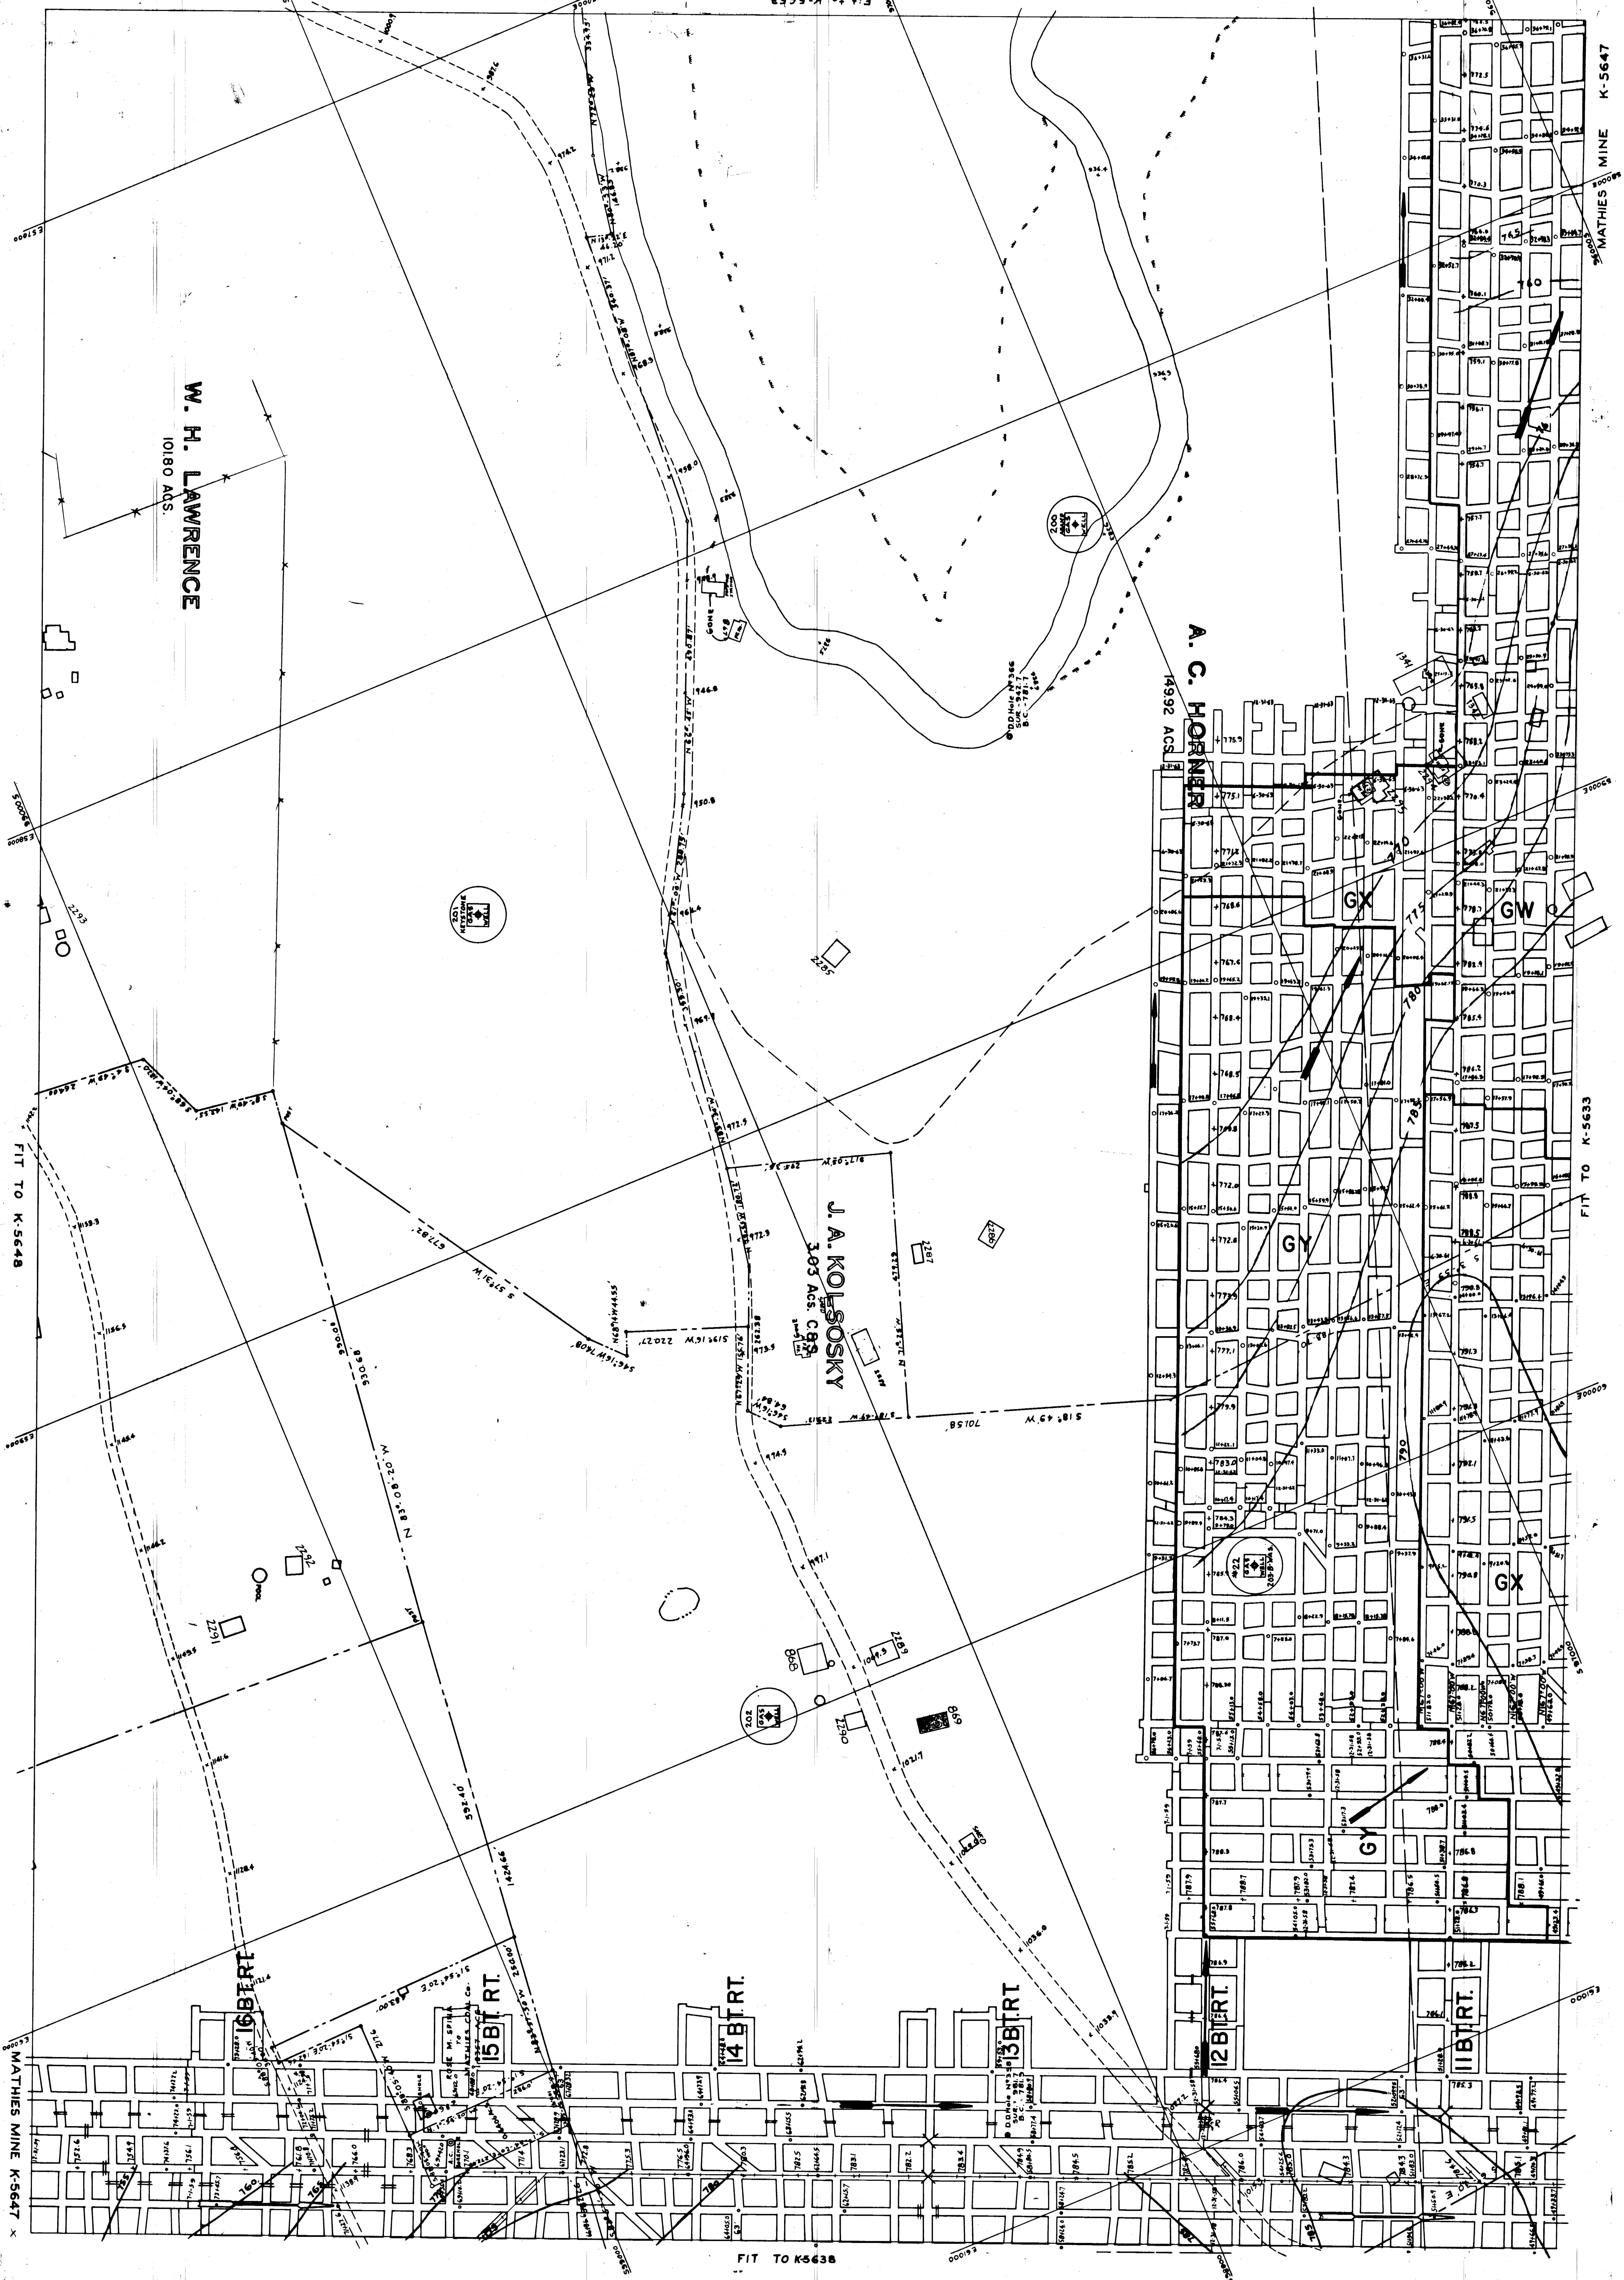

W. H. LAWRENCE
10180 ACS.

J. A. KOLSKY
303 ACS. C88

A. C. HORNBER
14992 ACS.

