


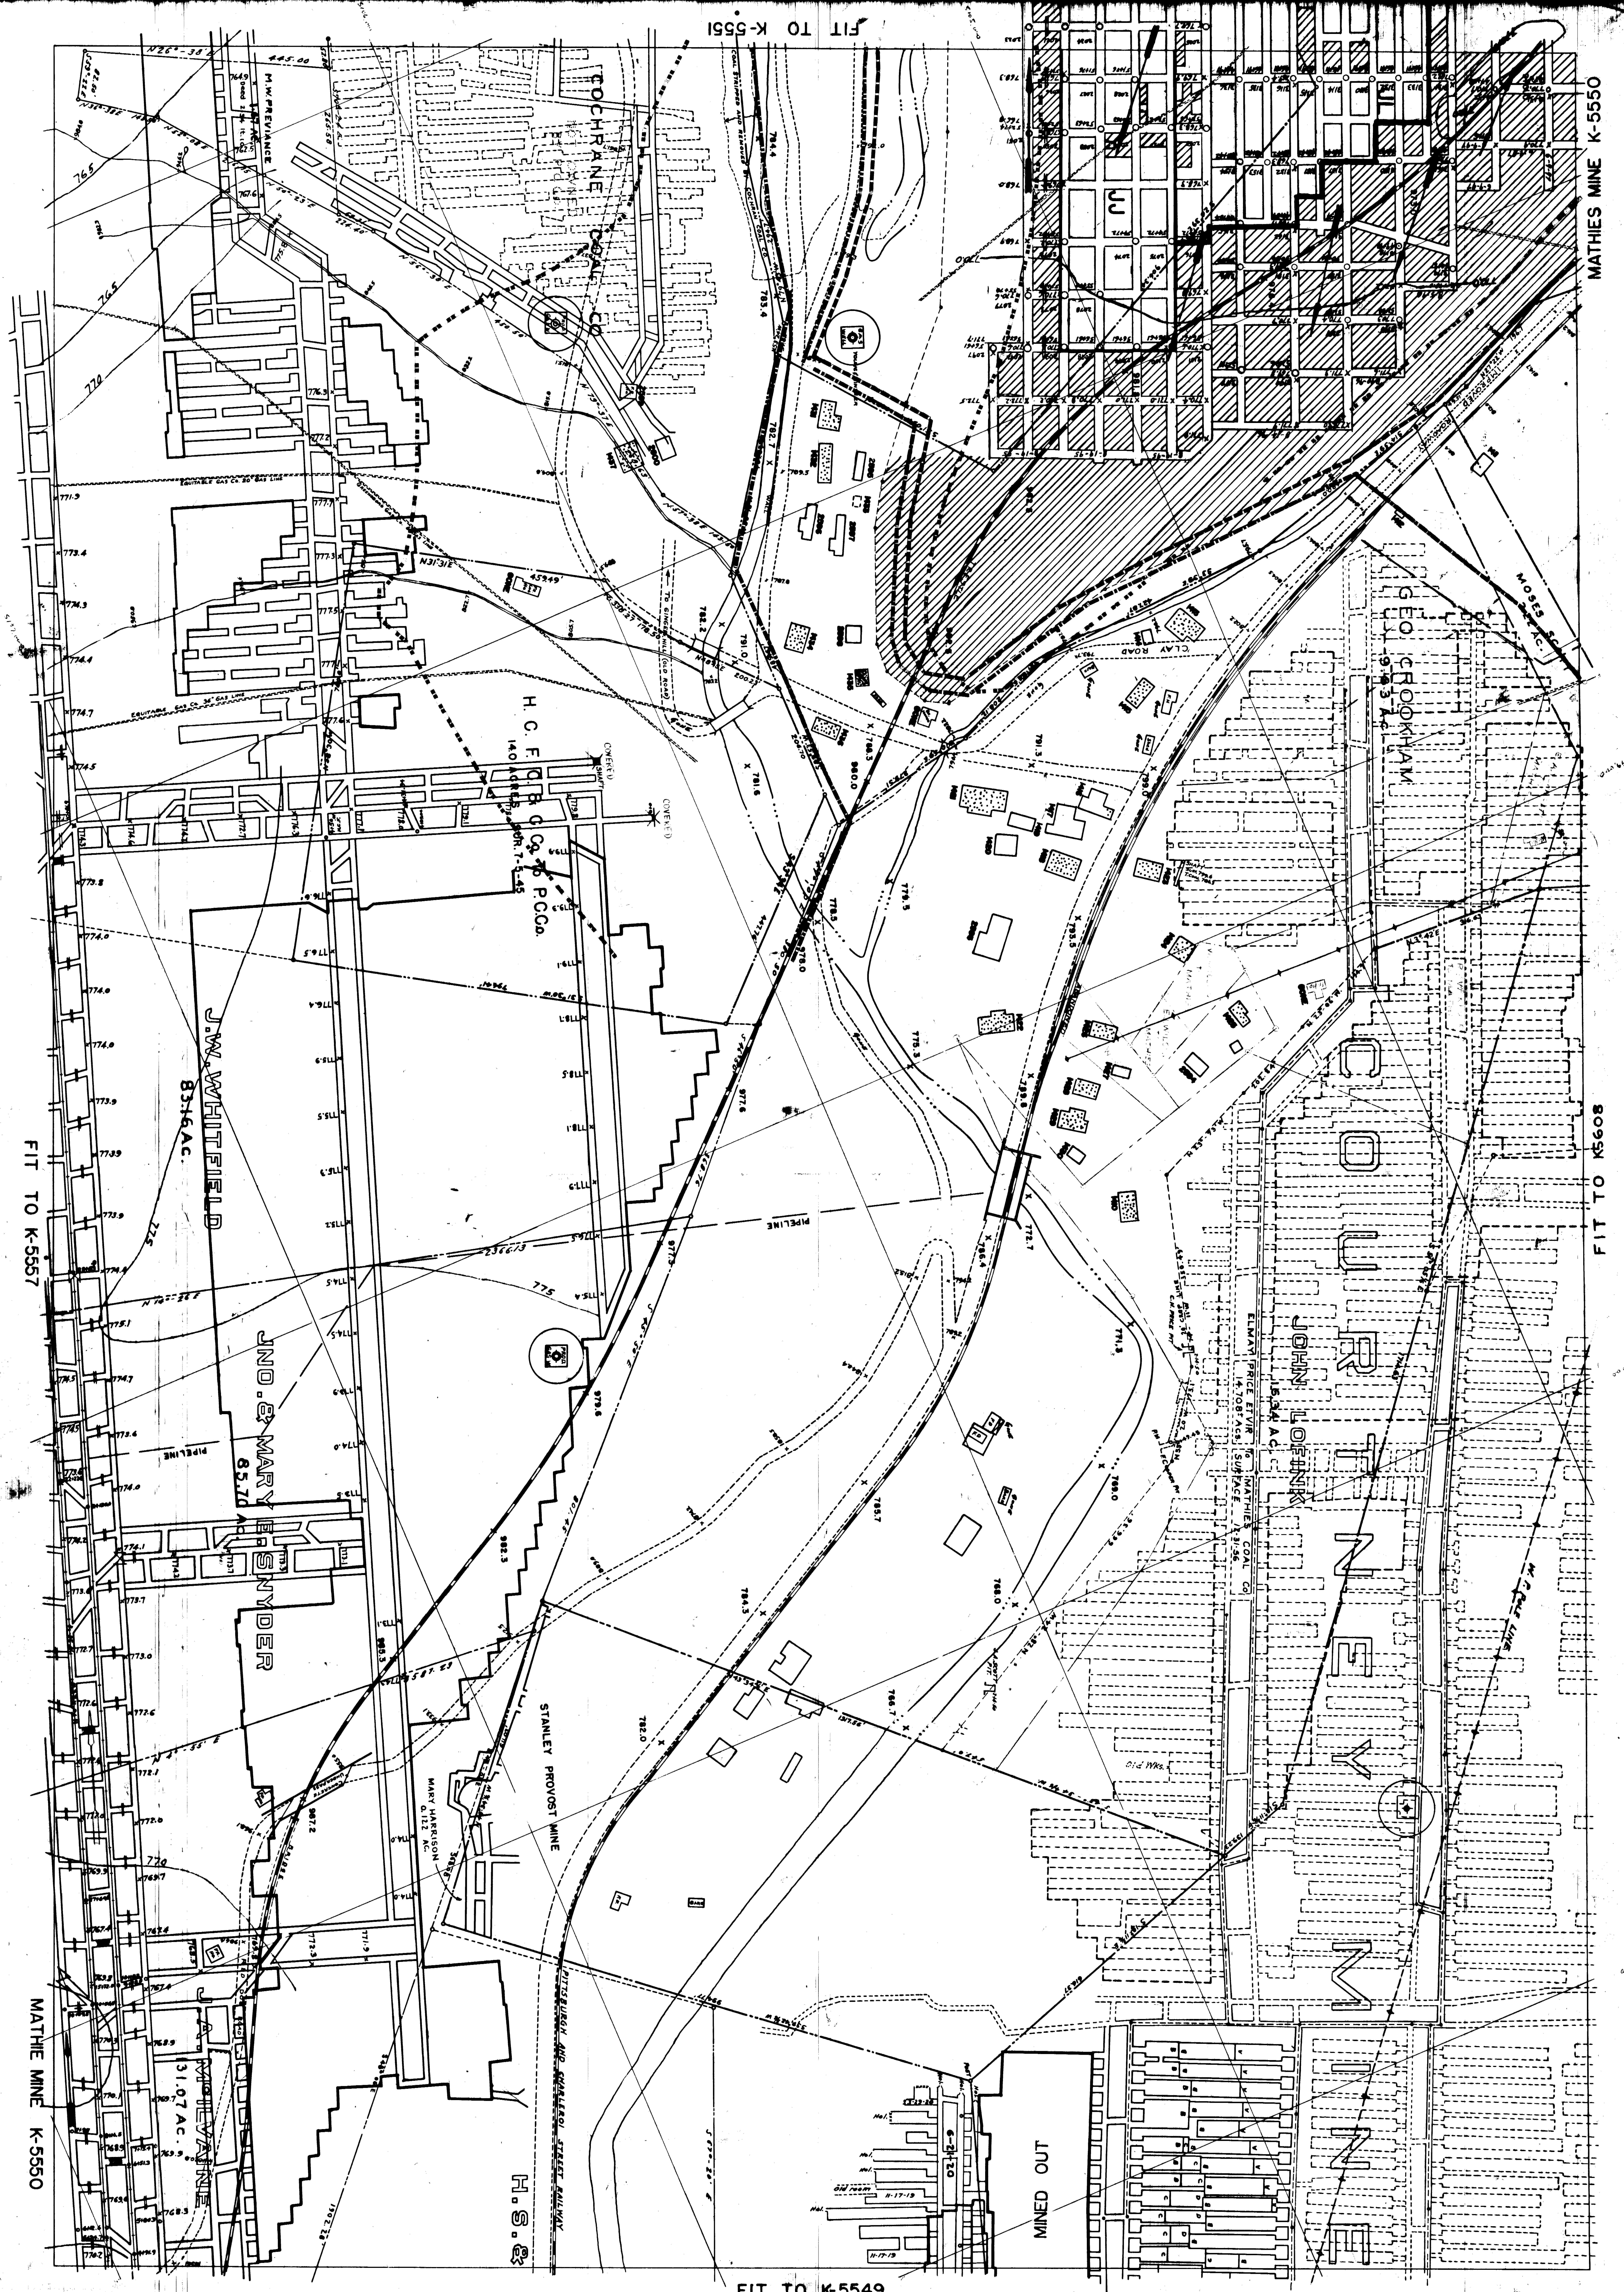

FIT TO K-5557

MATHIE MINE K-5550

FIT TO K-5549

FIT TO K5608

MATHIES MINE K-5550