


FIT TO K-5551

K-5558
MATHIES MINE

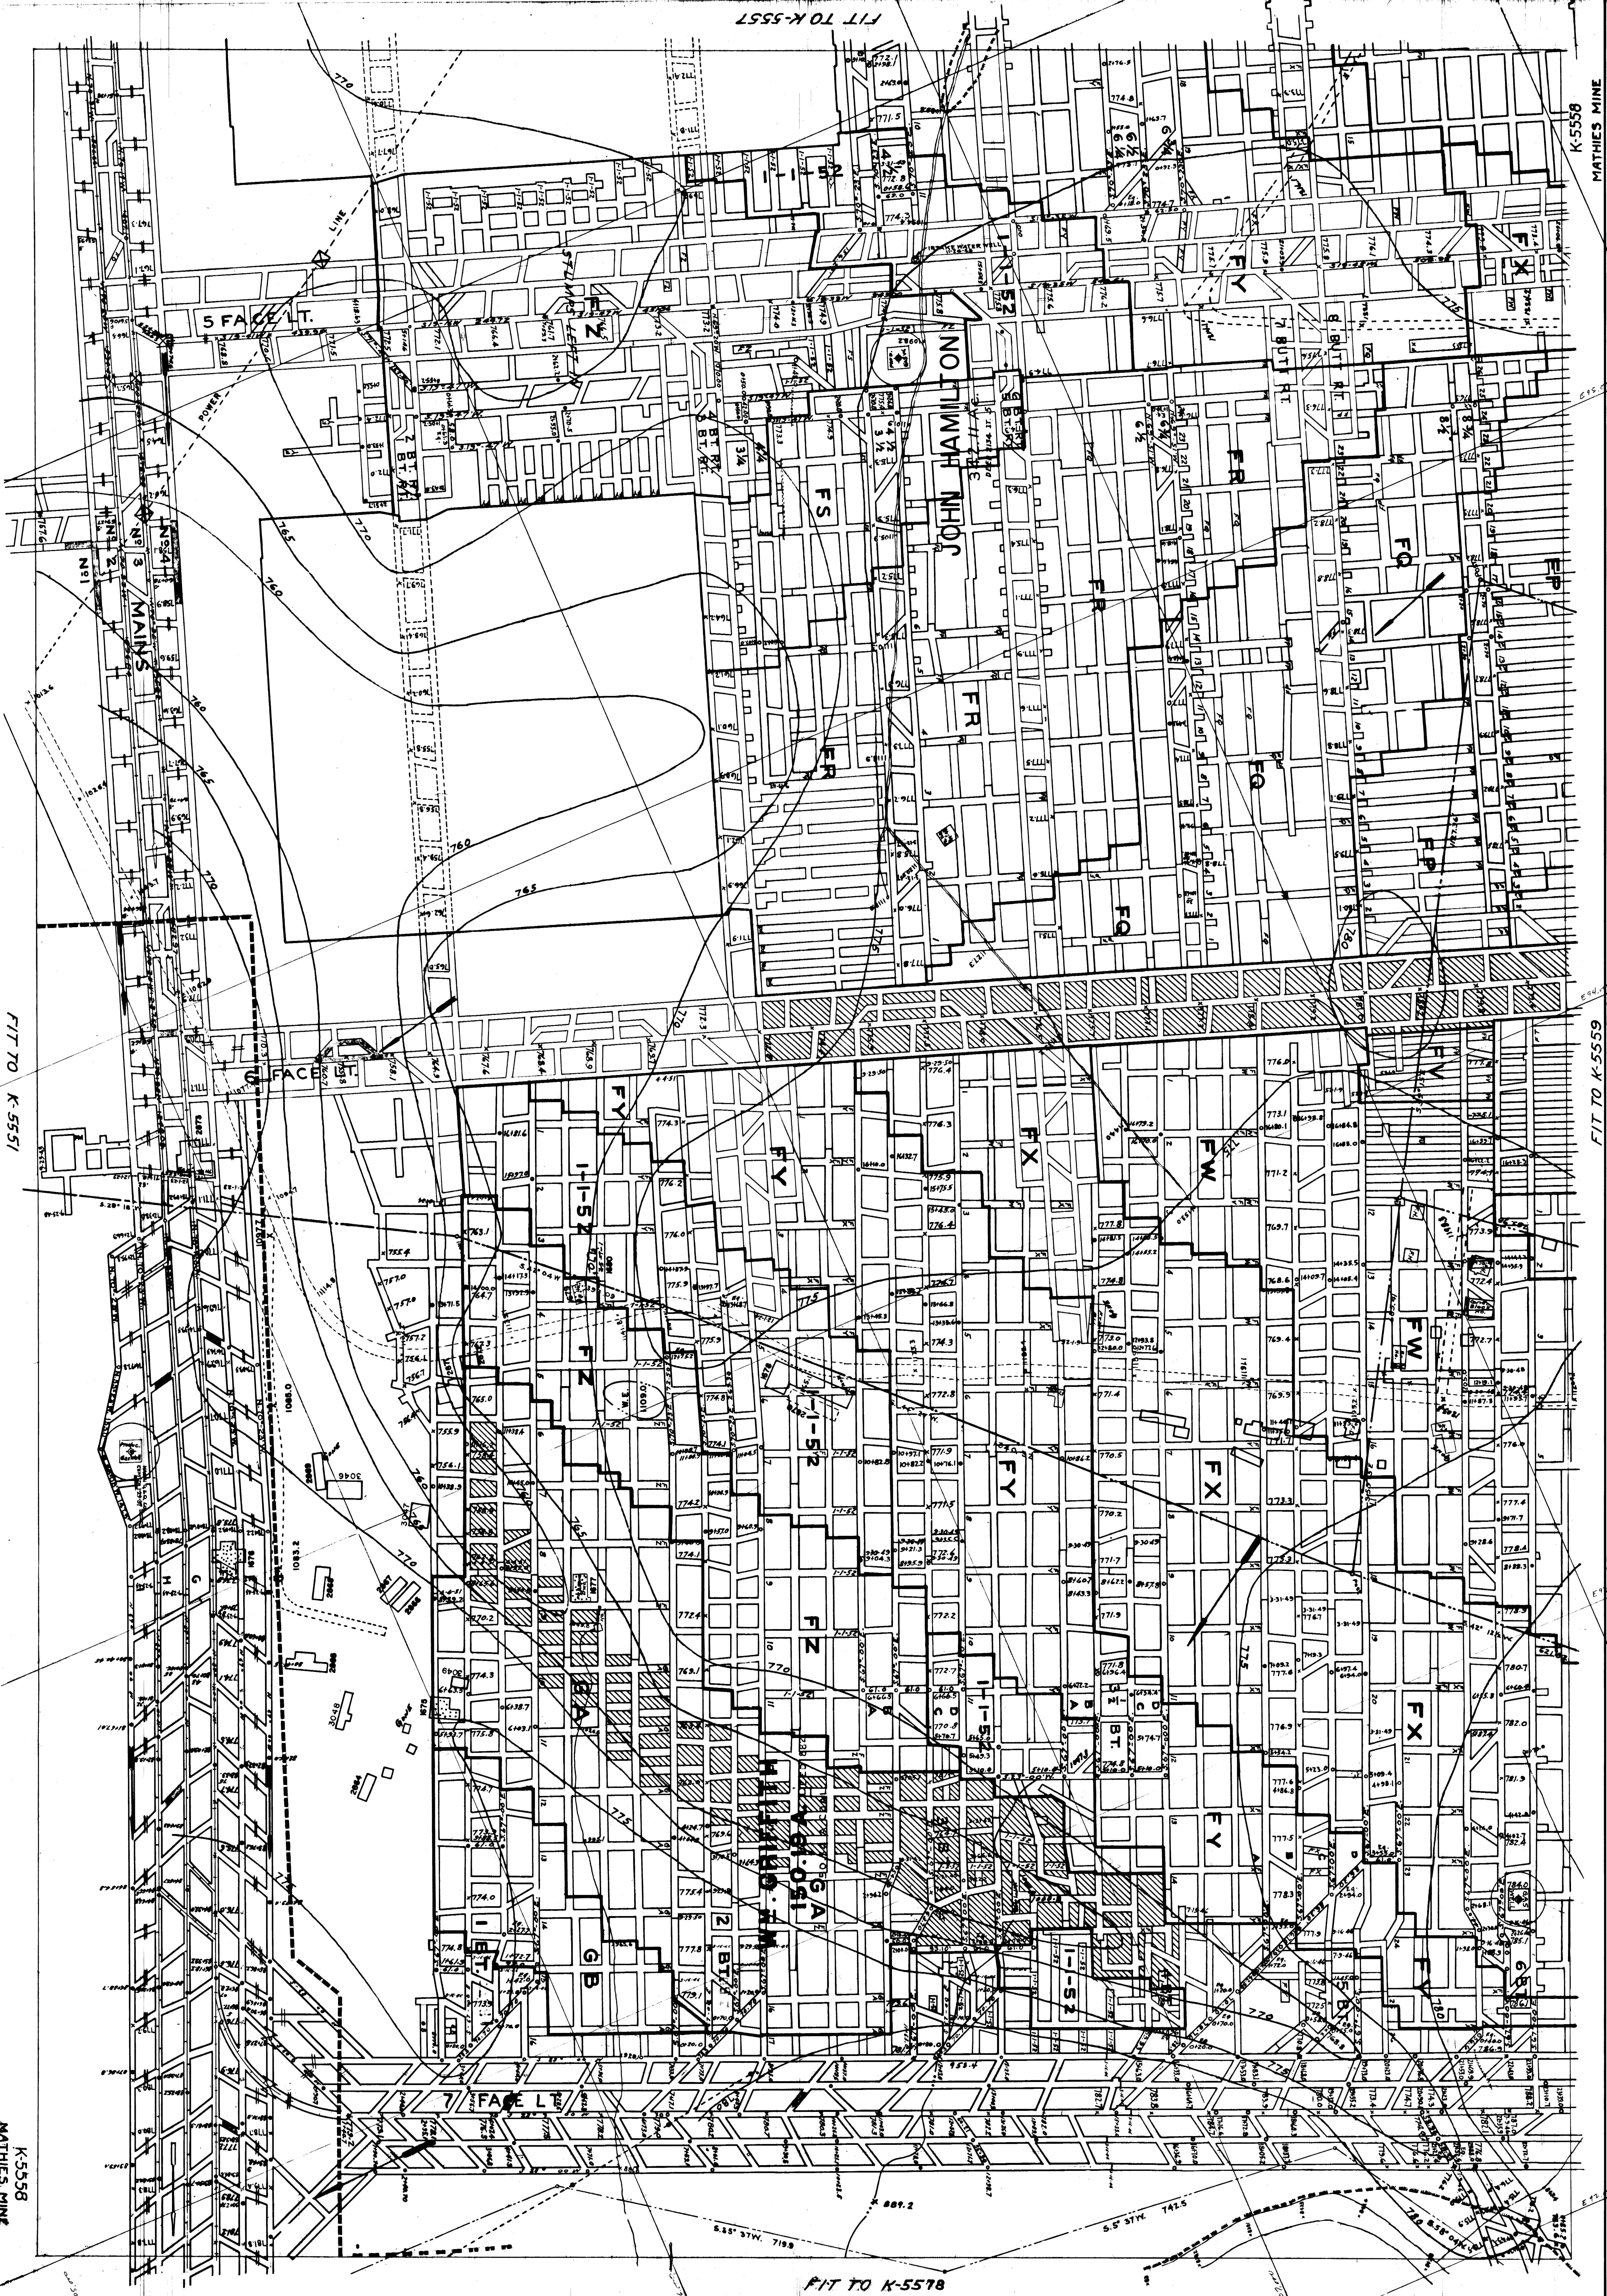

K-5558
MATHIES MINE

FIT TO K-5559

FIT TO K-5578