


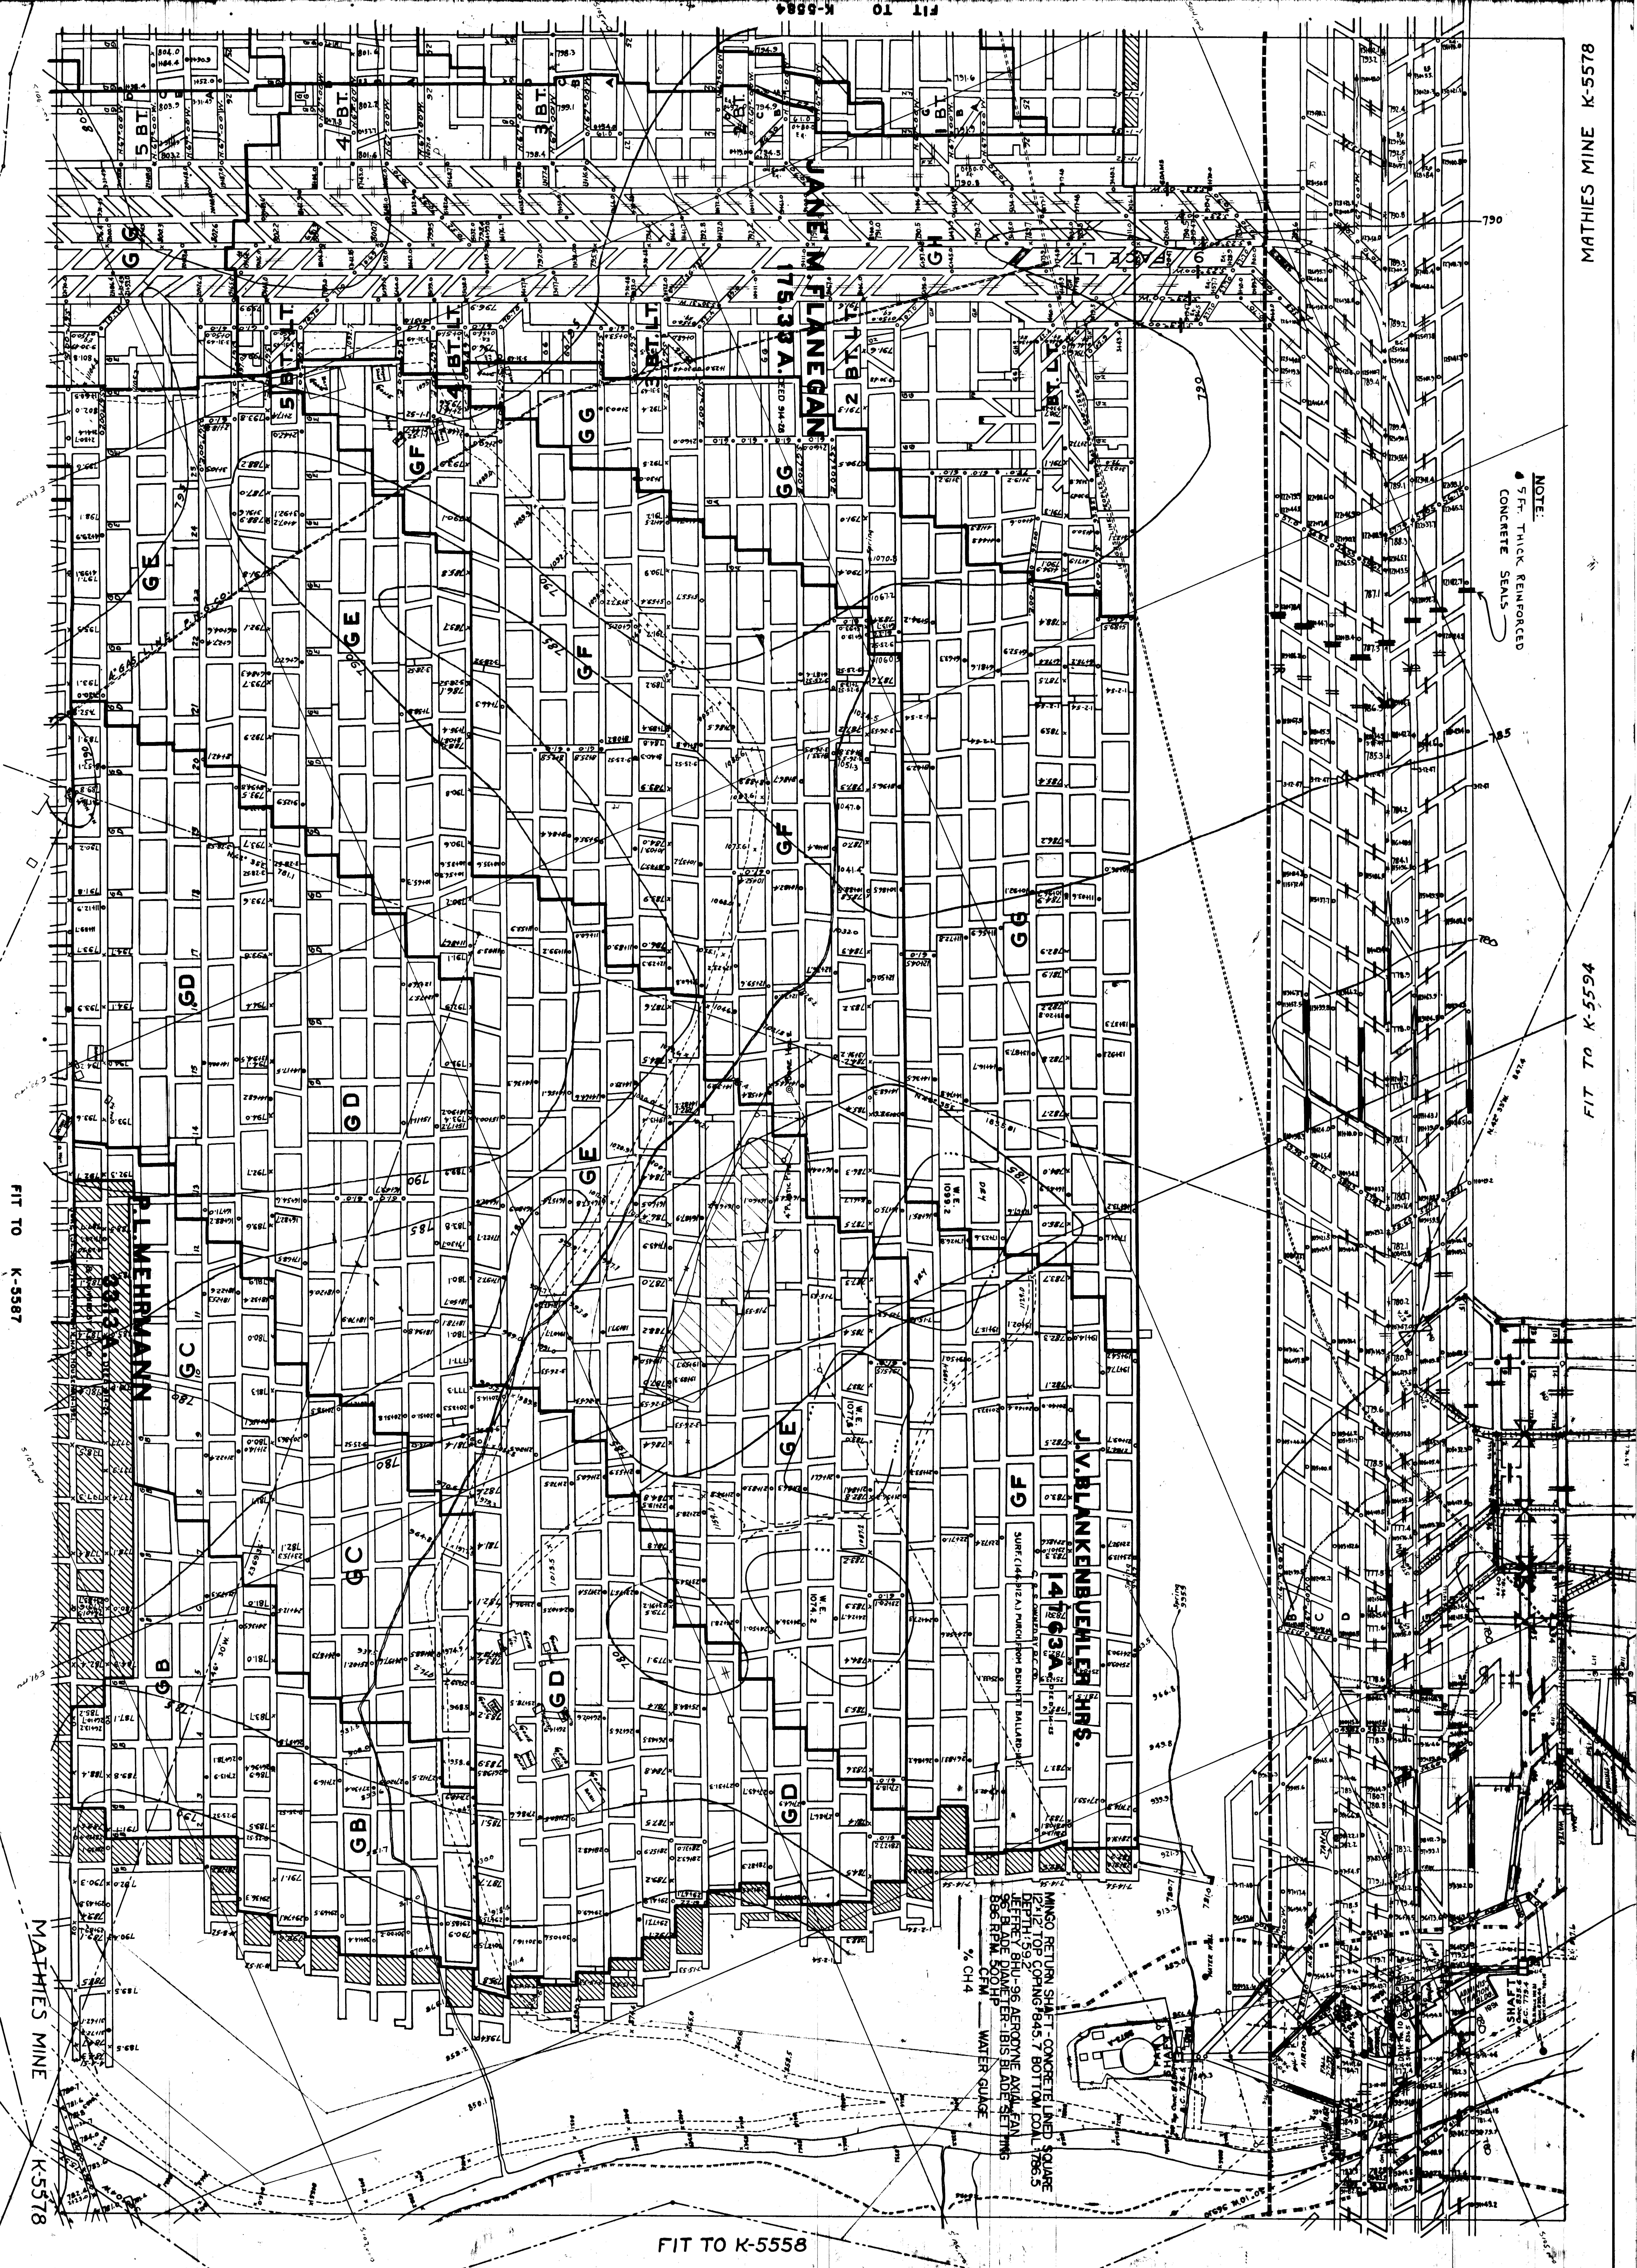

NOTE:
5 FT. THICK REINFORCED
CONCRETE SEALS

MINING RE-URN SHAFT - CONCRETE LINED \$
12" x 12" TOP COPING 1845.7 BOTTOM COAL 17
DEPTH: 59.2
JEFFREY 8H-96 AEROBYNE AXIAL FAN
96" BLADE DIAMETER-1BIS BLADE SET TIME
886 RPM, 500 HP
CFM _____ WATER GUAGE
% CH 4 _____

FIT TO K-5558

FIT TO K-5587

~~MATHIES MINE~~ K-5578