


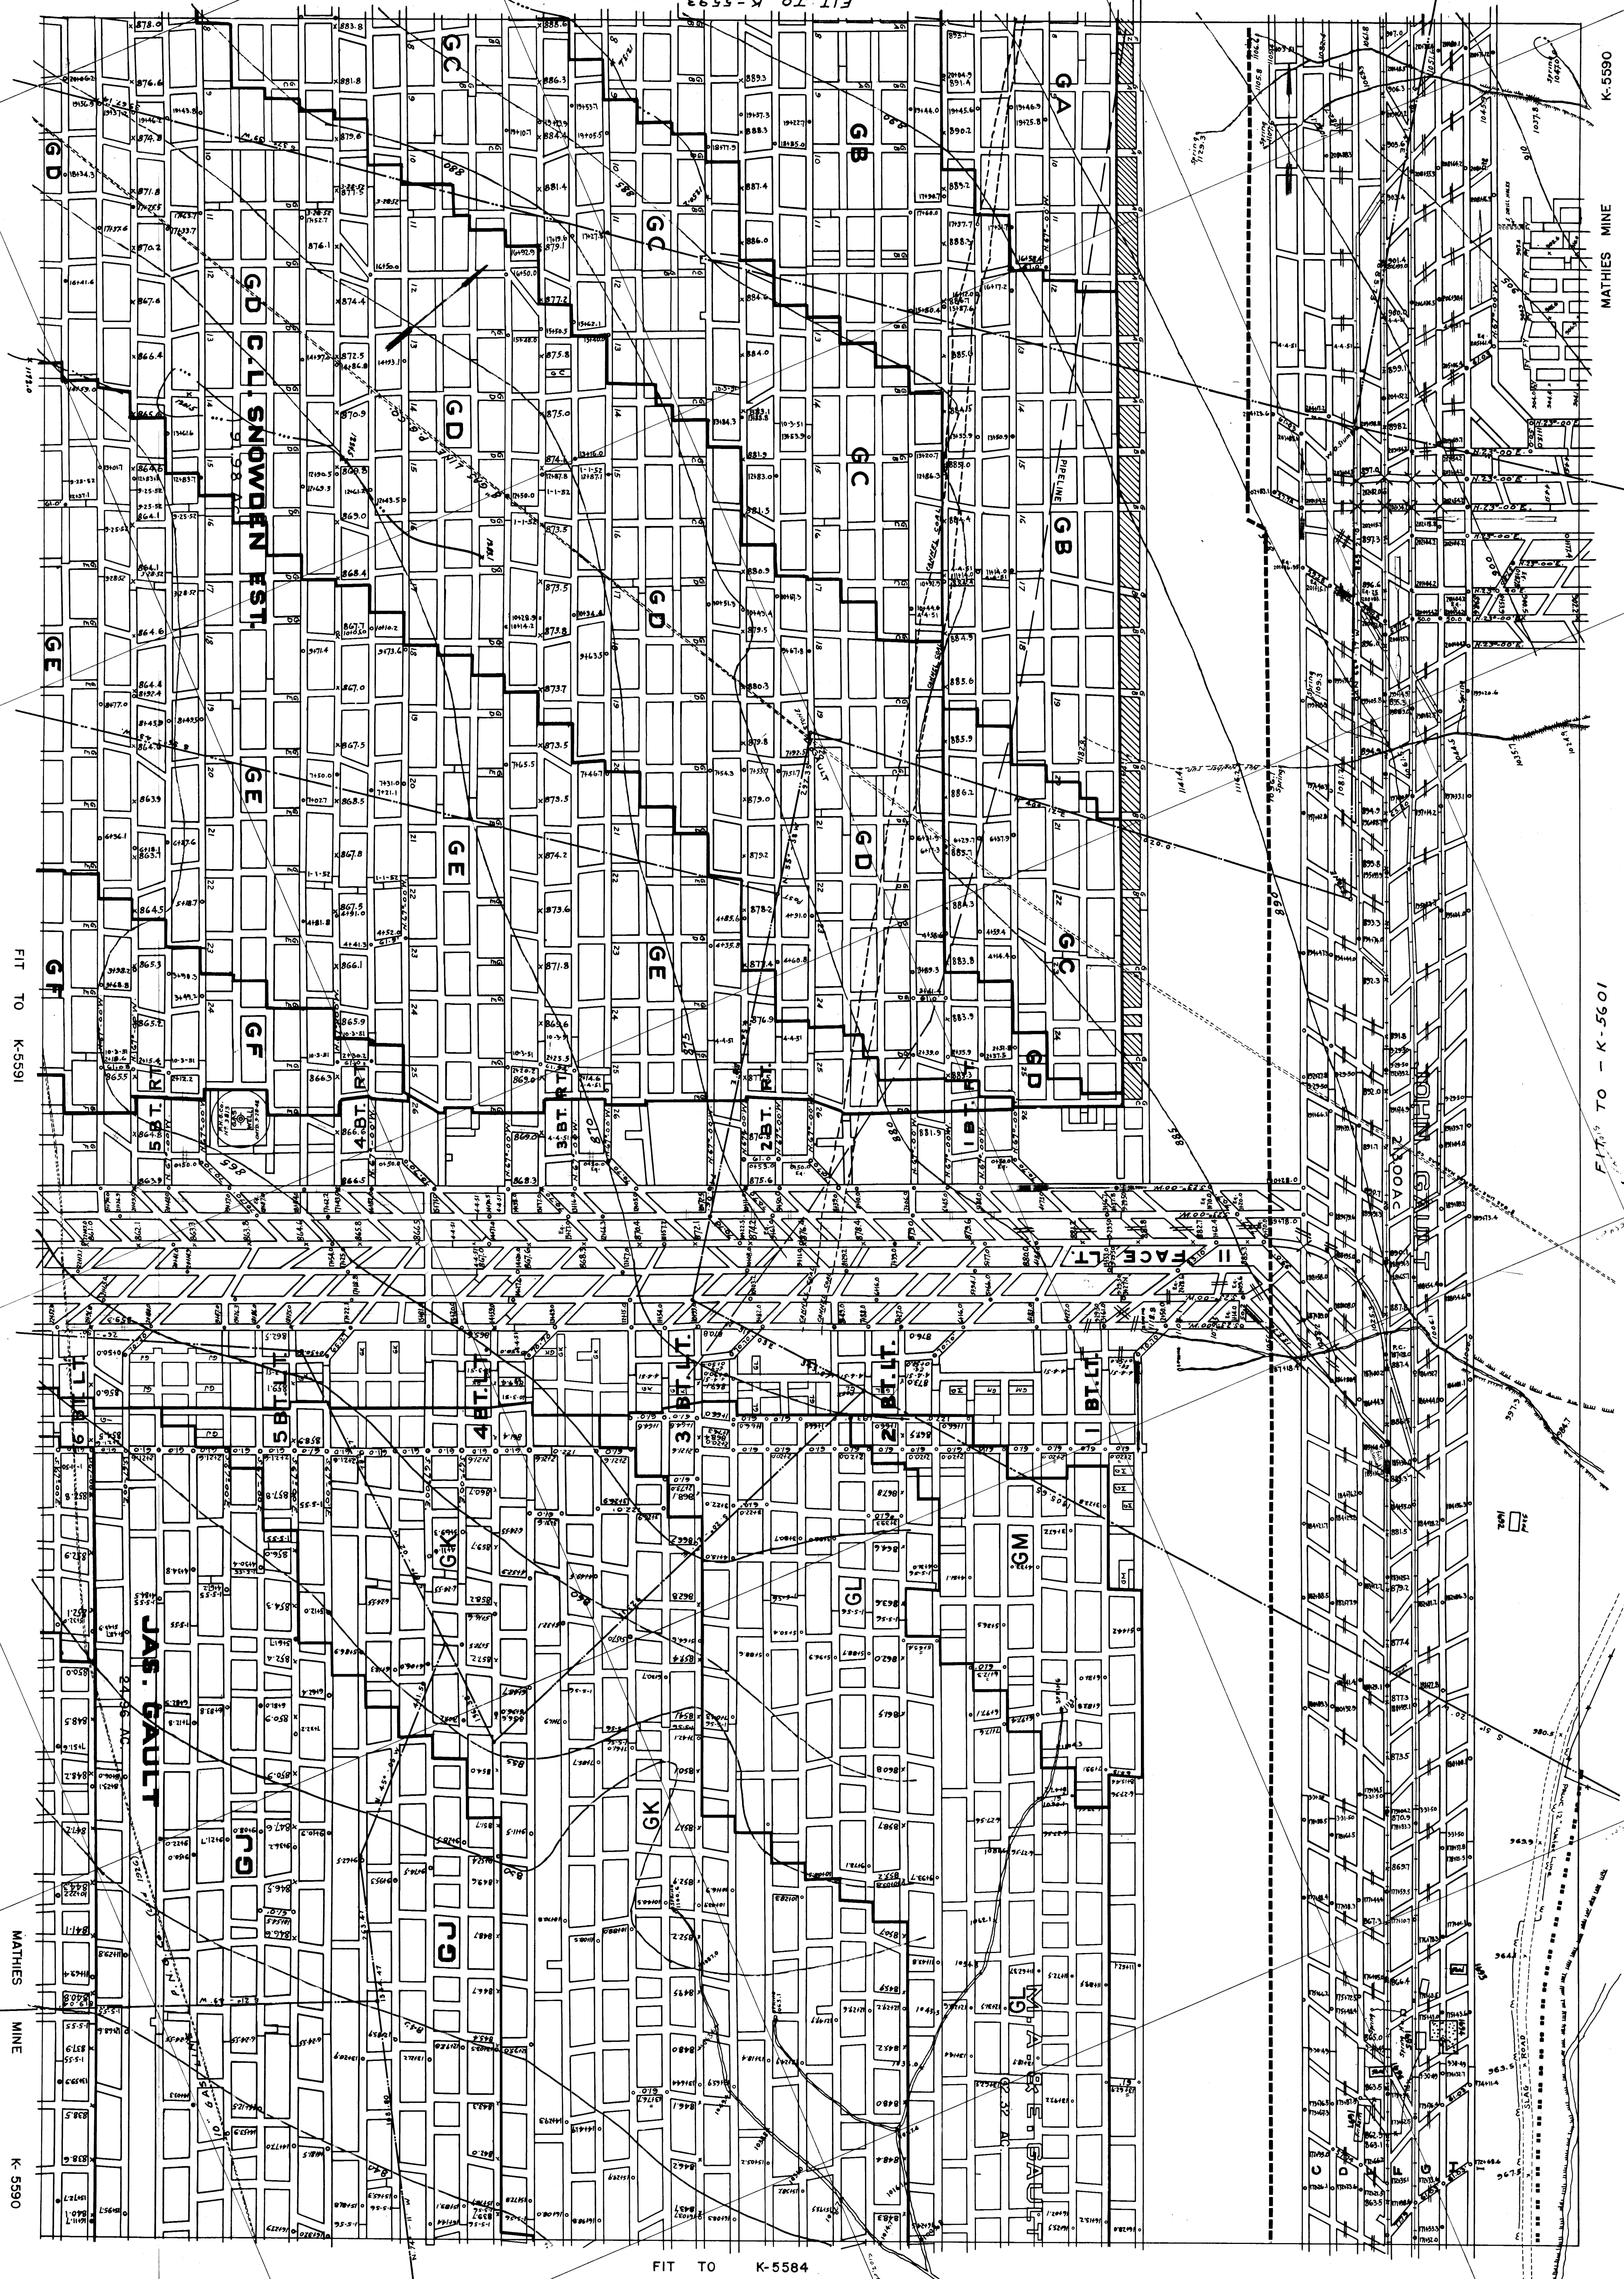

MATHIES MINE

FIT TO - K-5601

K-5590

FIT TO K-5584