


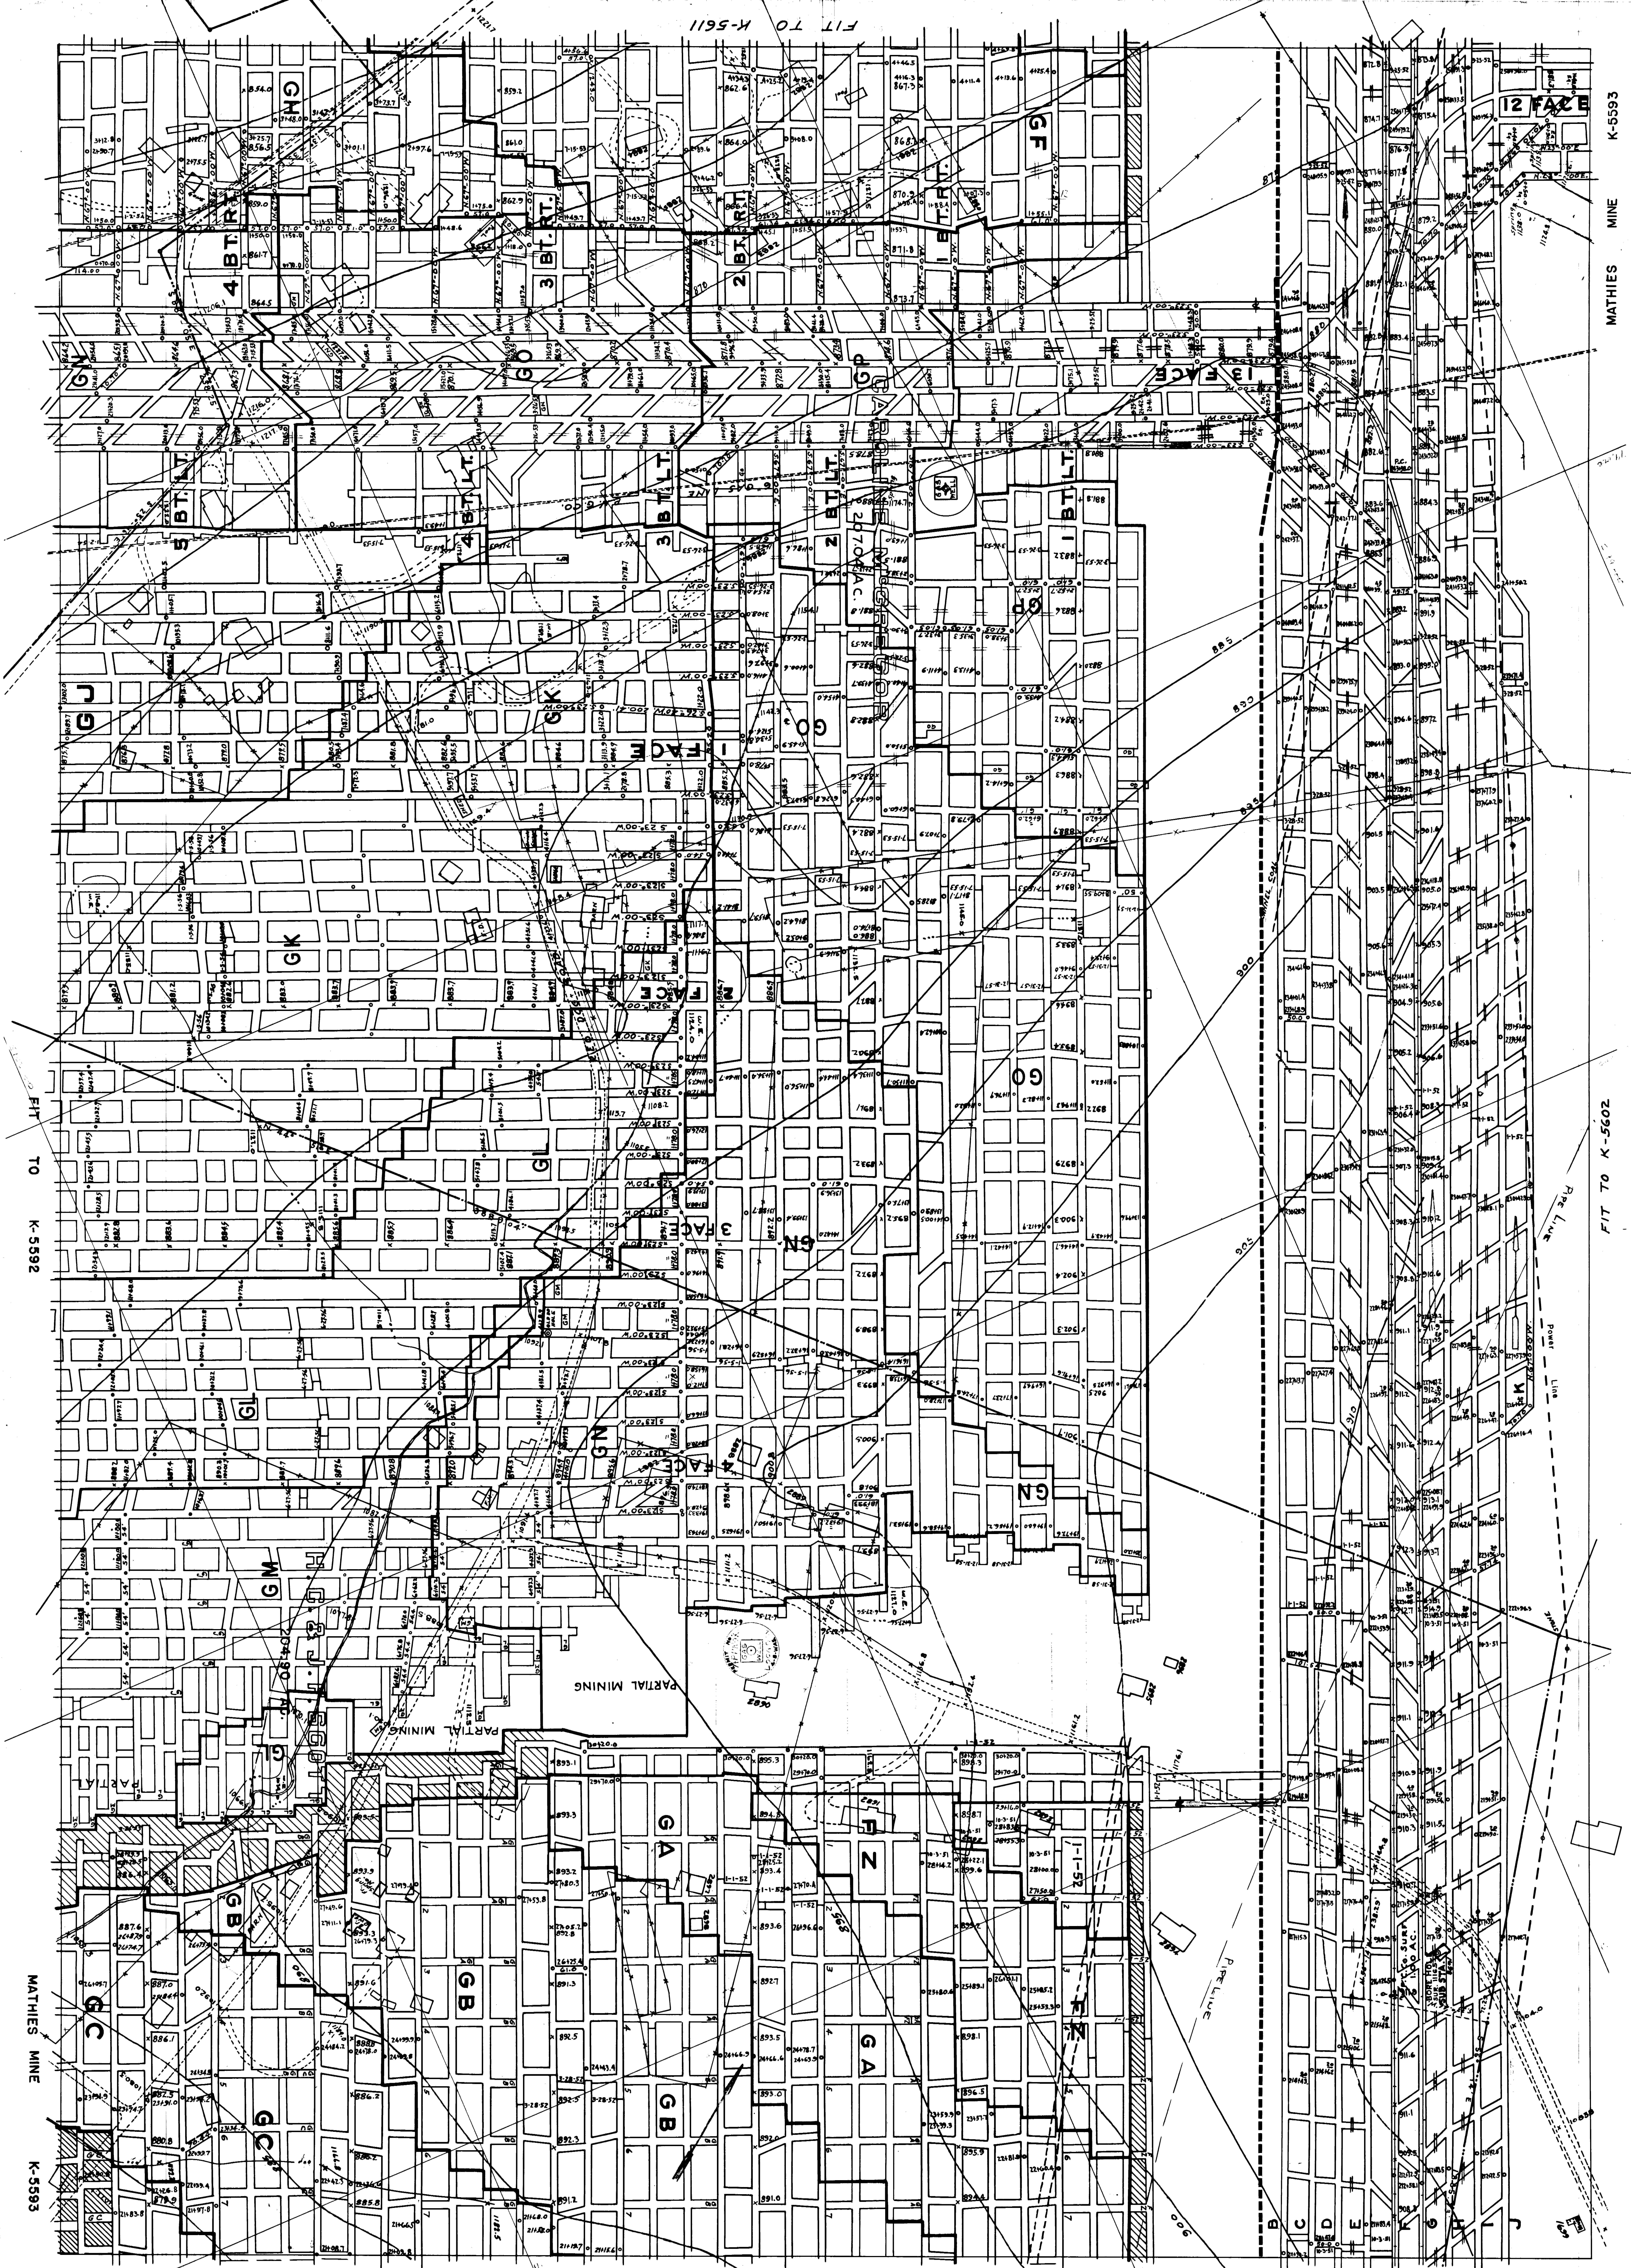

MATHIES	MINE	K-5593
---------	------	--------

FIT TO K-5602

