


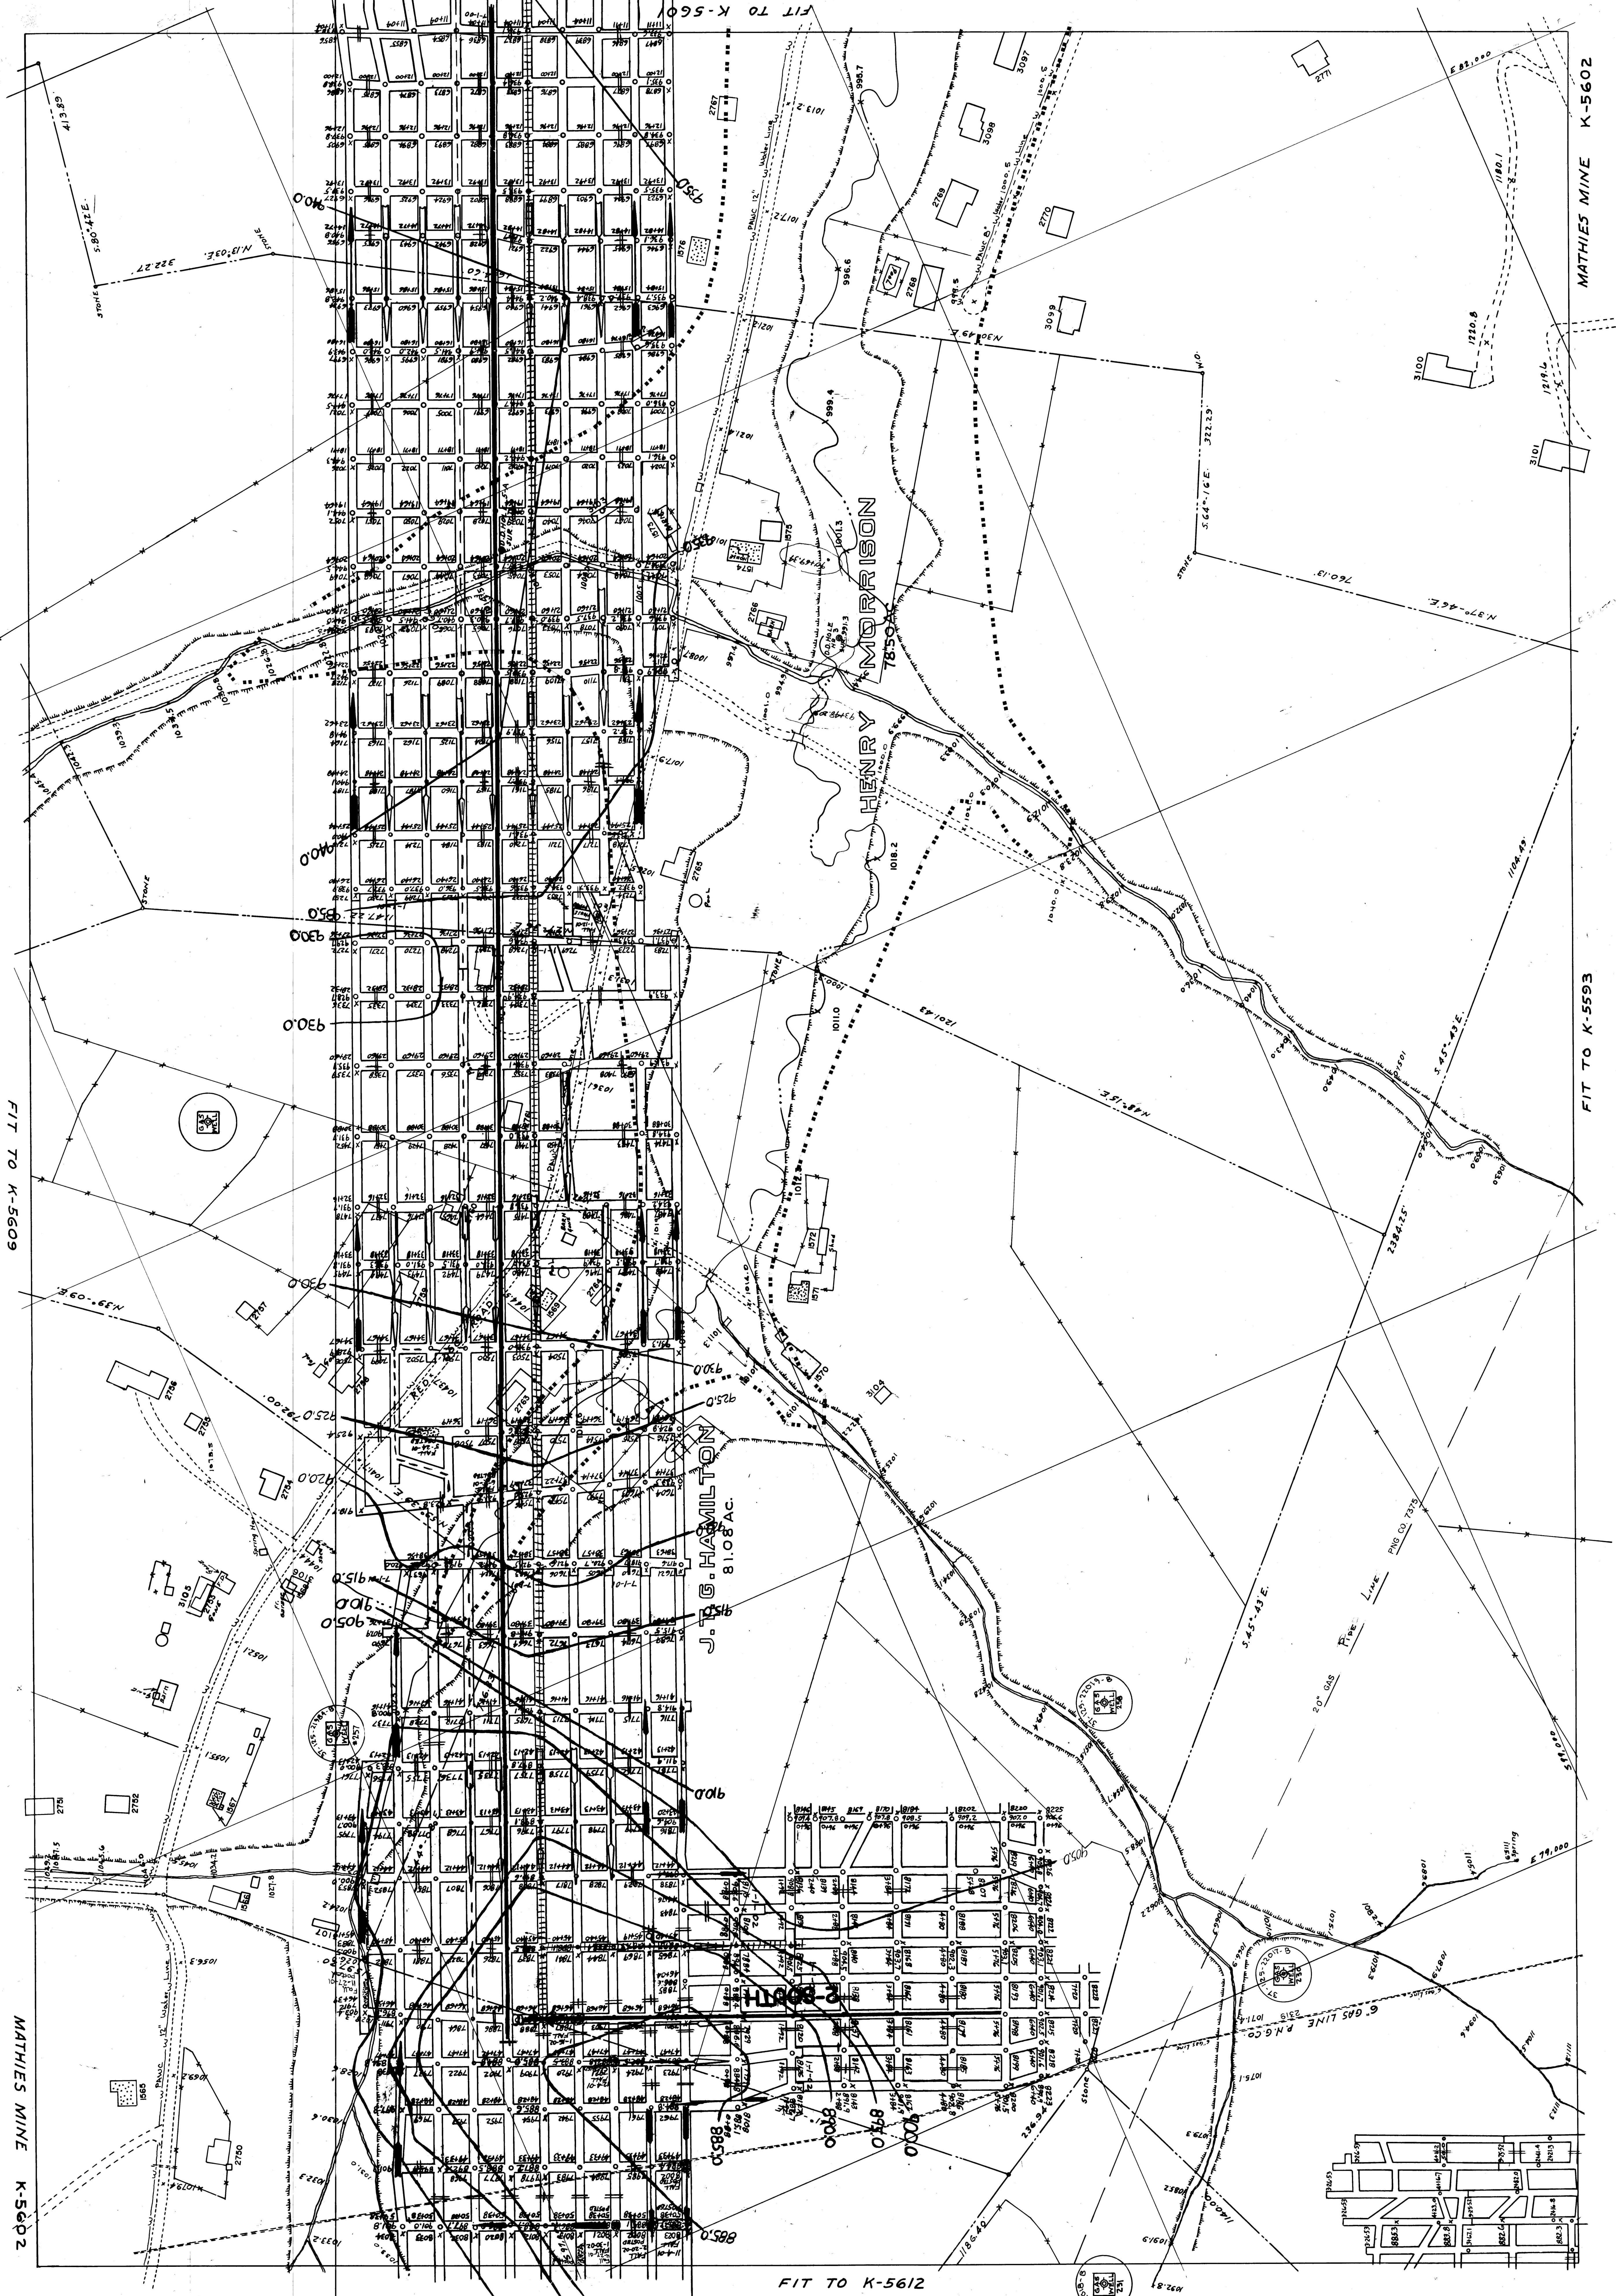

FIT TO K-5609

MATHIES MINE K-5602

FIT TO K-5612

FIT TO K-5593

MATHIES MINE K-5602