


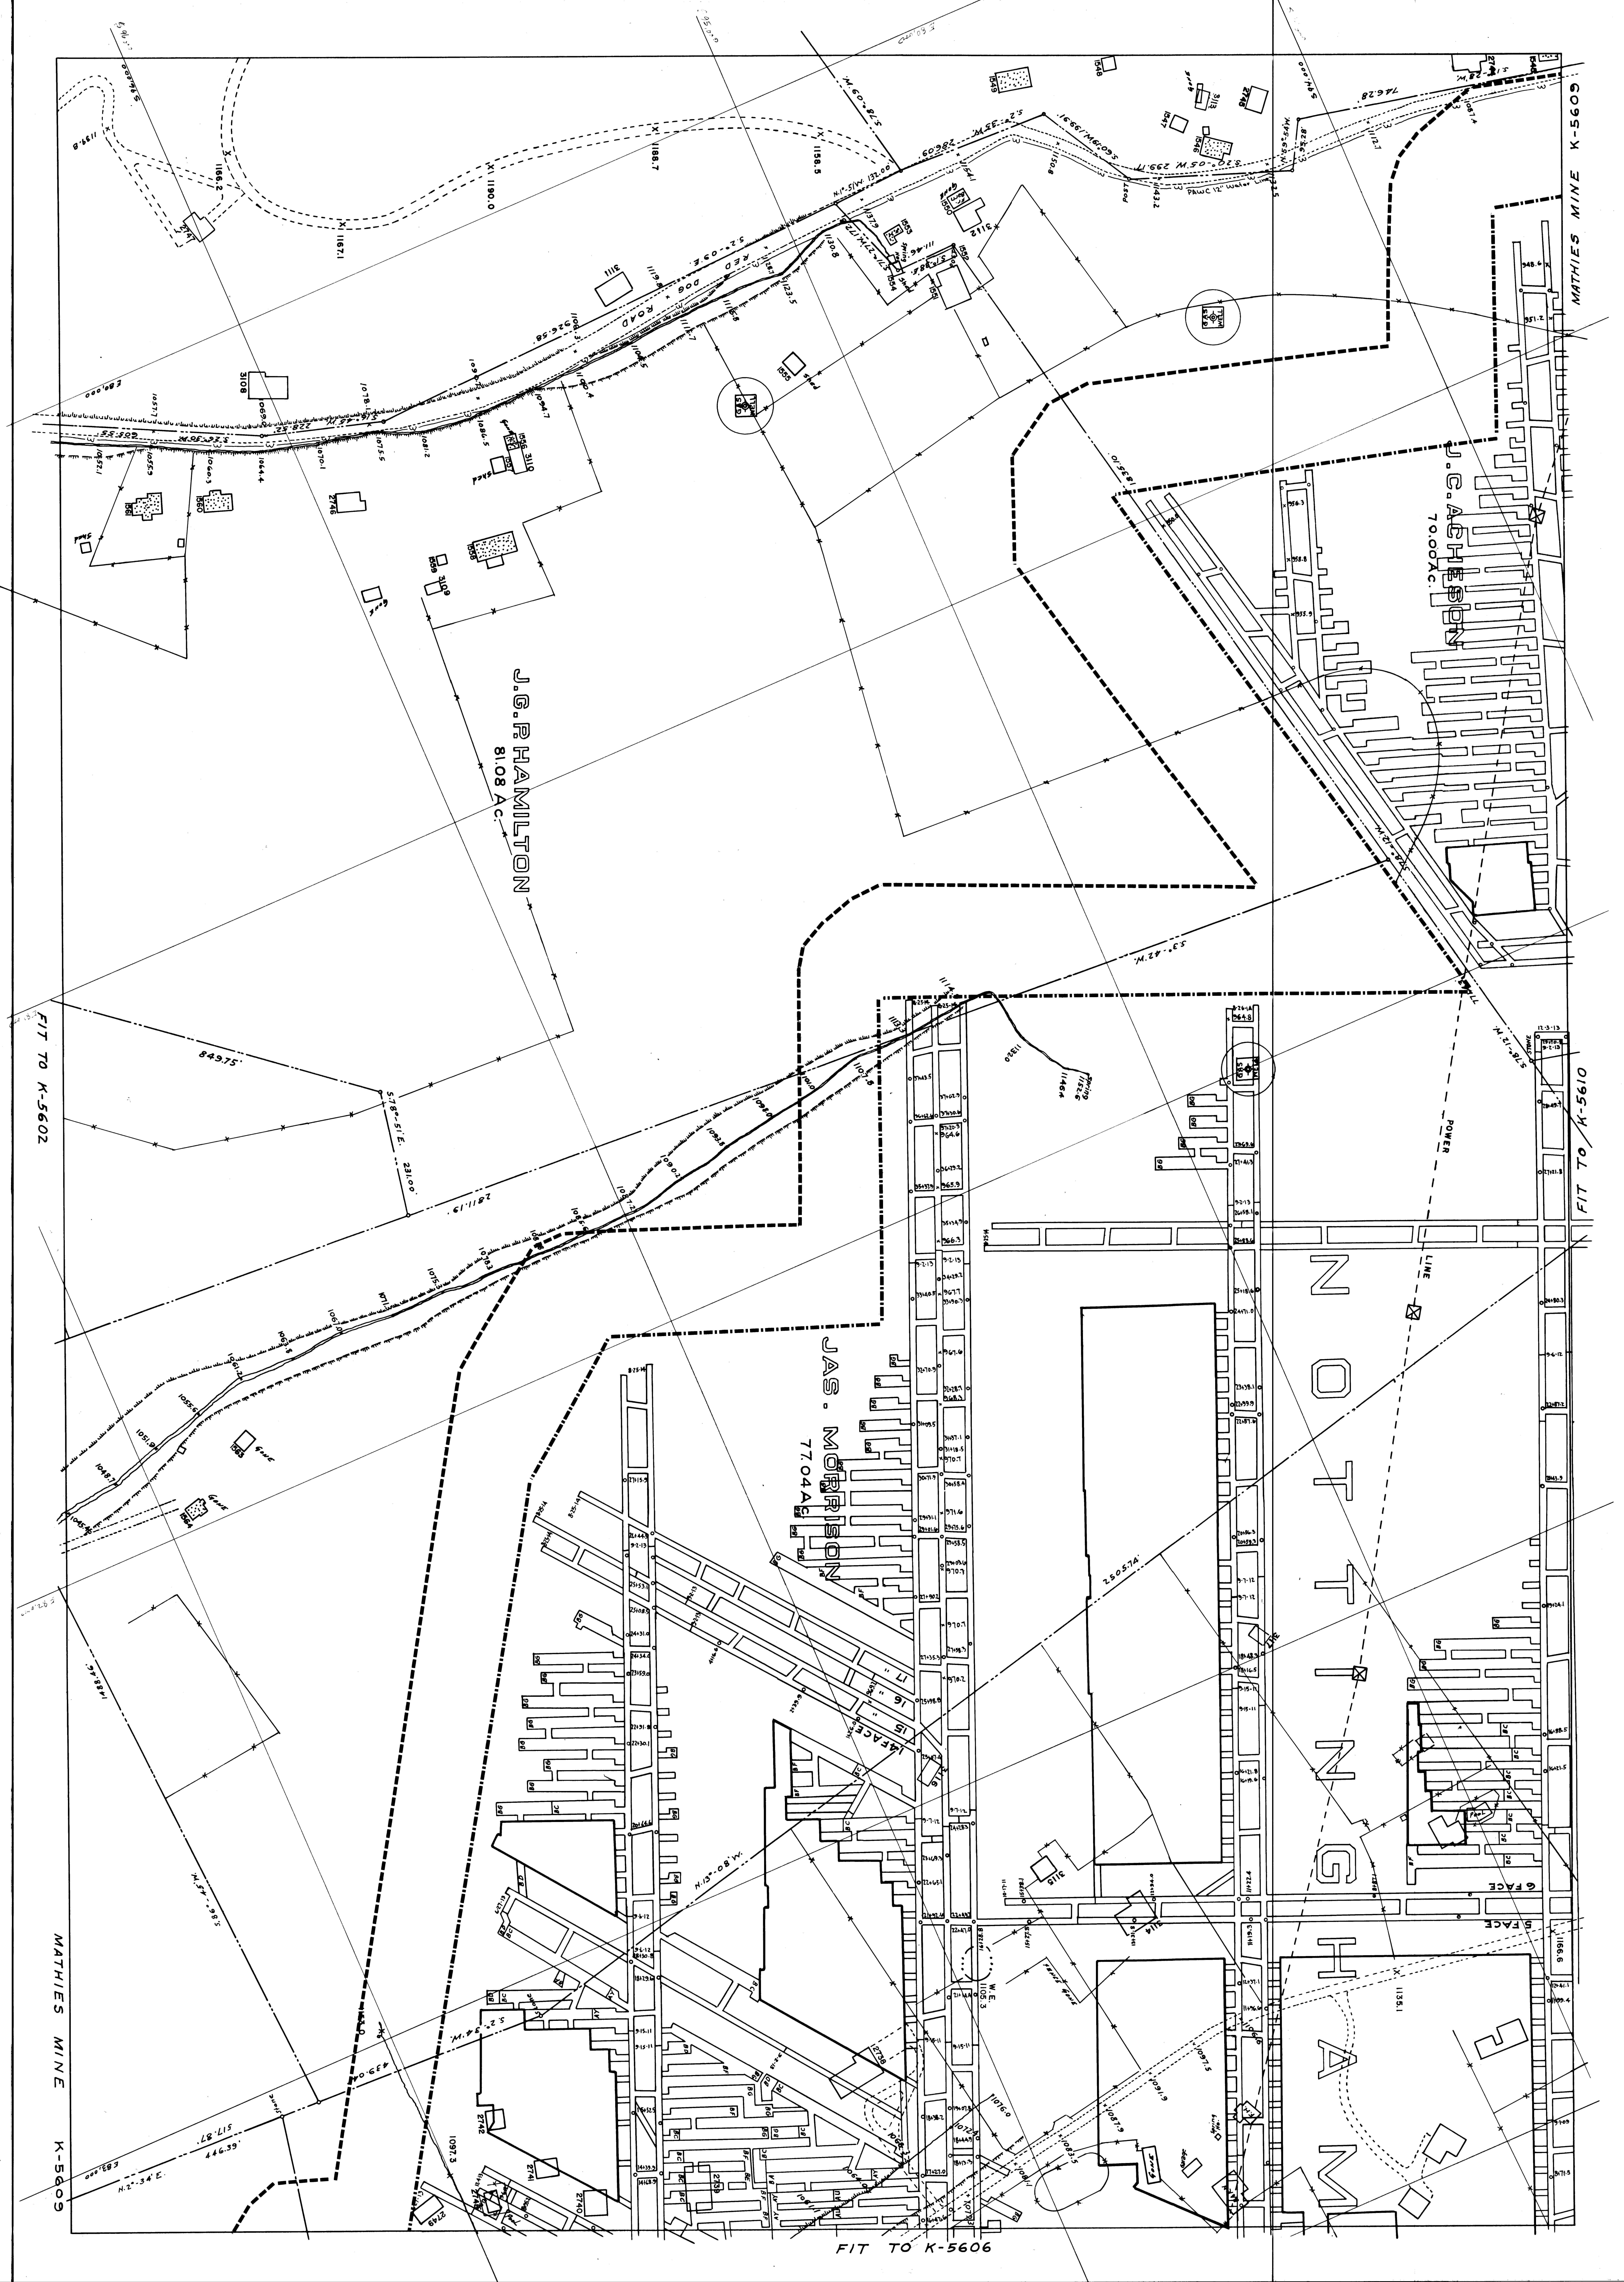

FIT TO K-5610

FIT TO K-5606

FIT TO K-5602

MATHIES MINE K-5609