


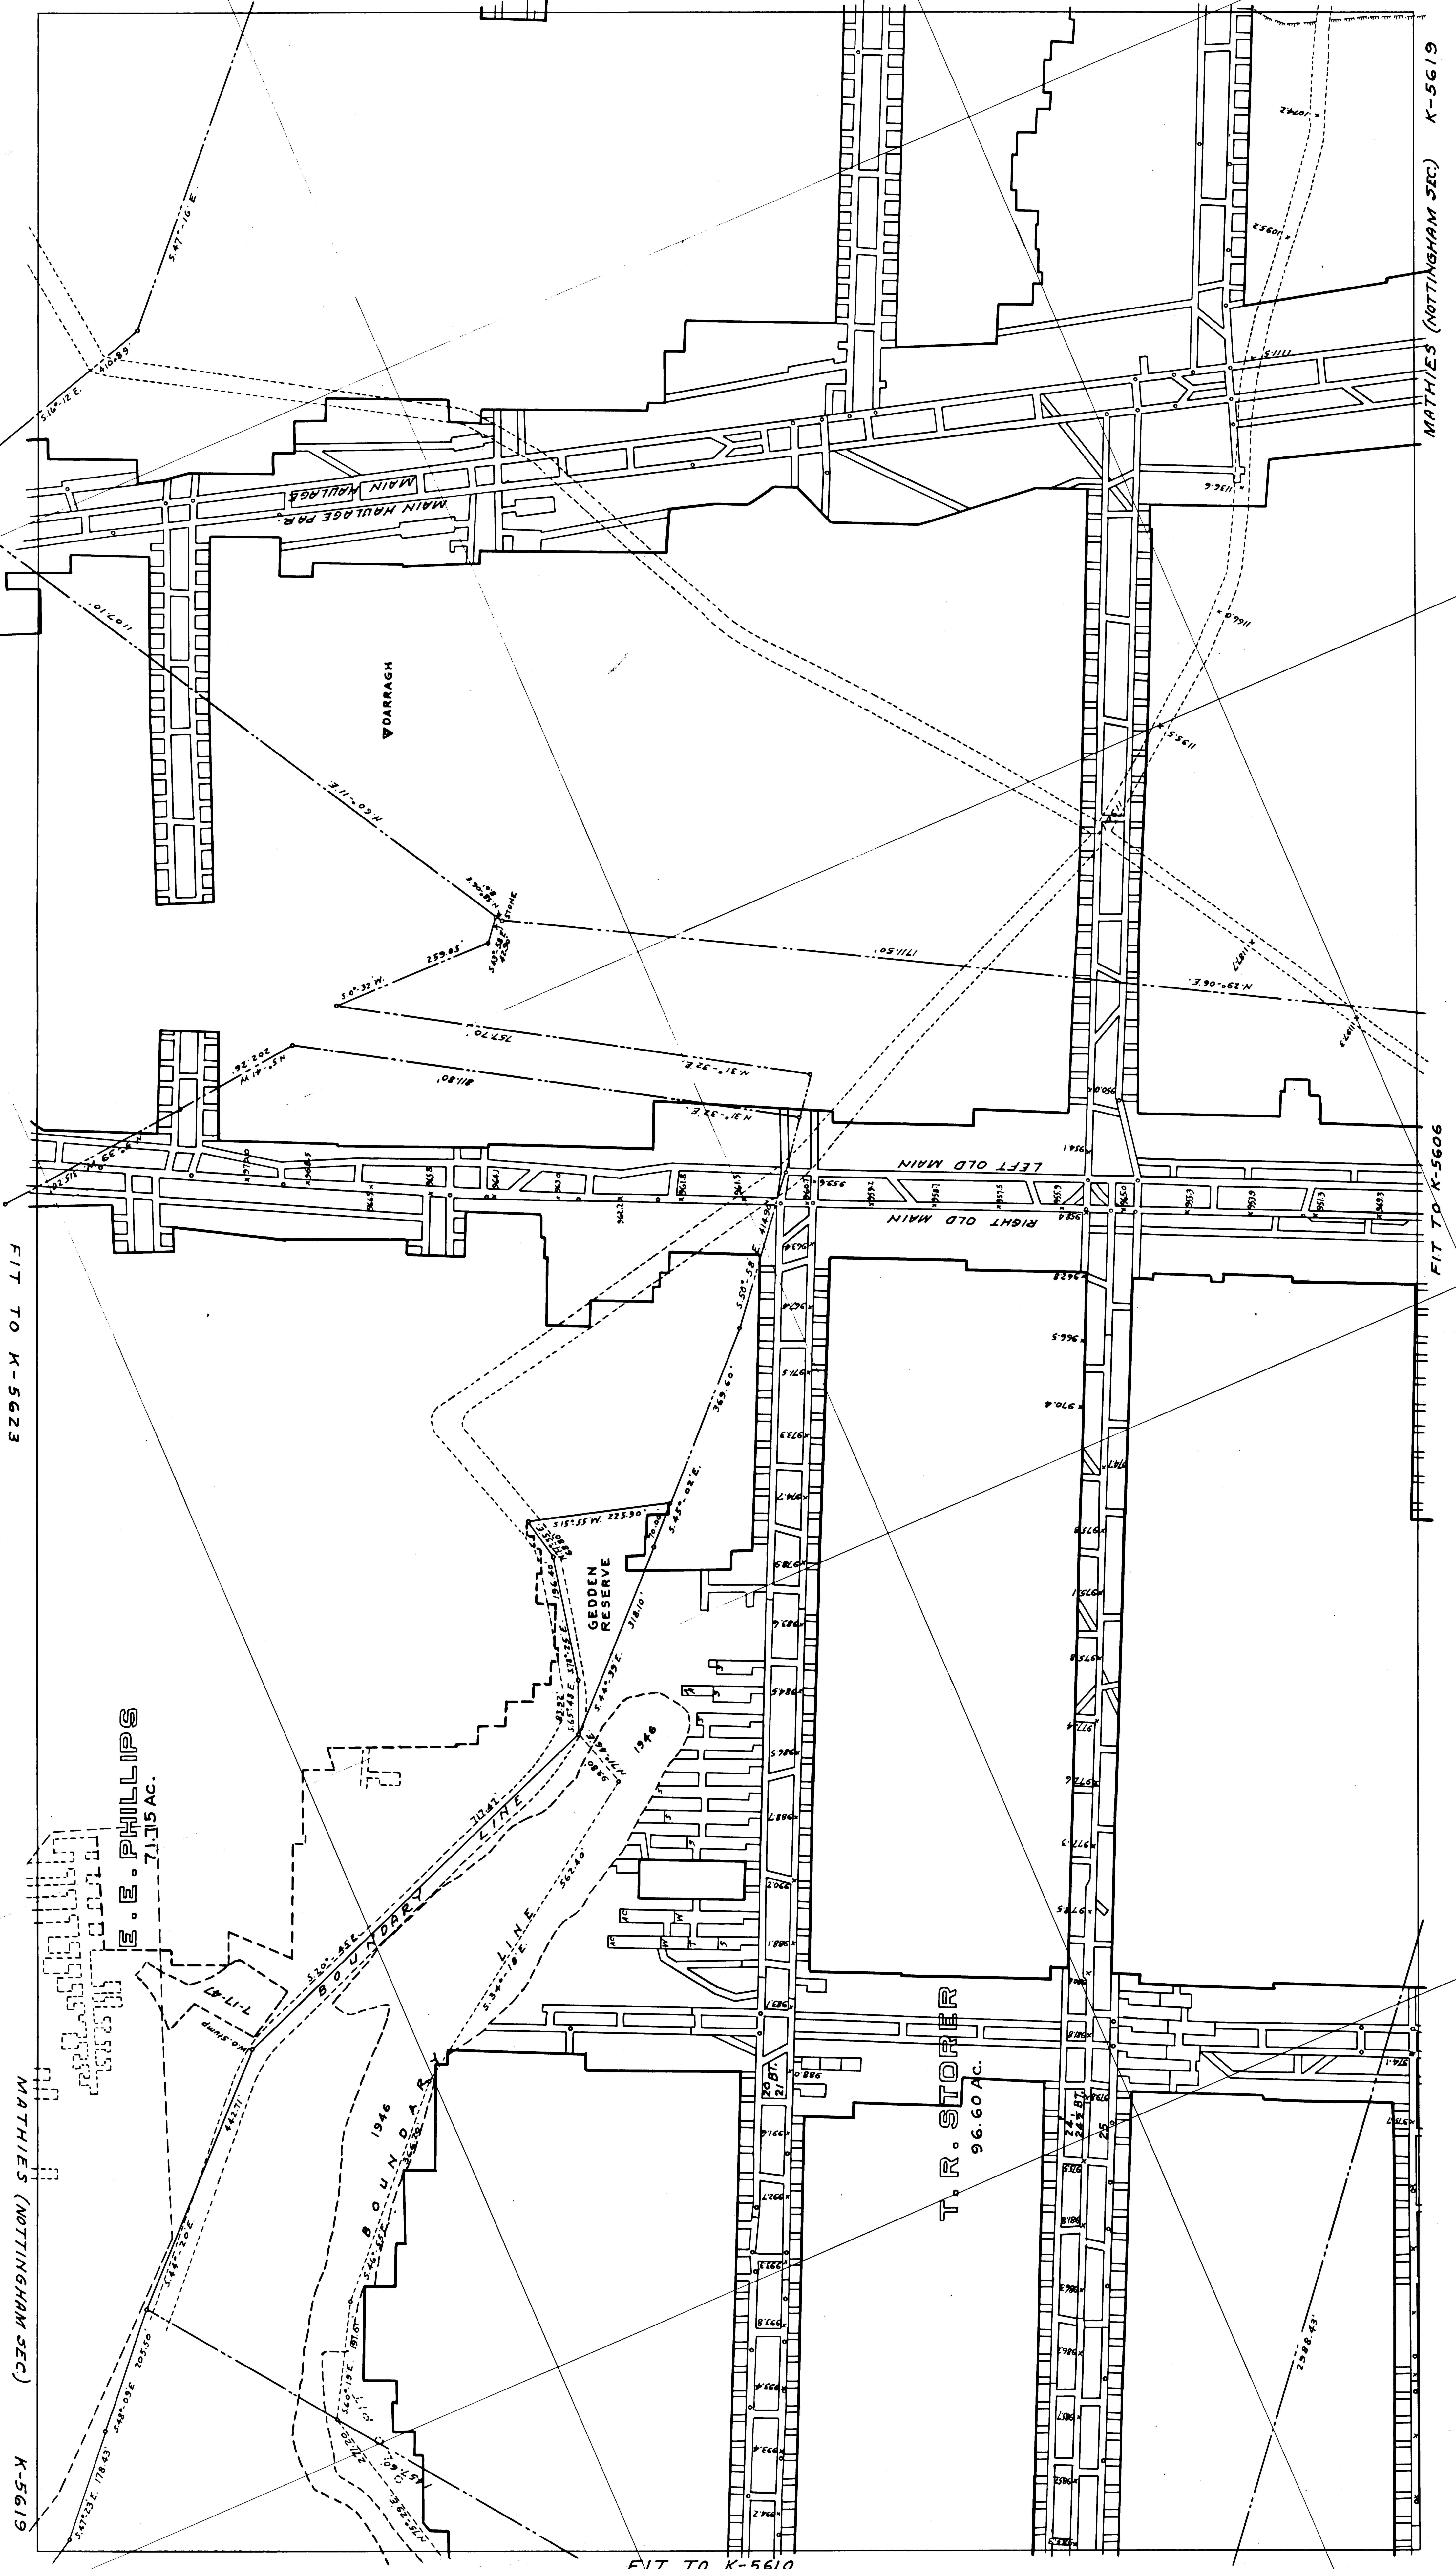

FIT TO K-5623

MATHIES (NOTTINGHAM SEC)

K-5619

FIT TO K-5610

FIT TO K-5606

MATHIES (NOTTINGHAM SEC) K-5619