


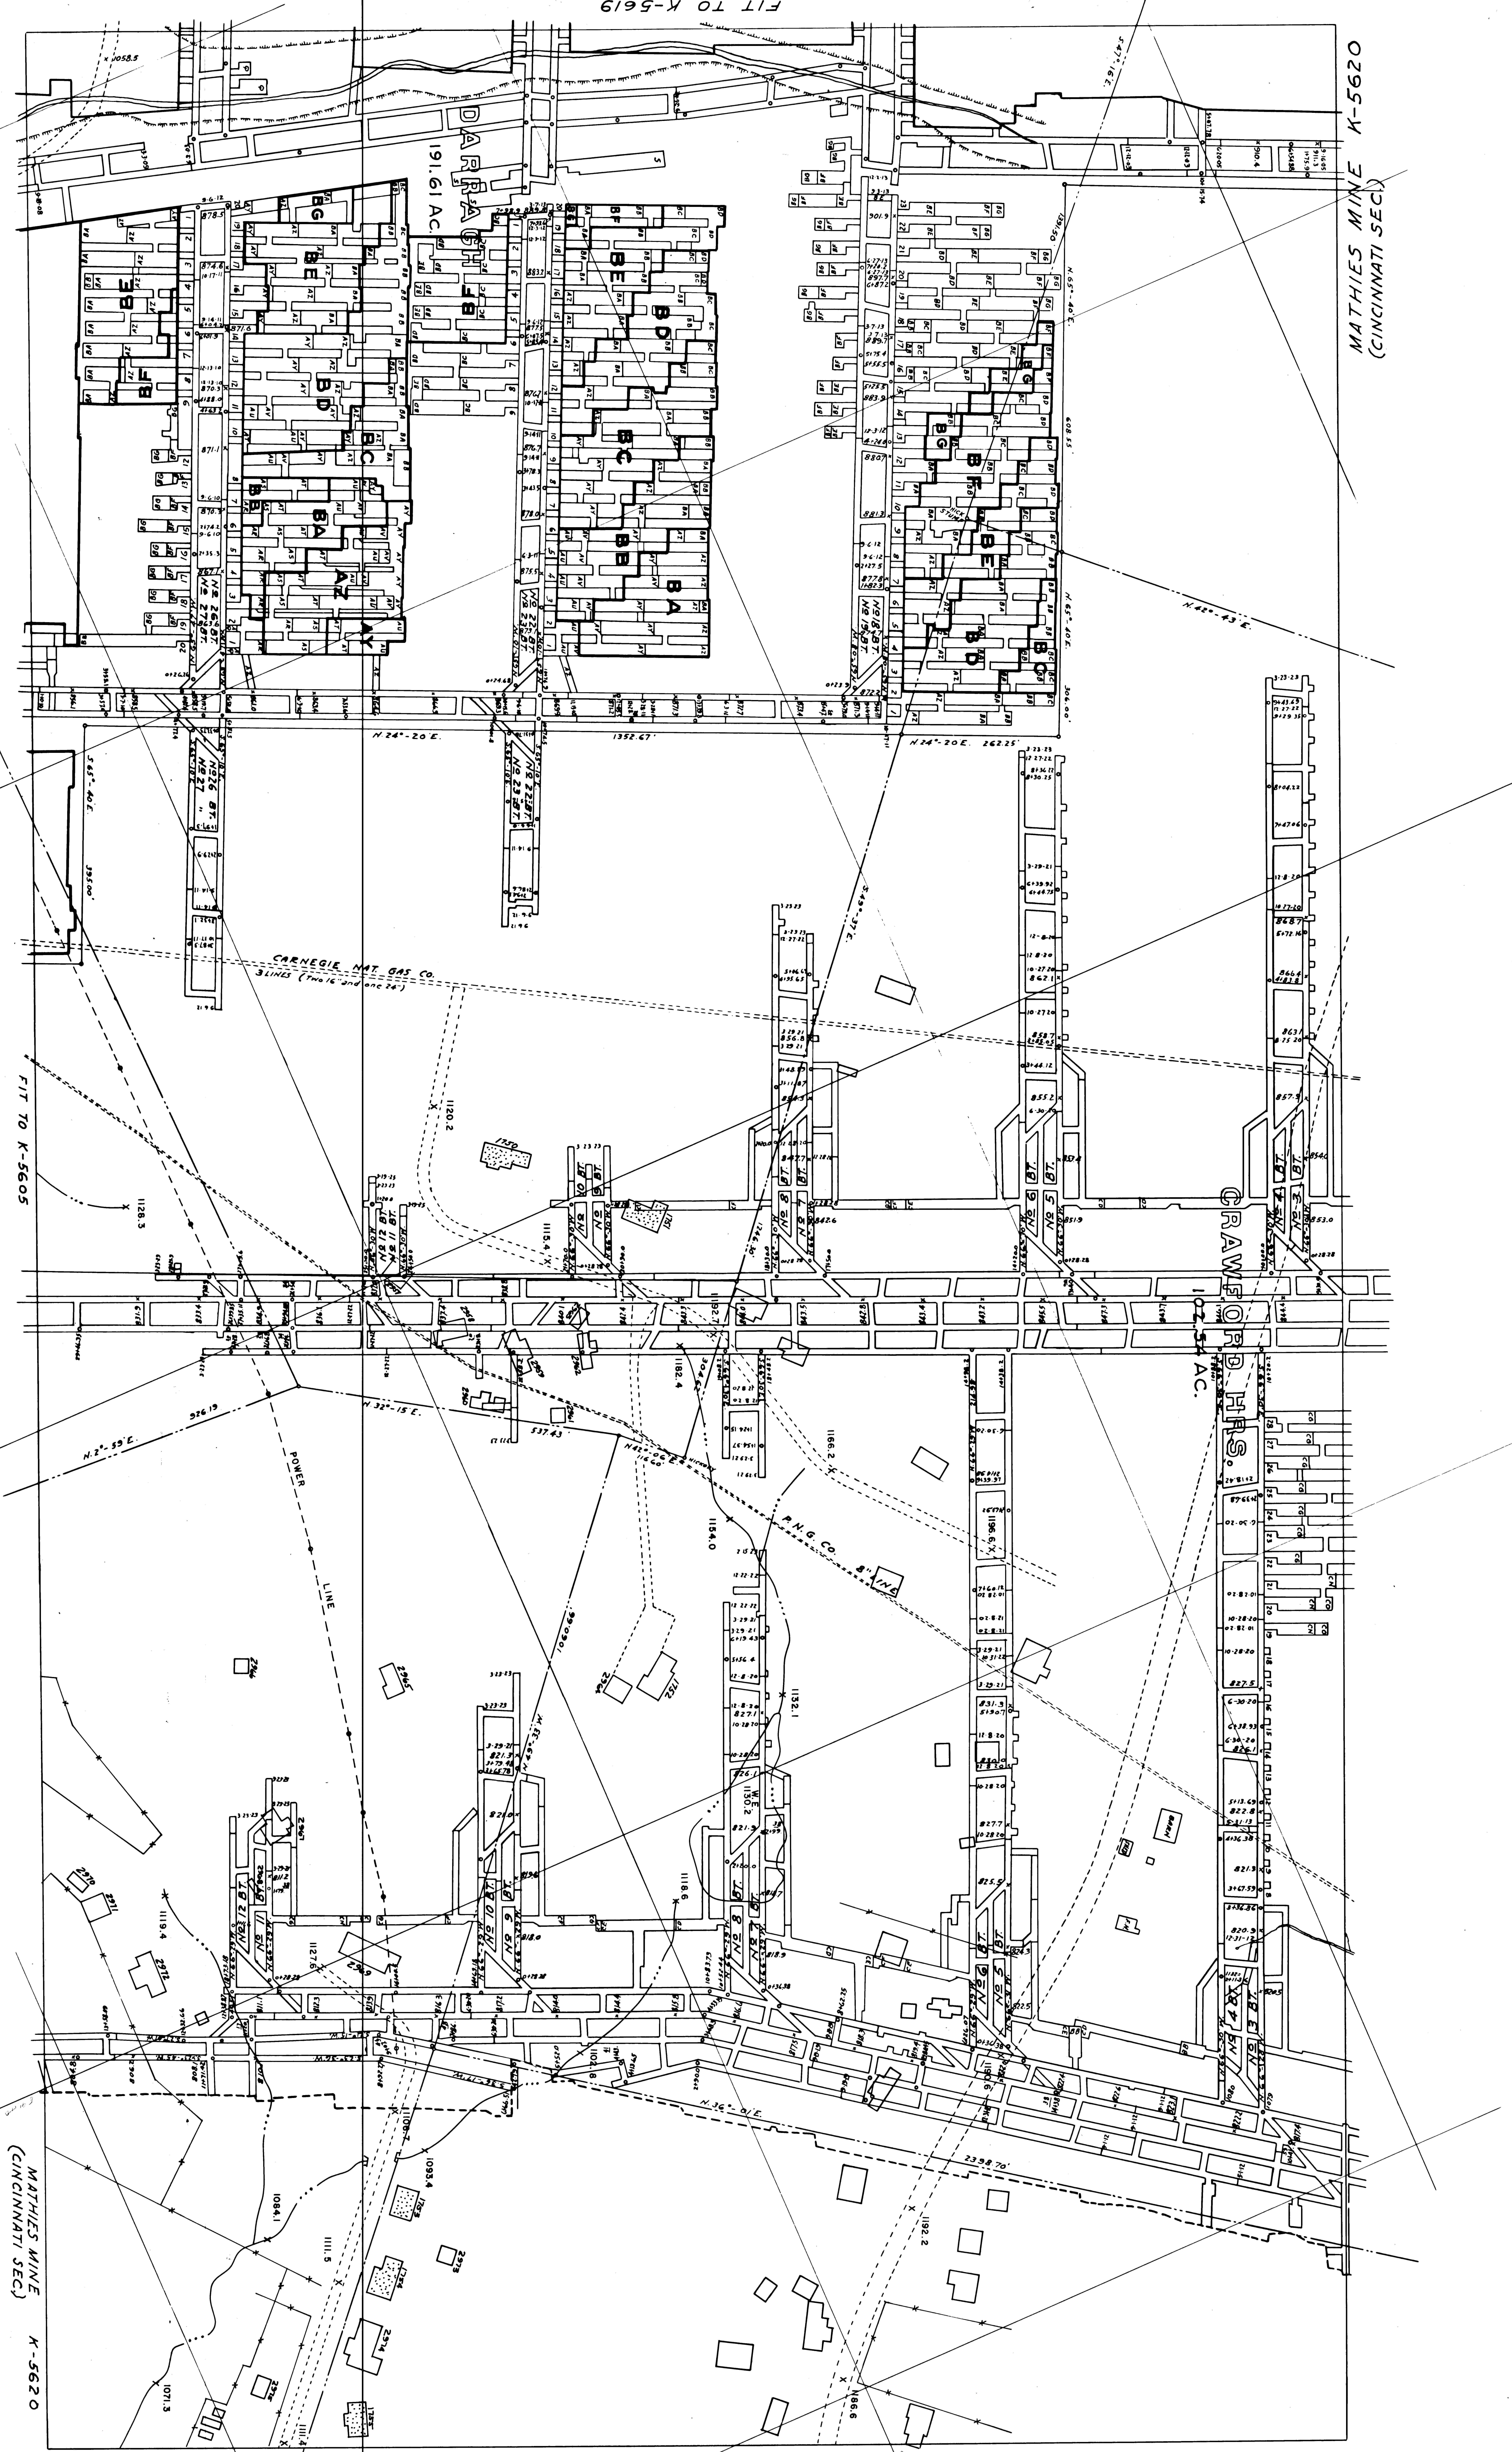

MATHIES MINE K-5620
(CINCINNATI SEC.)

FIT TO K-5605

MATHIES MINE K-5620
(CINCINNATI SEC.)

FIT TO K-5619