


FIT TO K-5627

MATHIES MINE K-5625

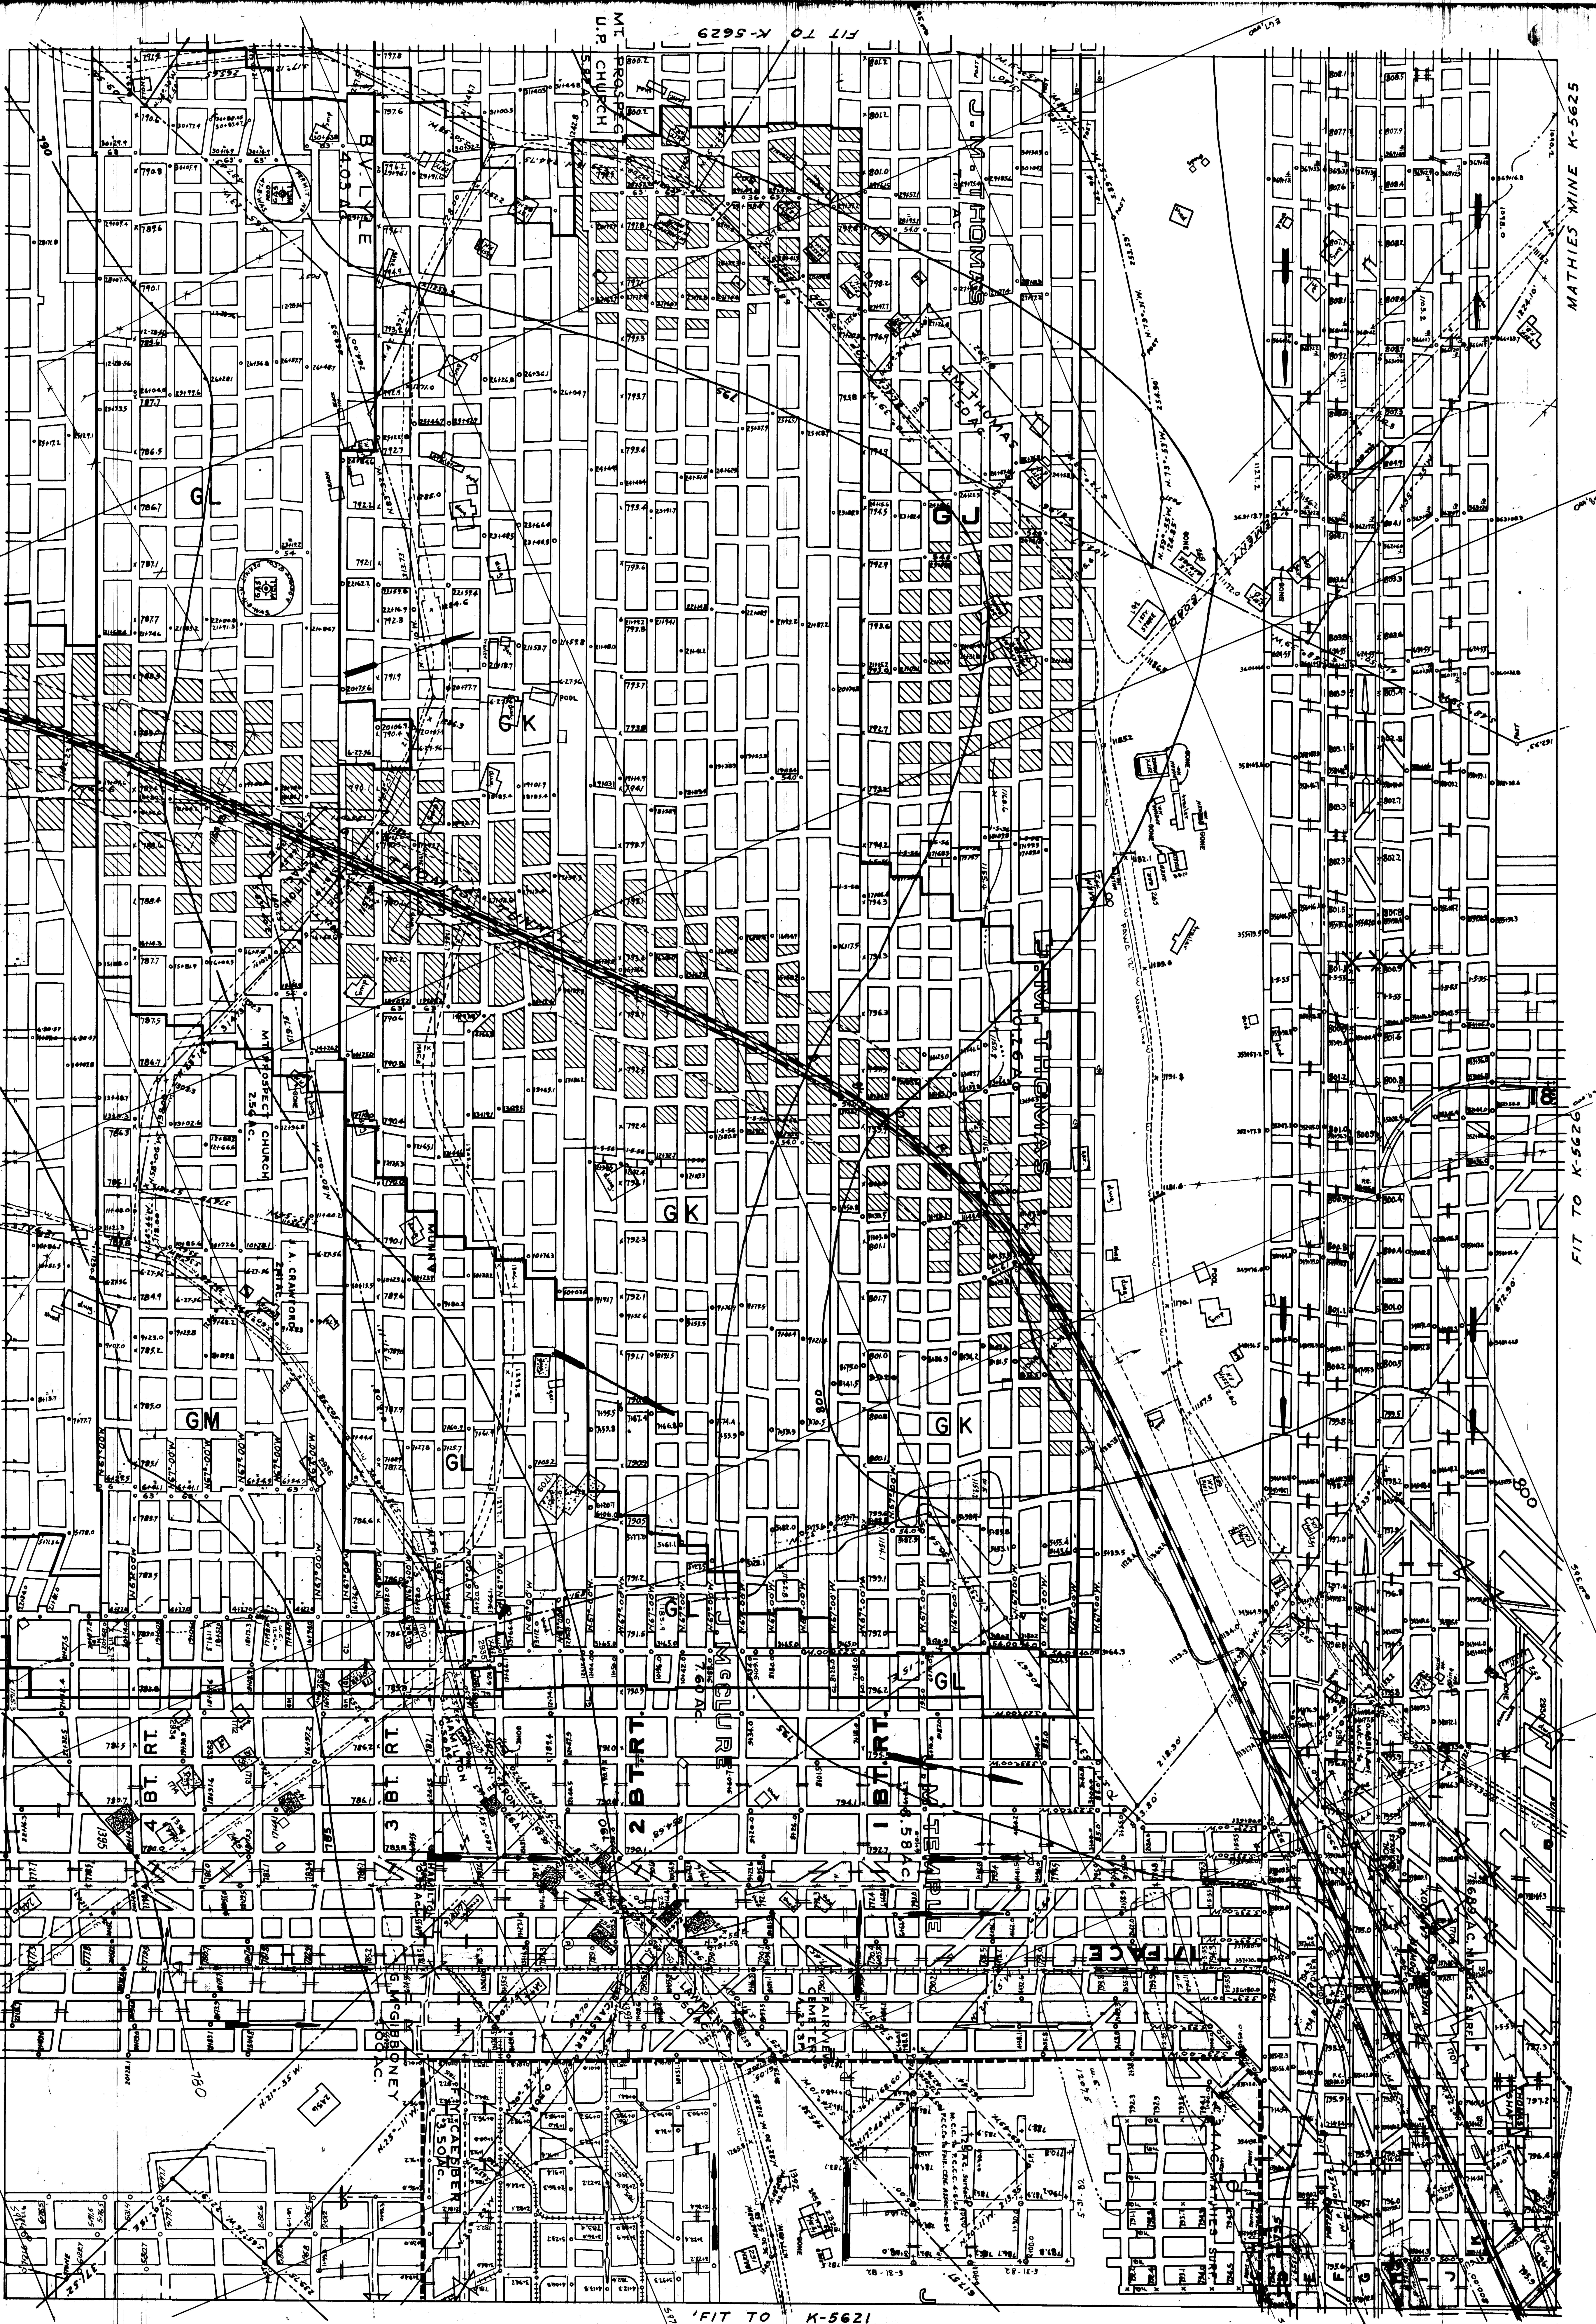

MATHIES MINE K-5625

FIT TO K-5626

FIT TO K-5621