


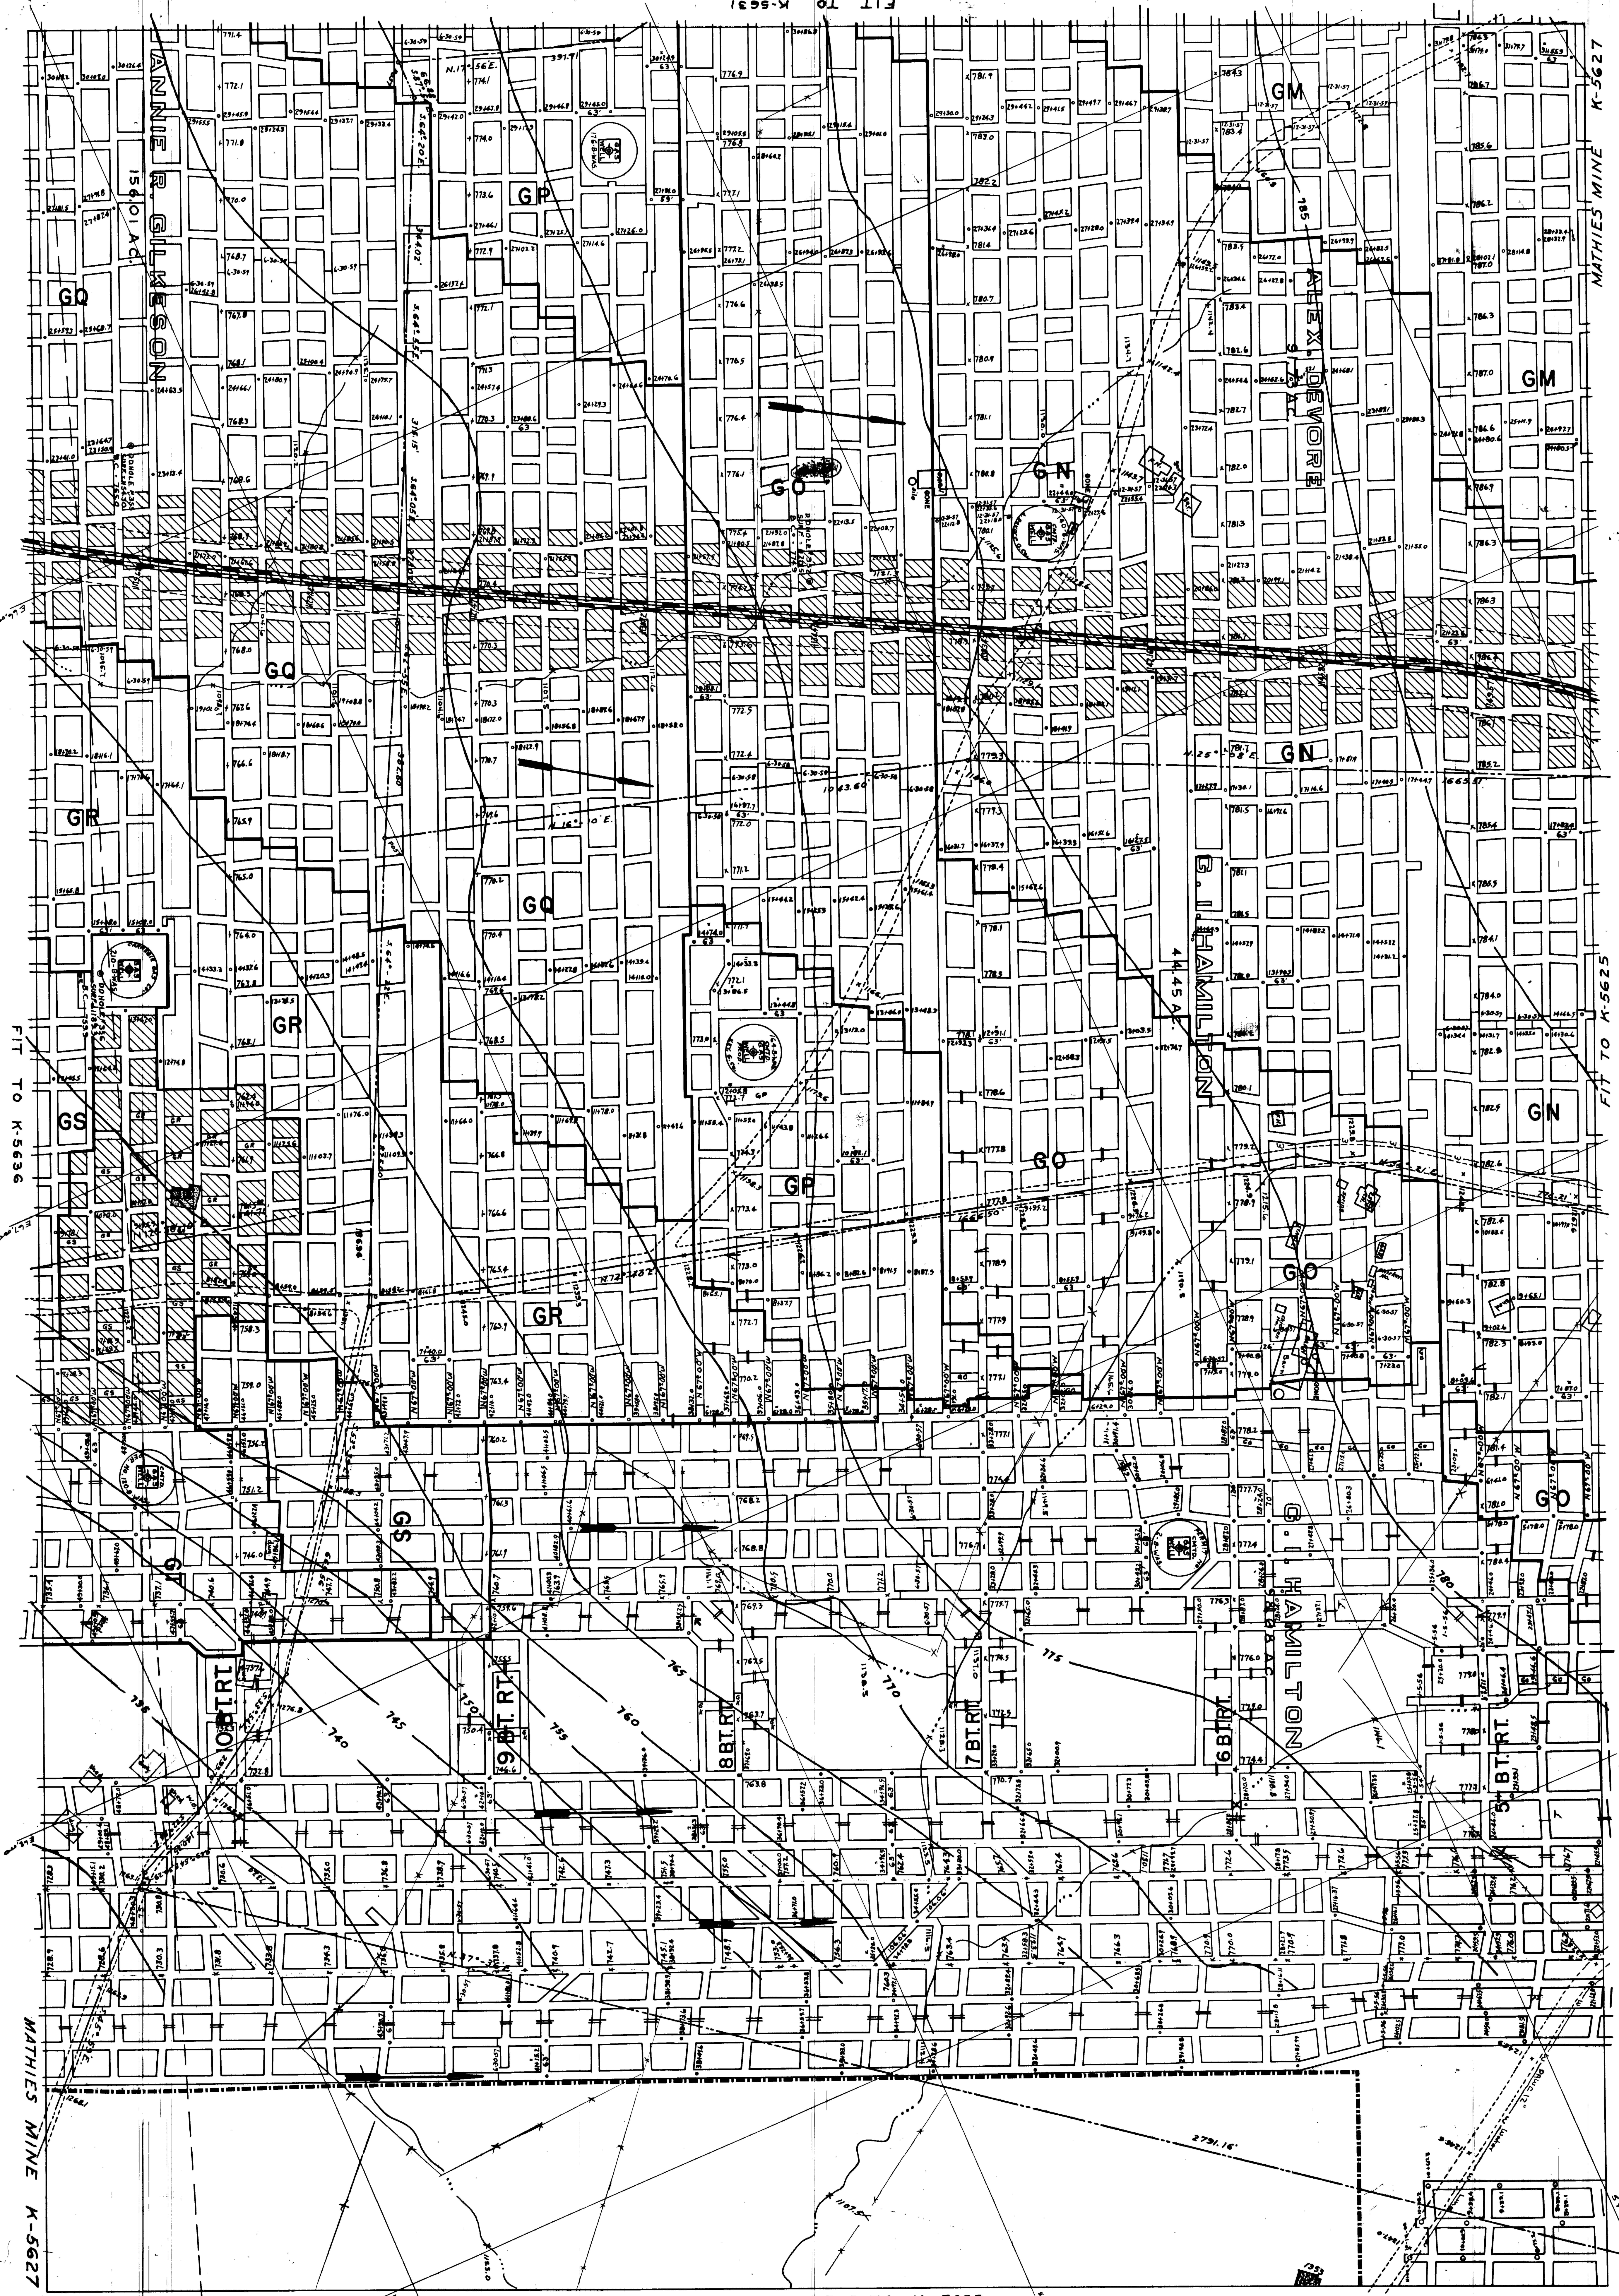

FIT TO K-5636

MATHIES MINE K-5627

FIT TO K-5631

FIT TO K-5622

MATHIES MINE K-5627

FIT TO K-5625