


FIT TO K-5645


LINDEN PORTAL

INTAKE SHAFT
TOP OF COPING 9740
BOTTOM OF COAL 7460
RETURN SHAFT
TOP OF COPING 9730
BOTTOM OF COAL 7470
FAN JEFFREY 8H-96 AERODYNE FAN
HP 500
RPM 880
CFM
WATER GAUGE

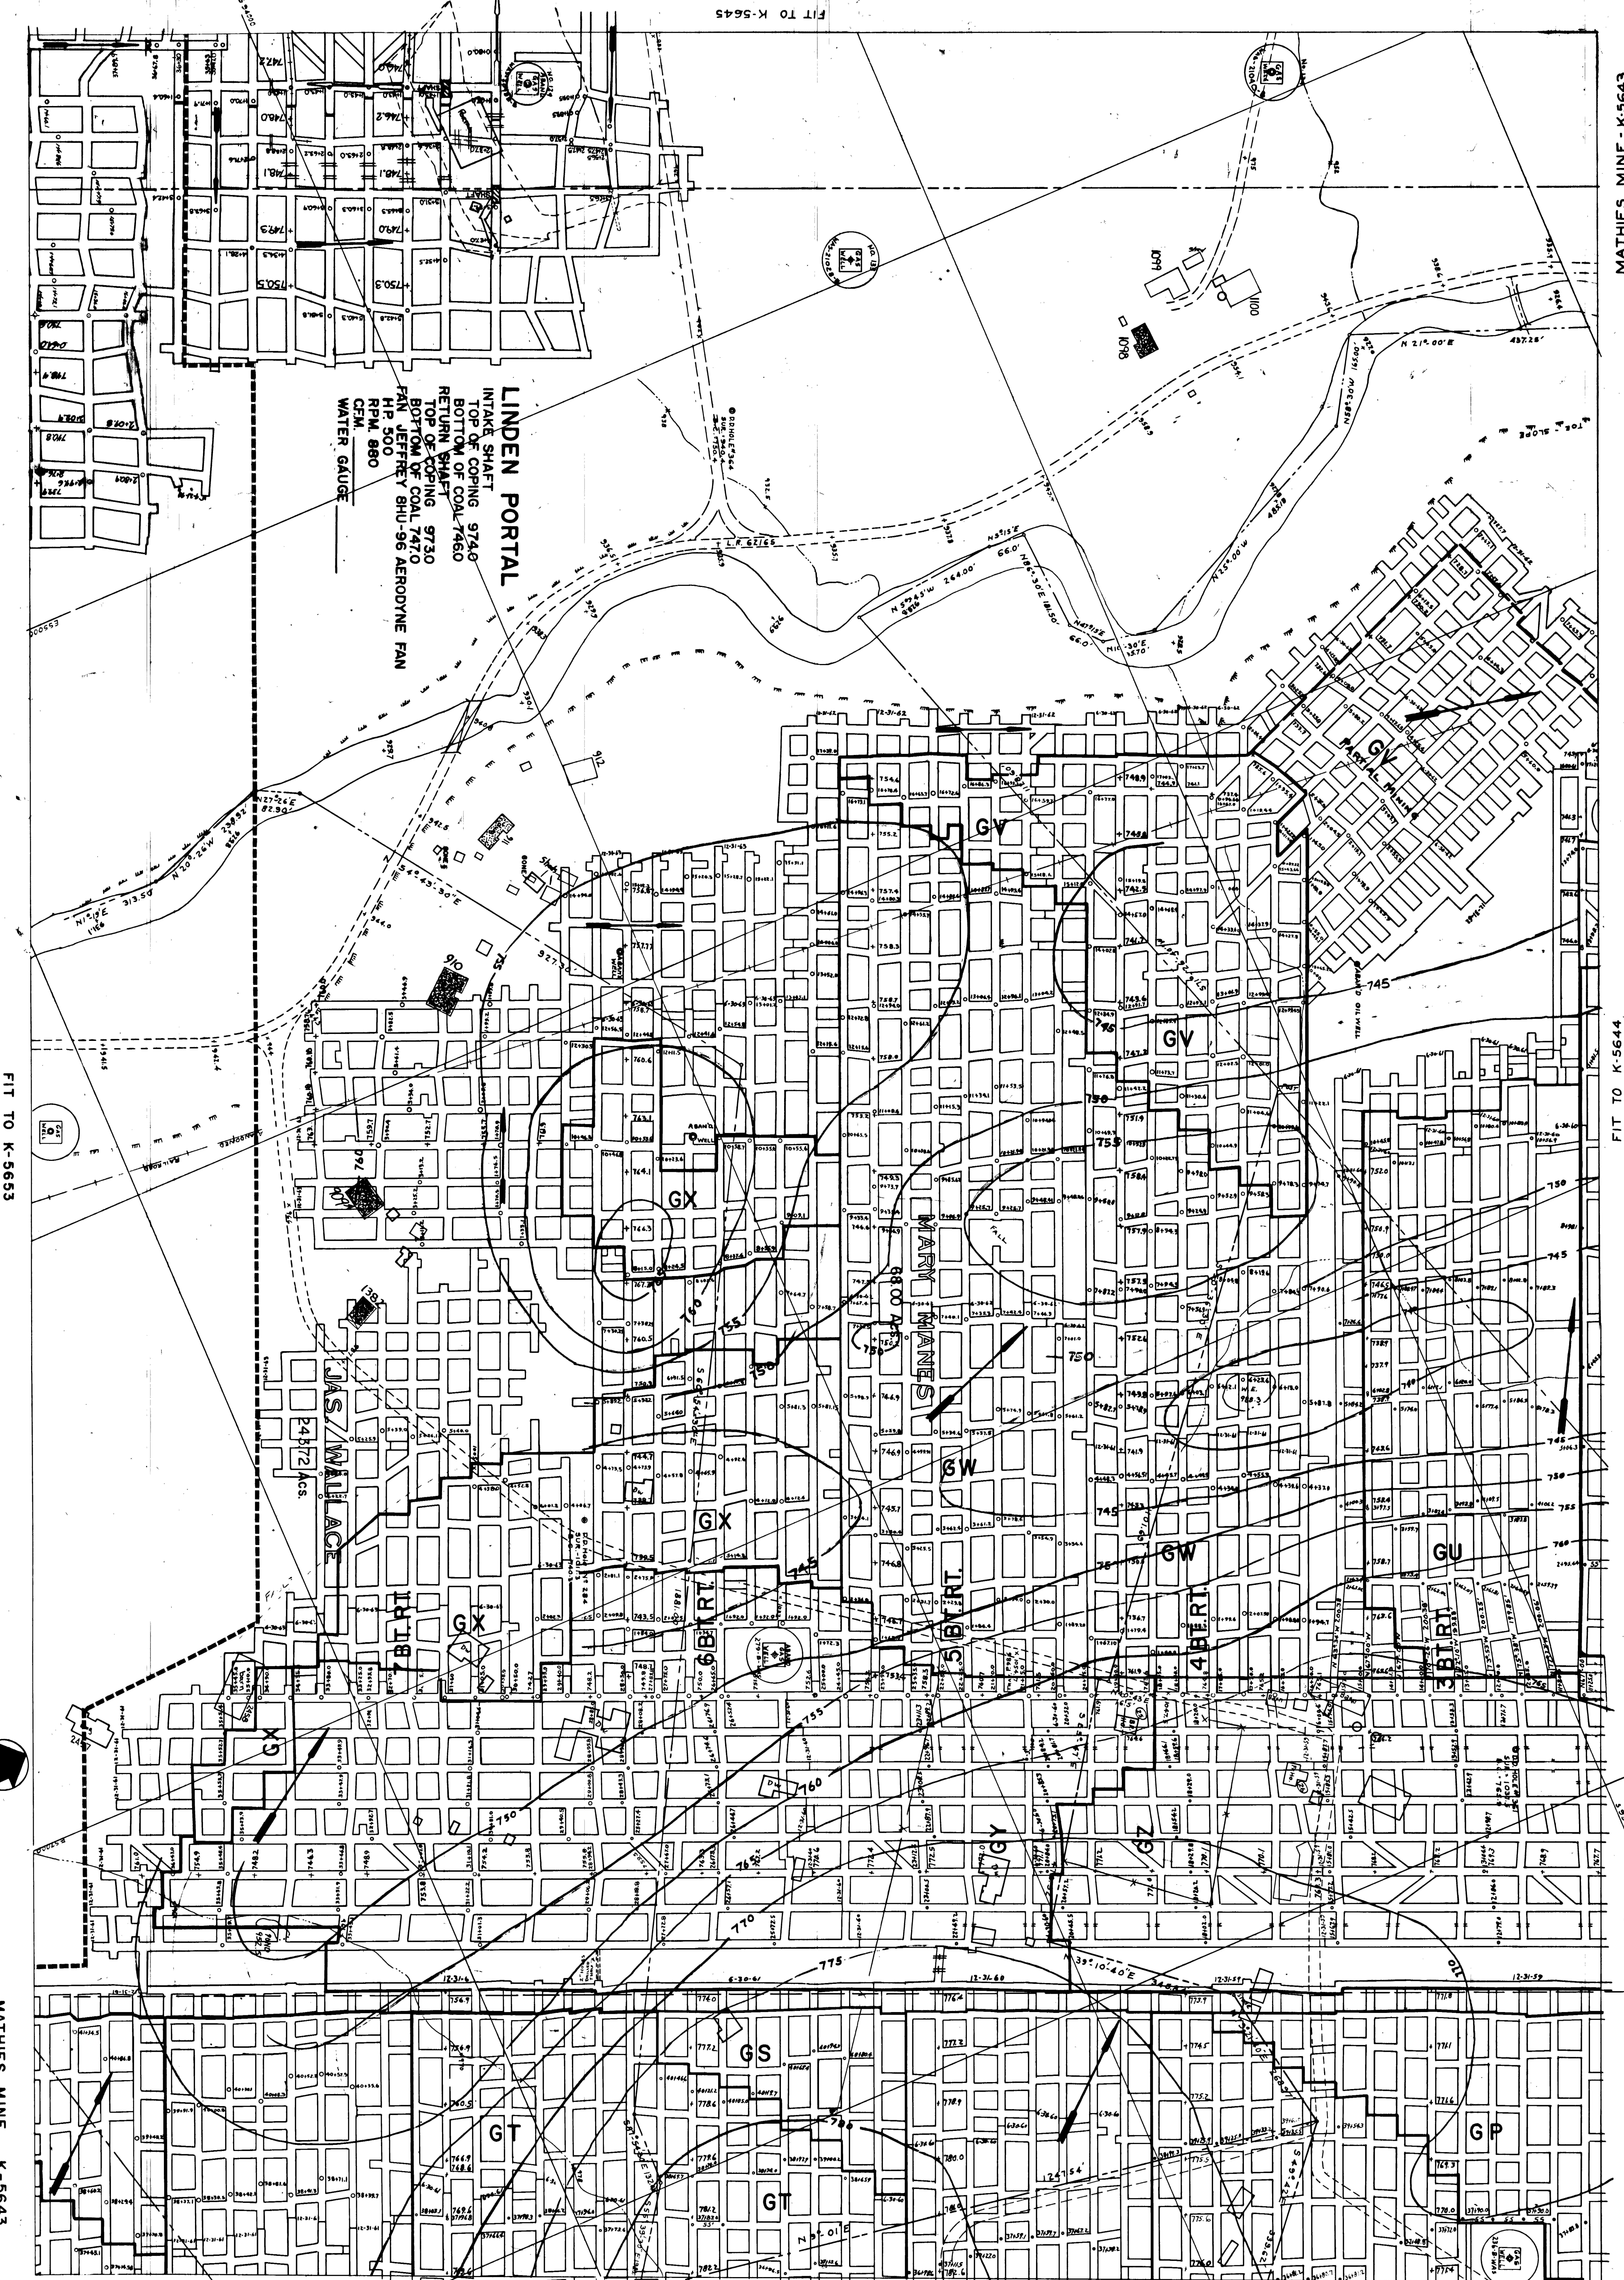

FIT TO K-5653