



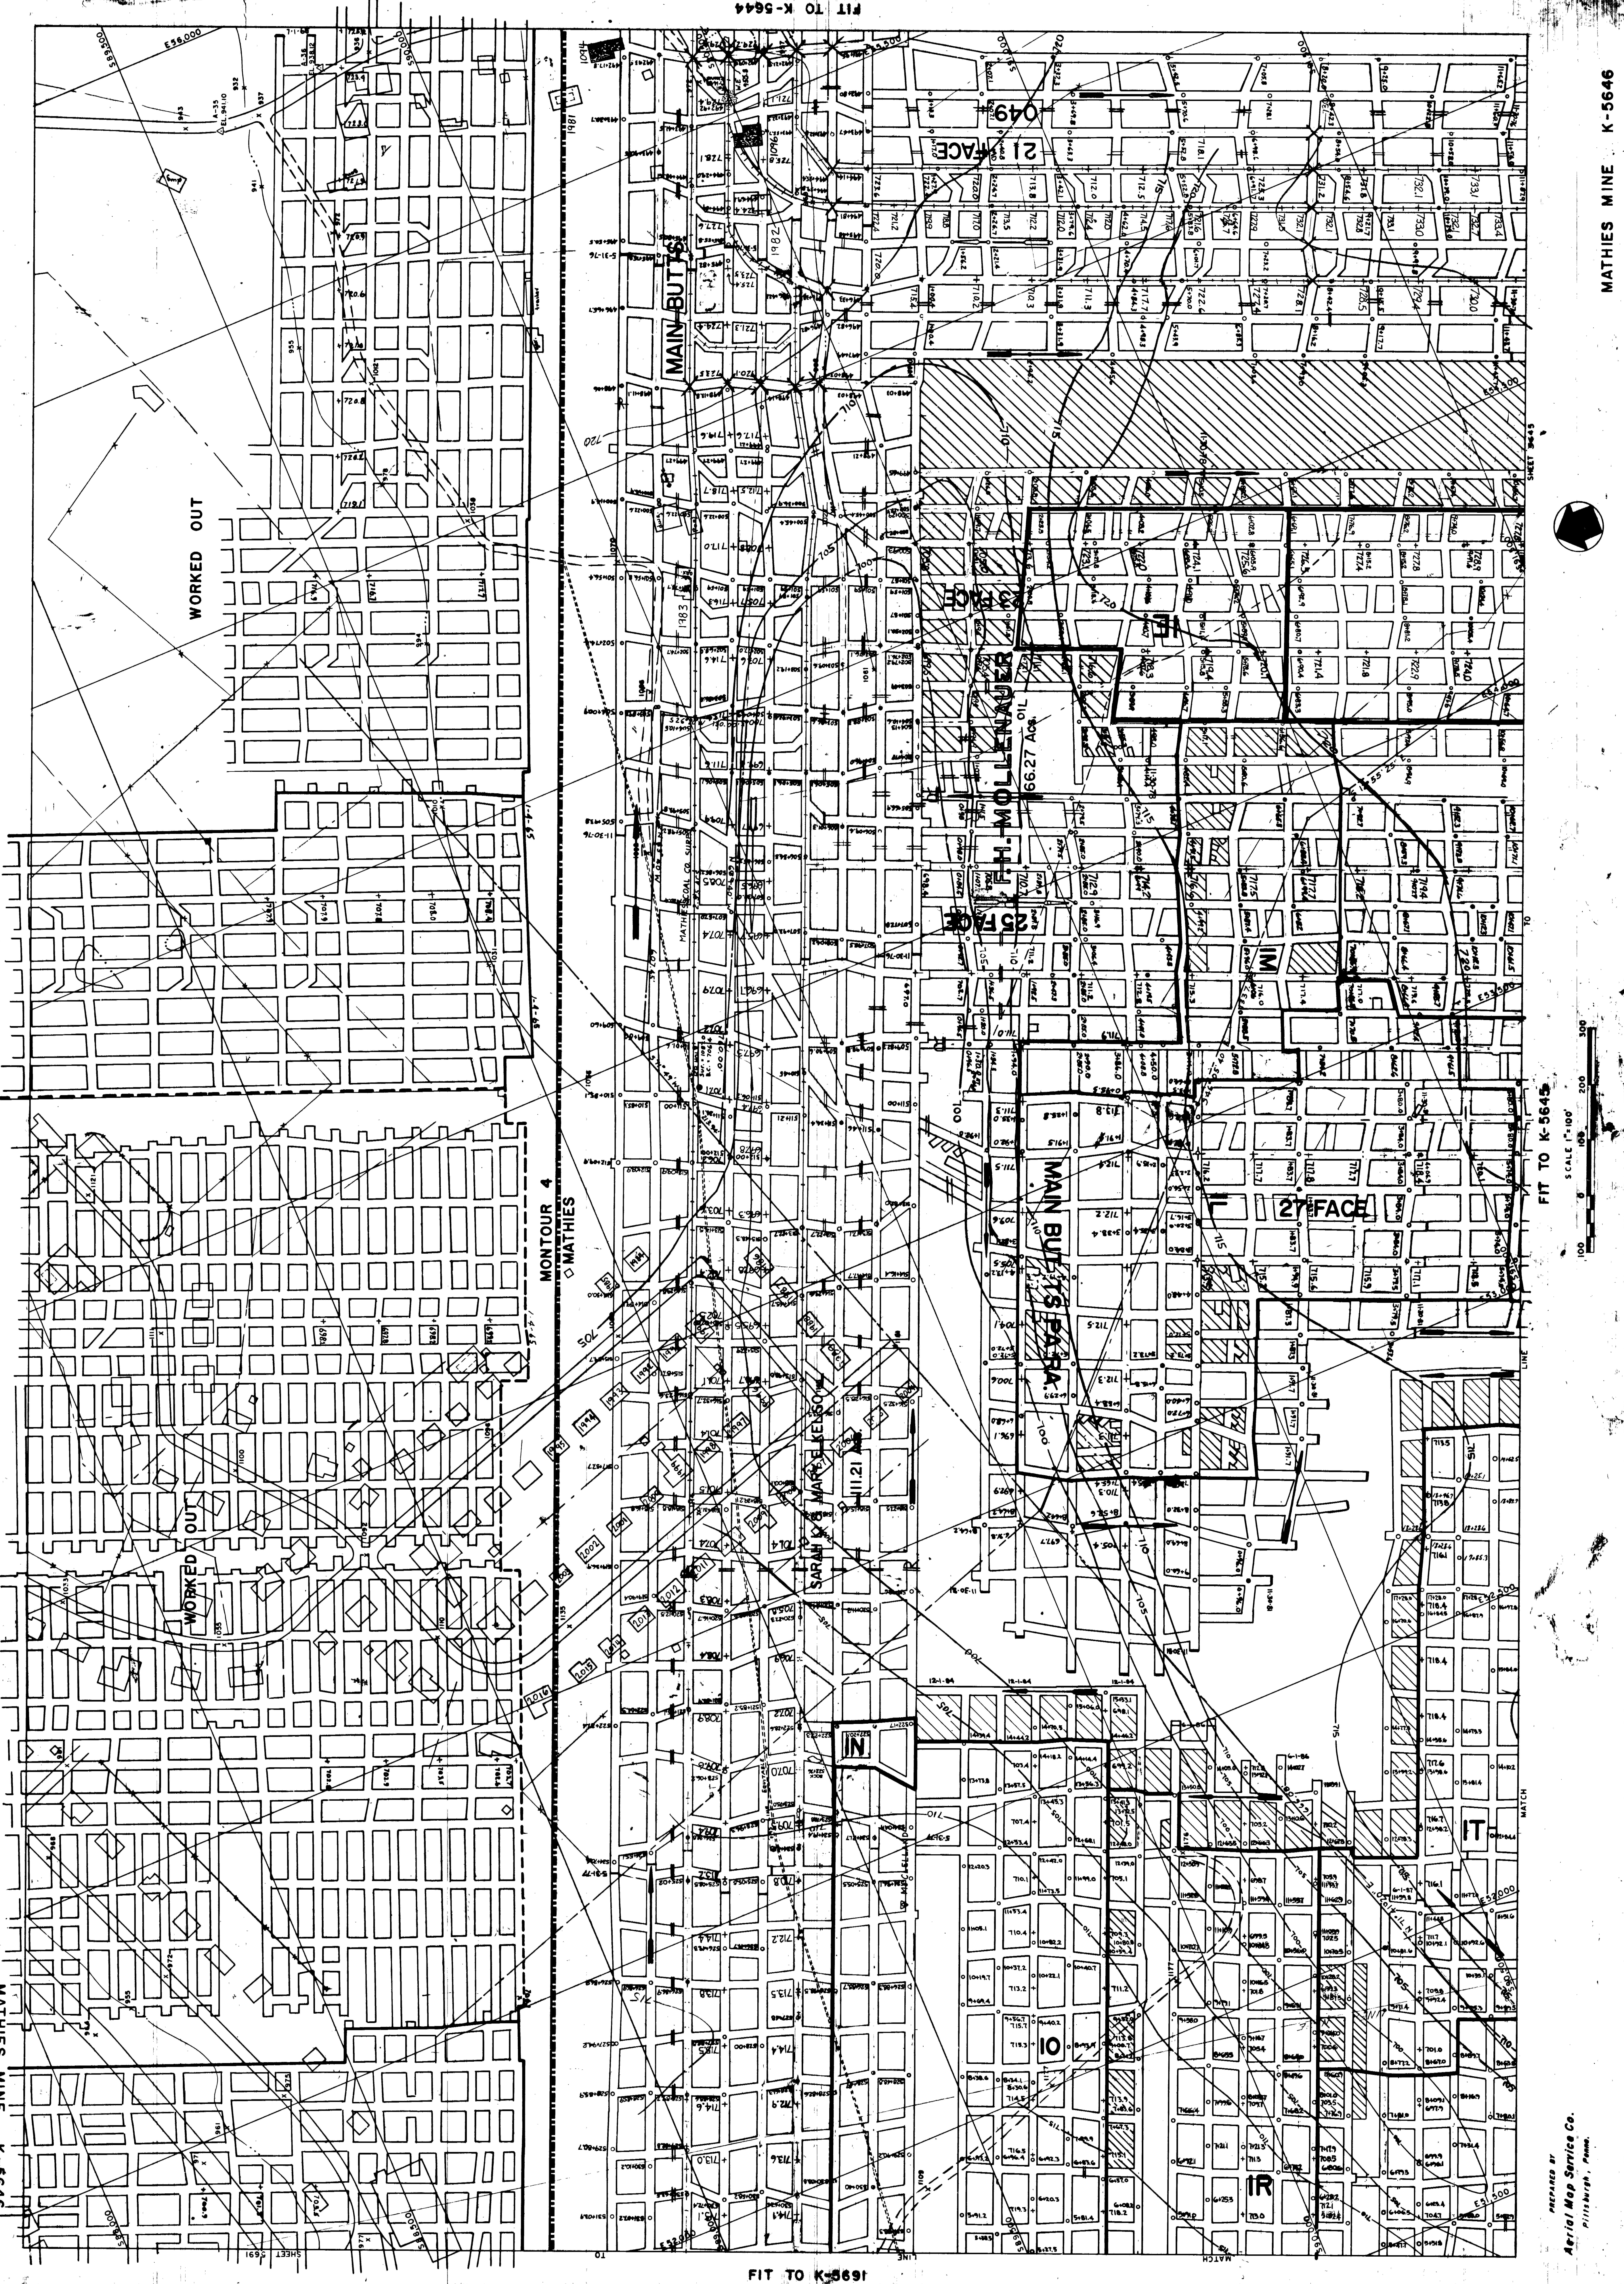

MATHIES MINE K-5646

FIT TO K-5645

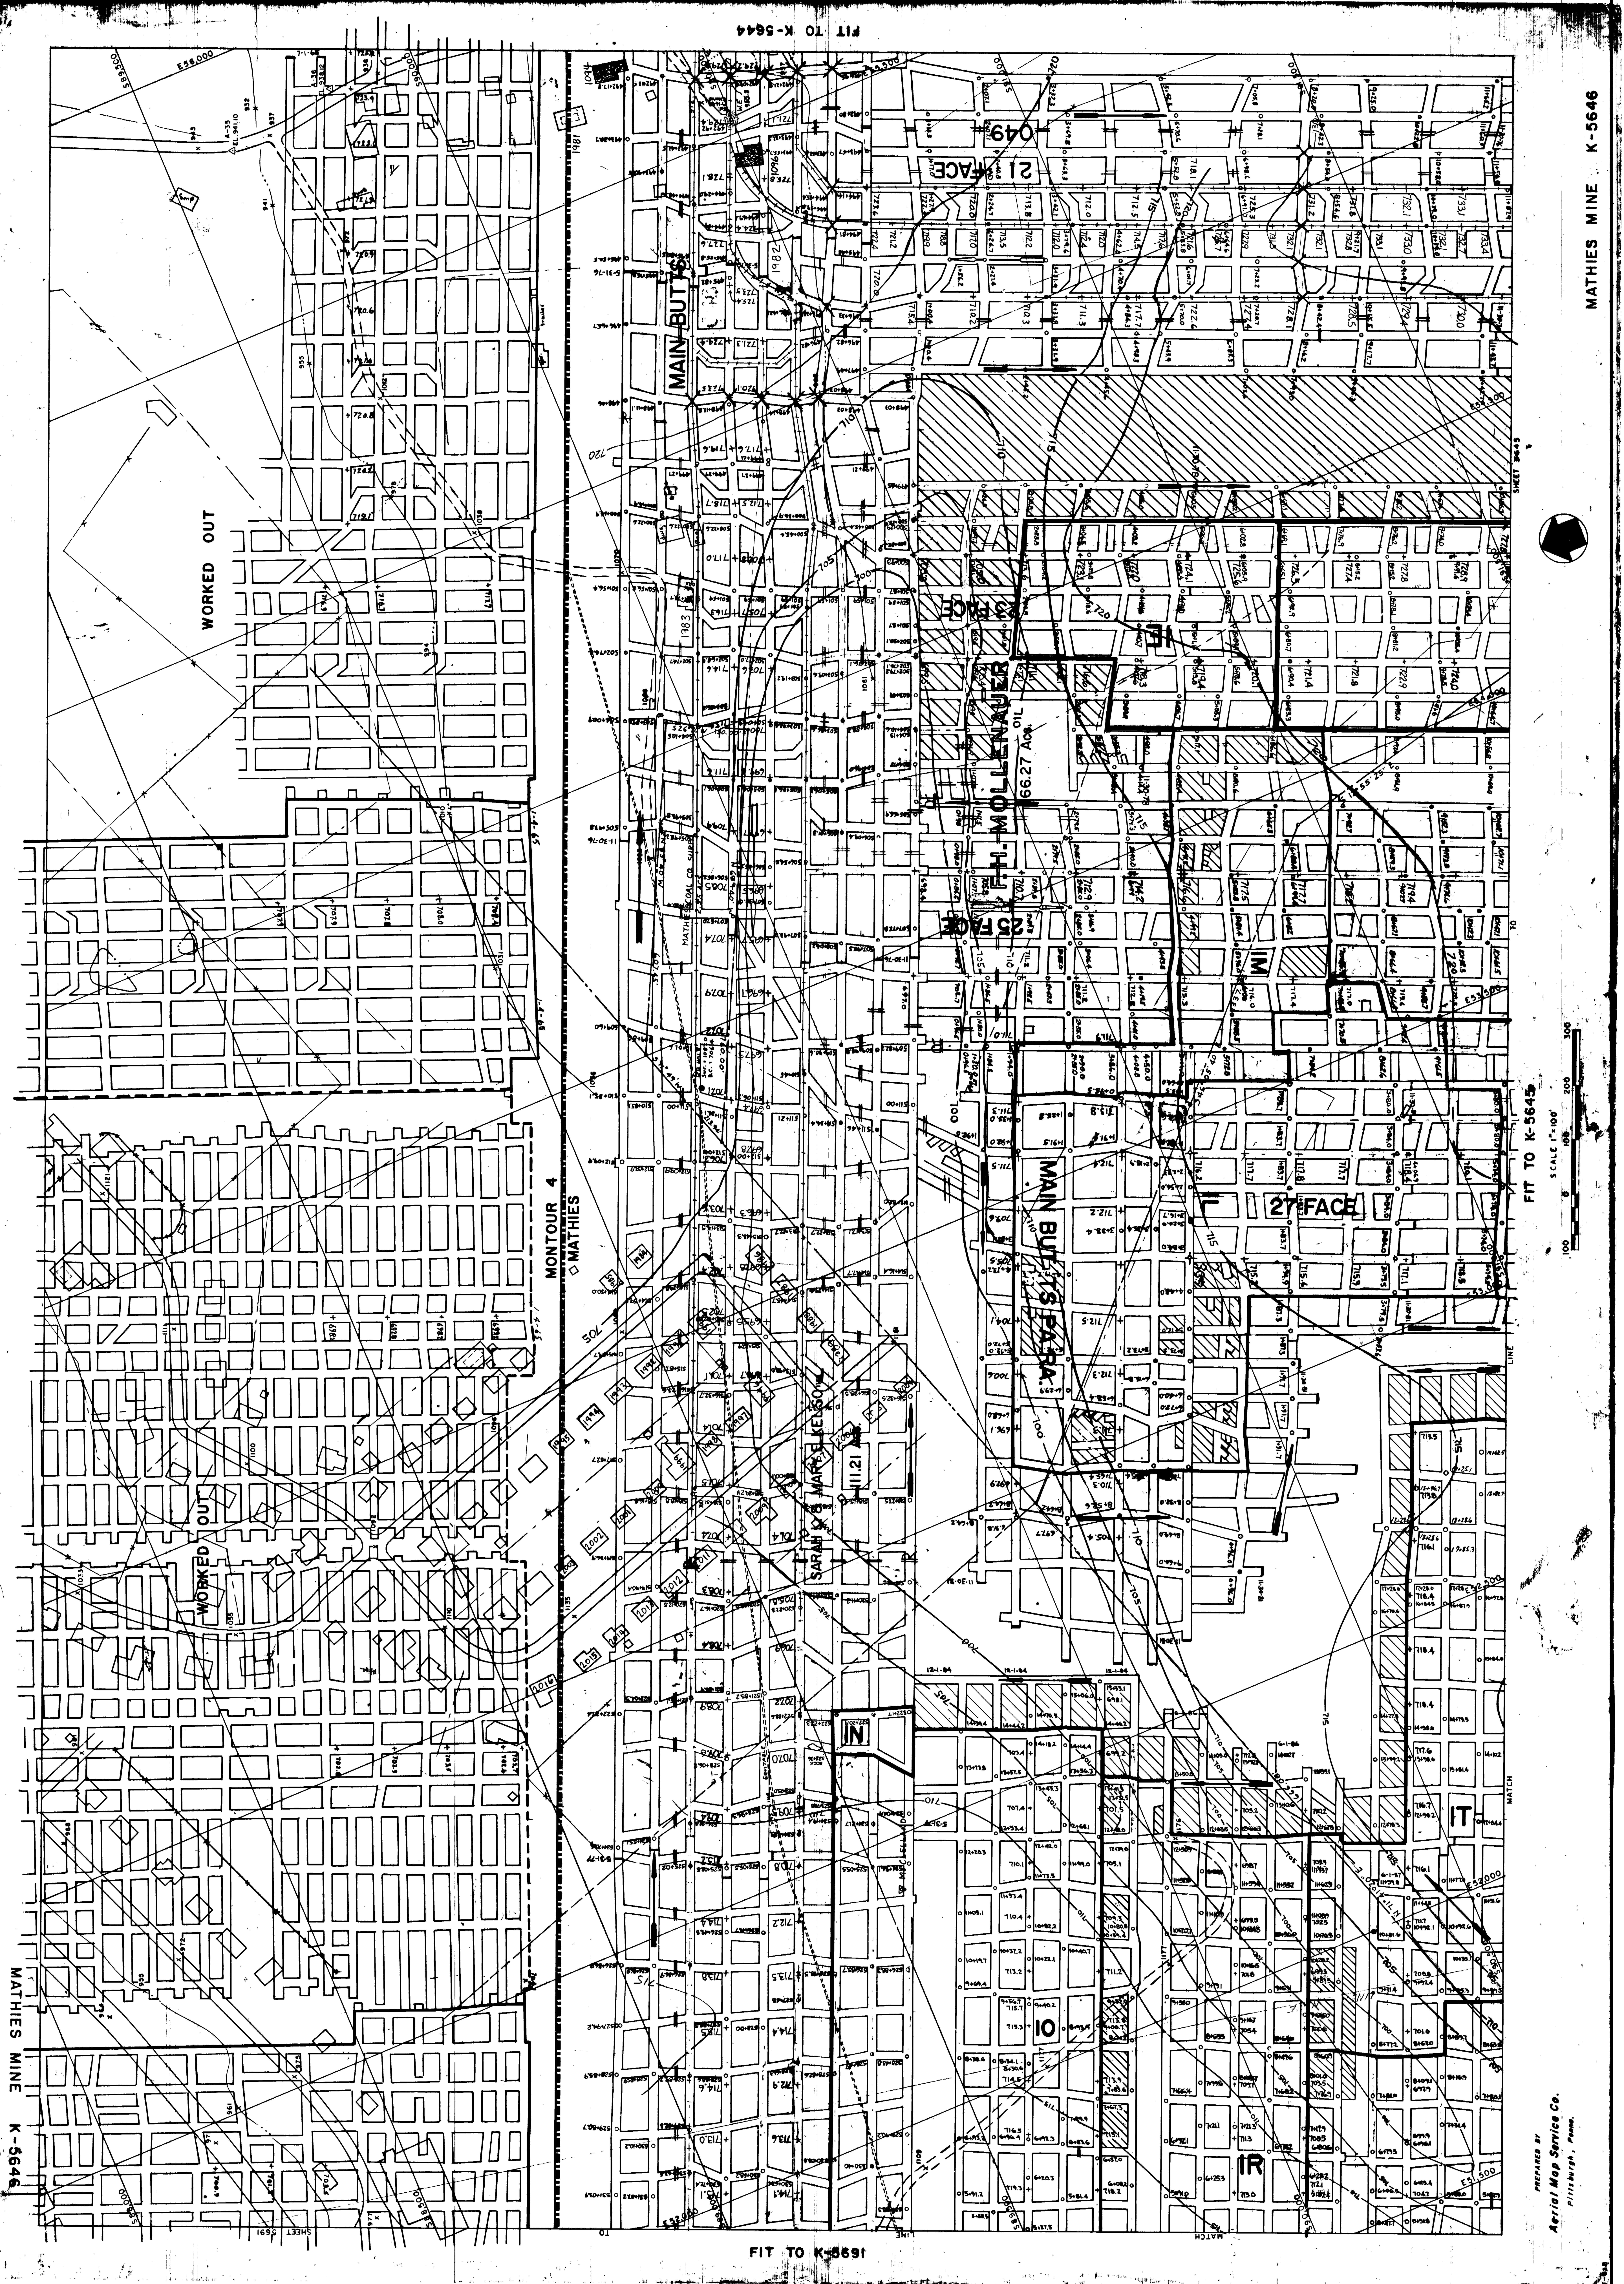

PREPARED BY
Aerial Map Service Co.
Pittsburgh, Penn.

FIT TO K-5691

MATHIES MINE K-5646