


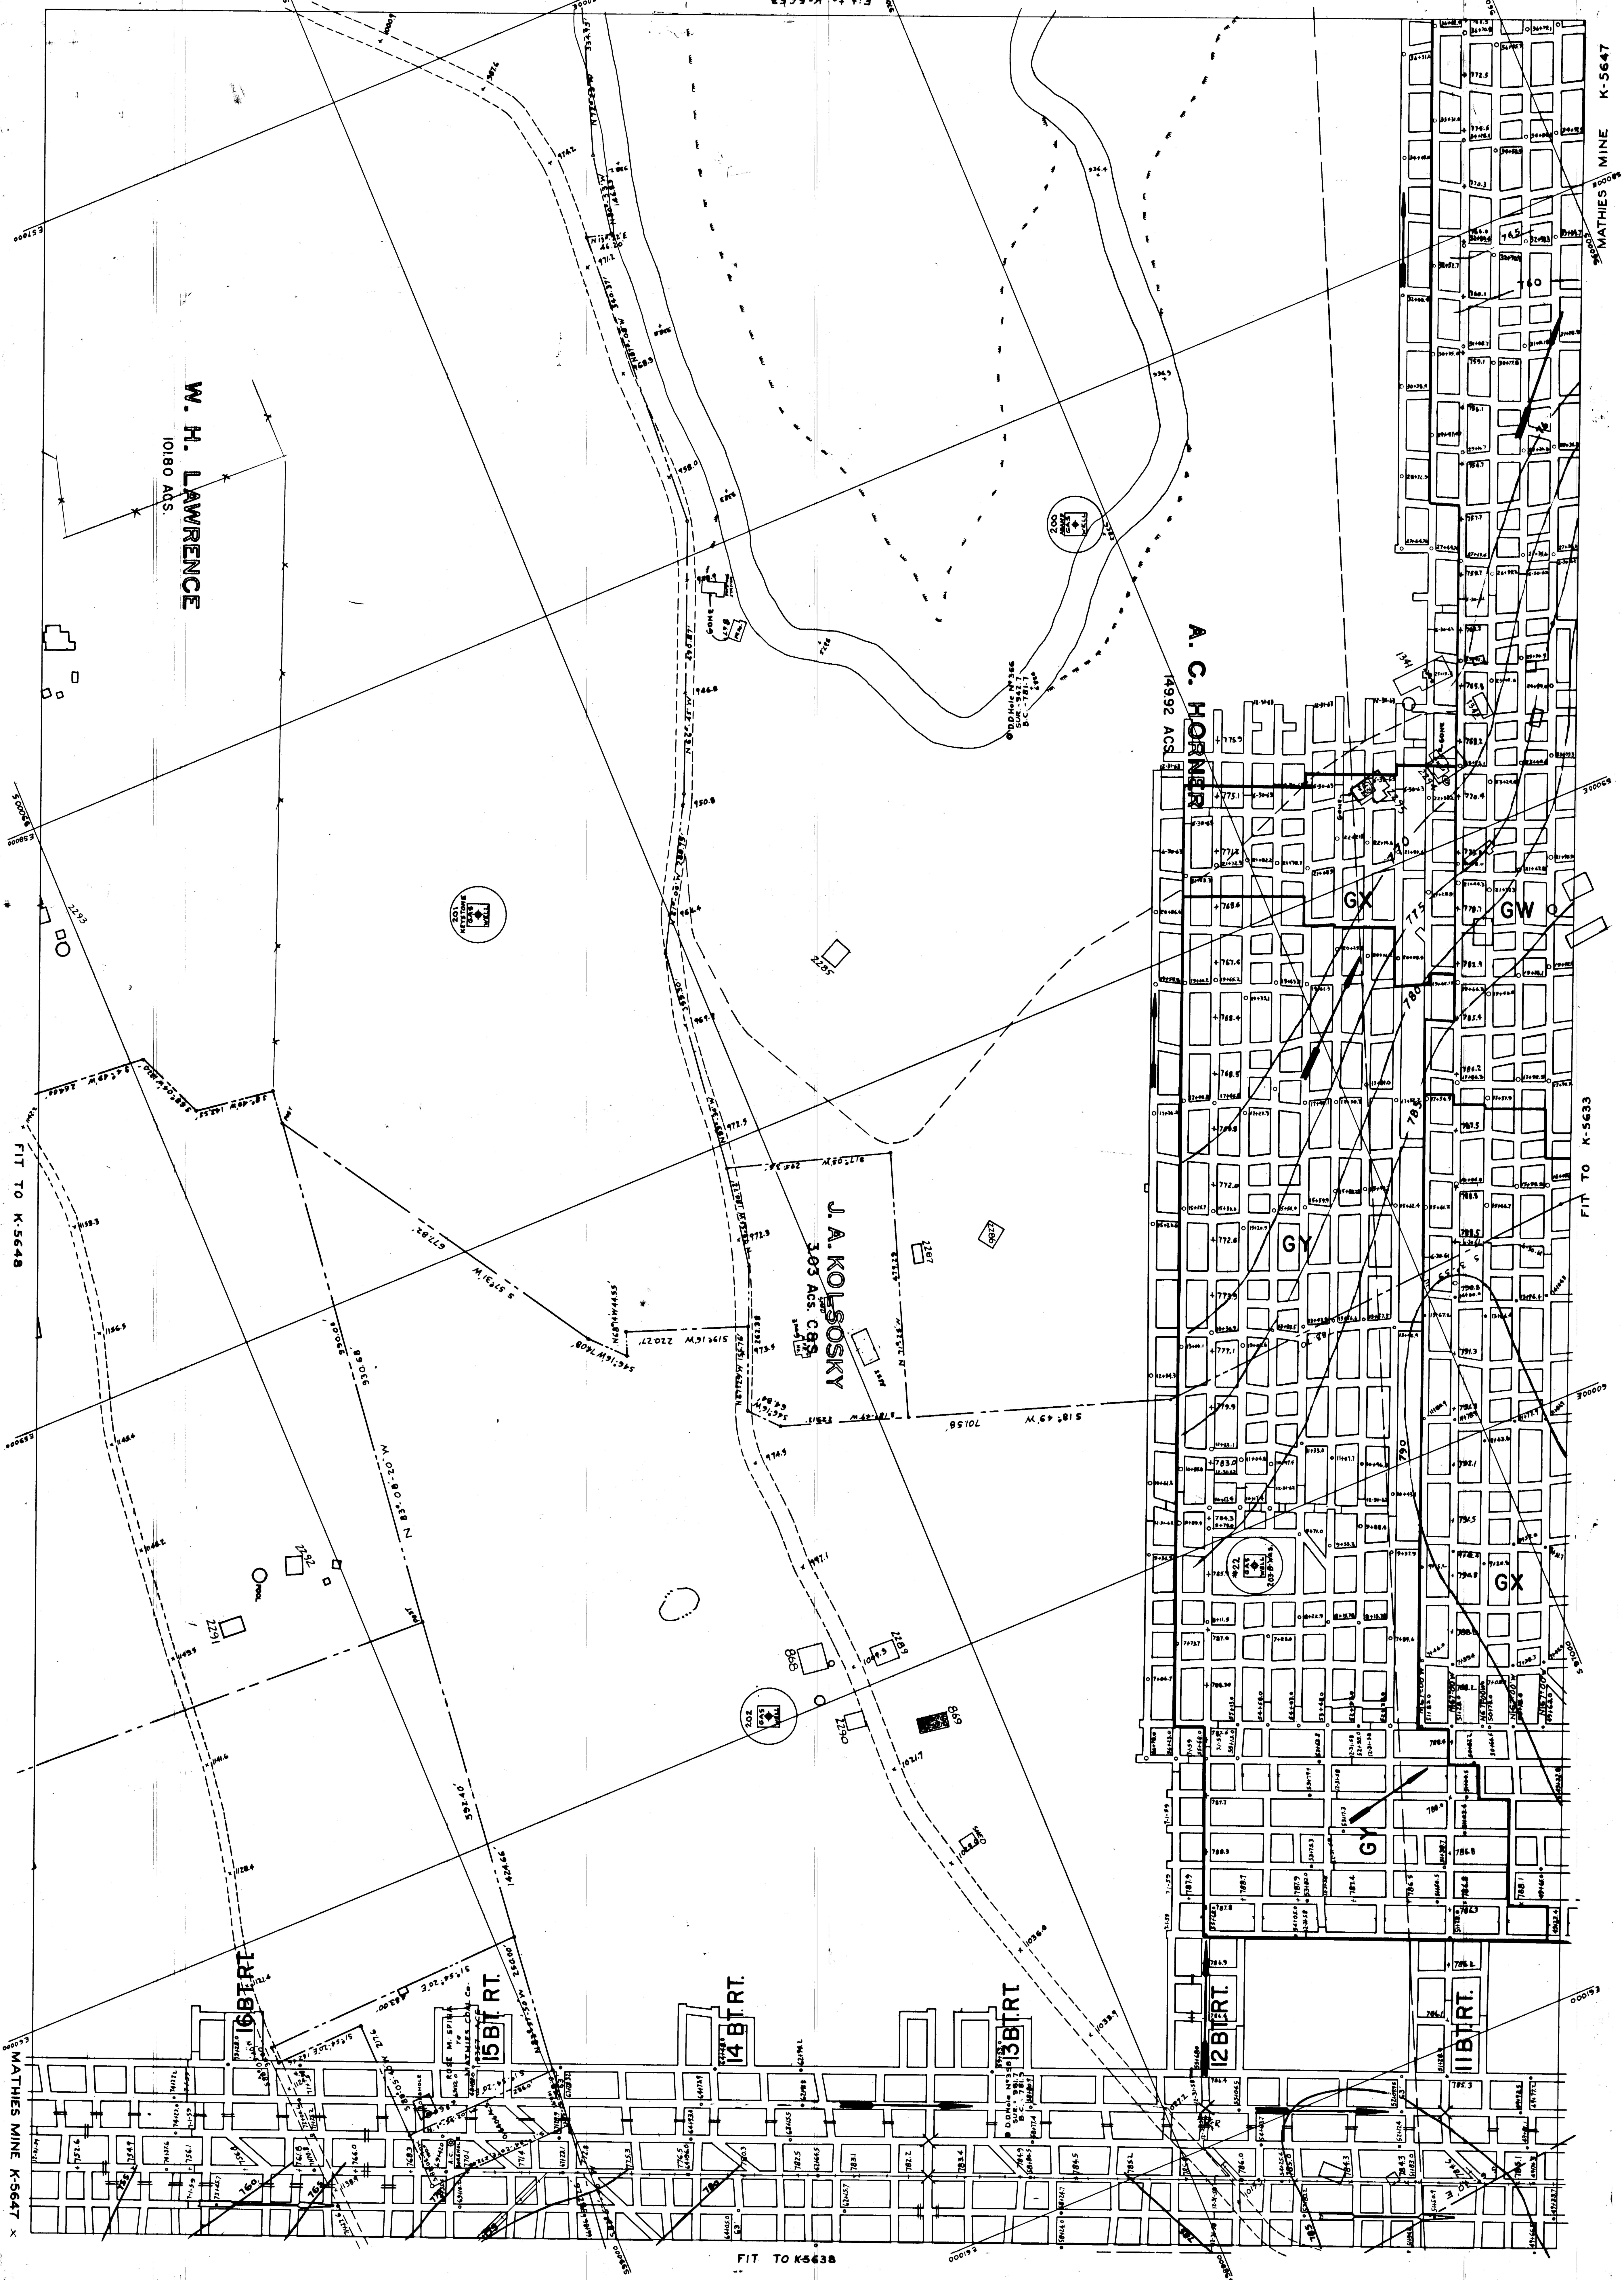

W. H. LAWRENCE
10180 ACS

303 ACS

A. C. HORNER
14992 ACS


MATHIES MINE K-5647

FIT TO K-5633

FIT TO K-5638