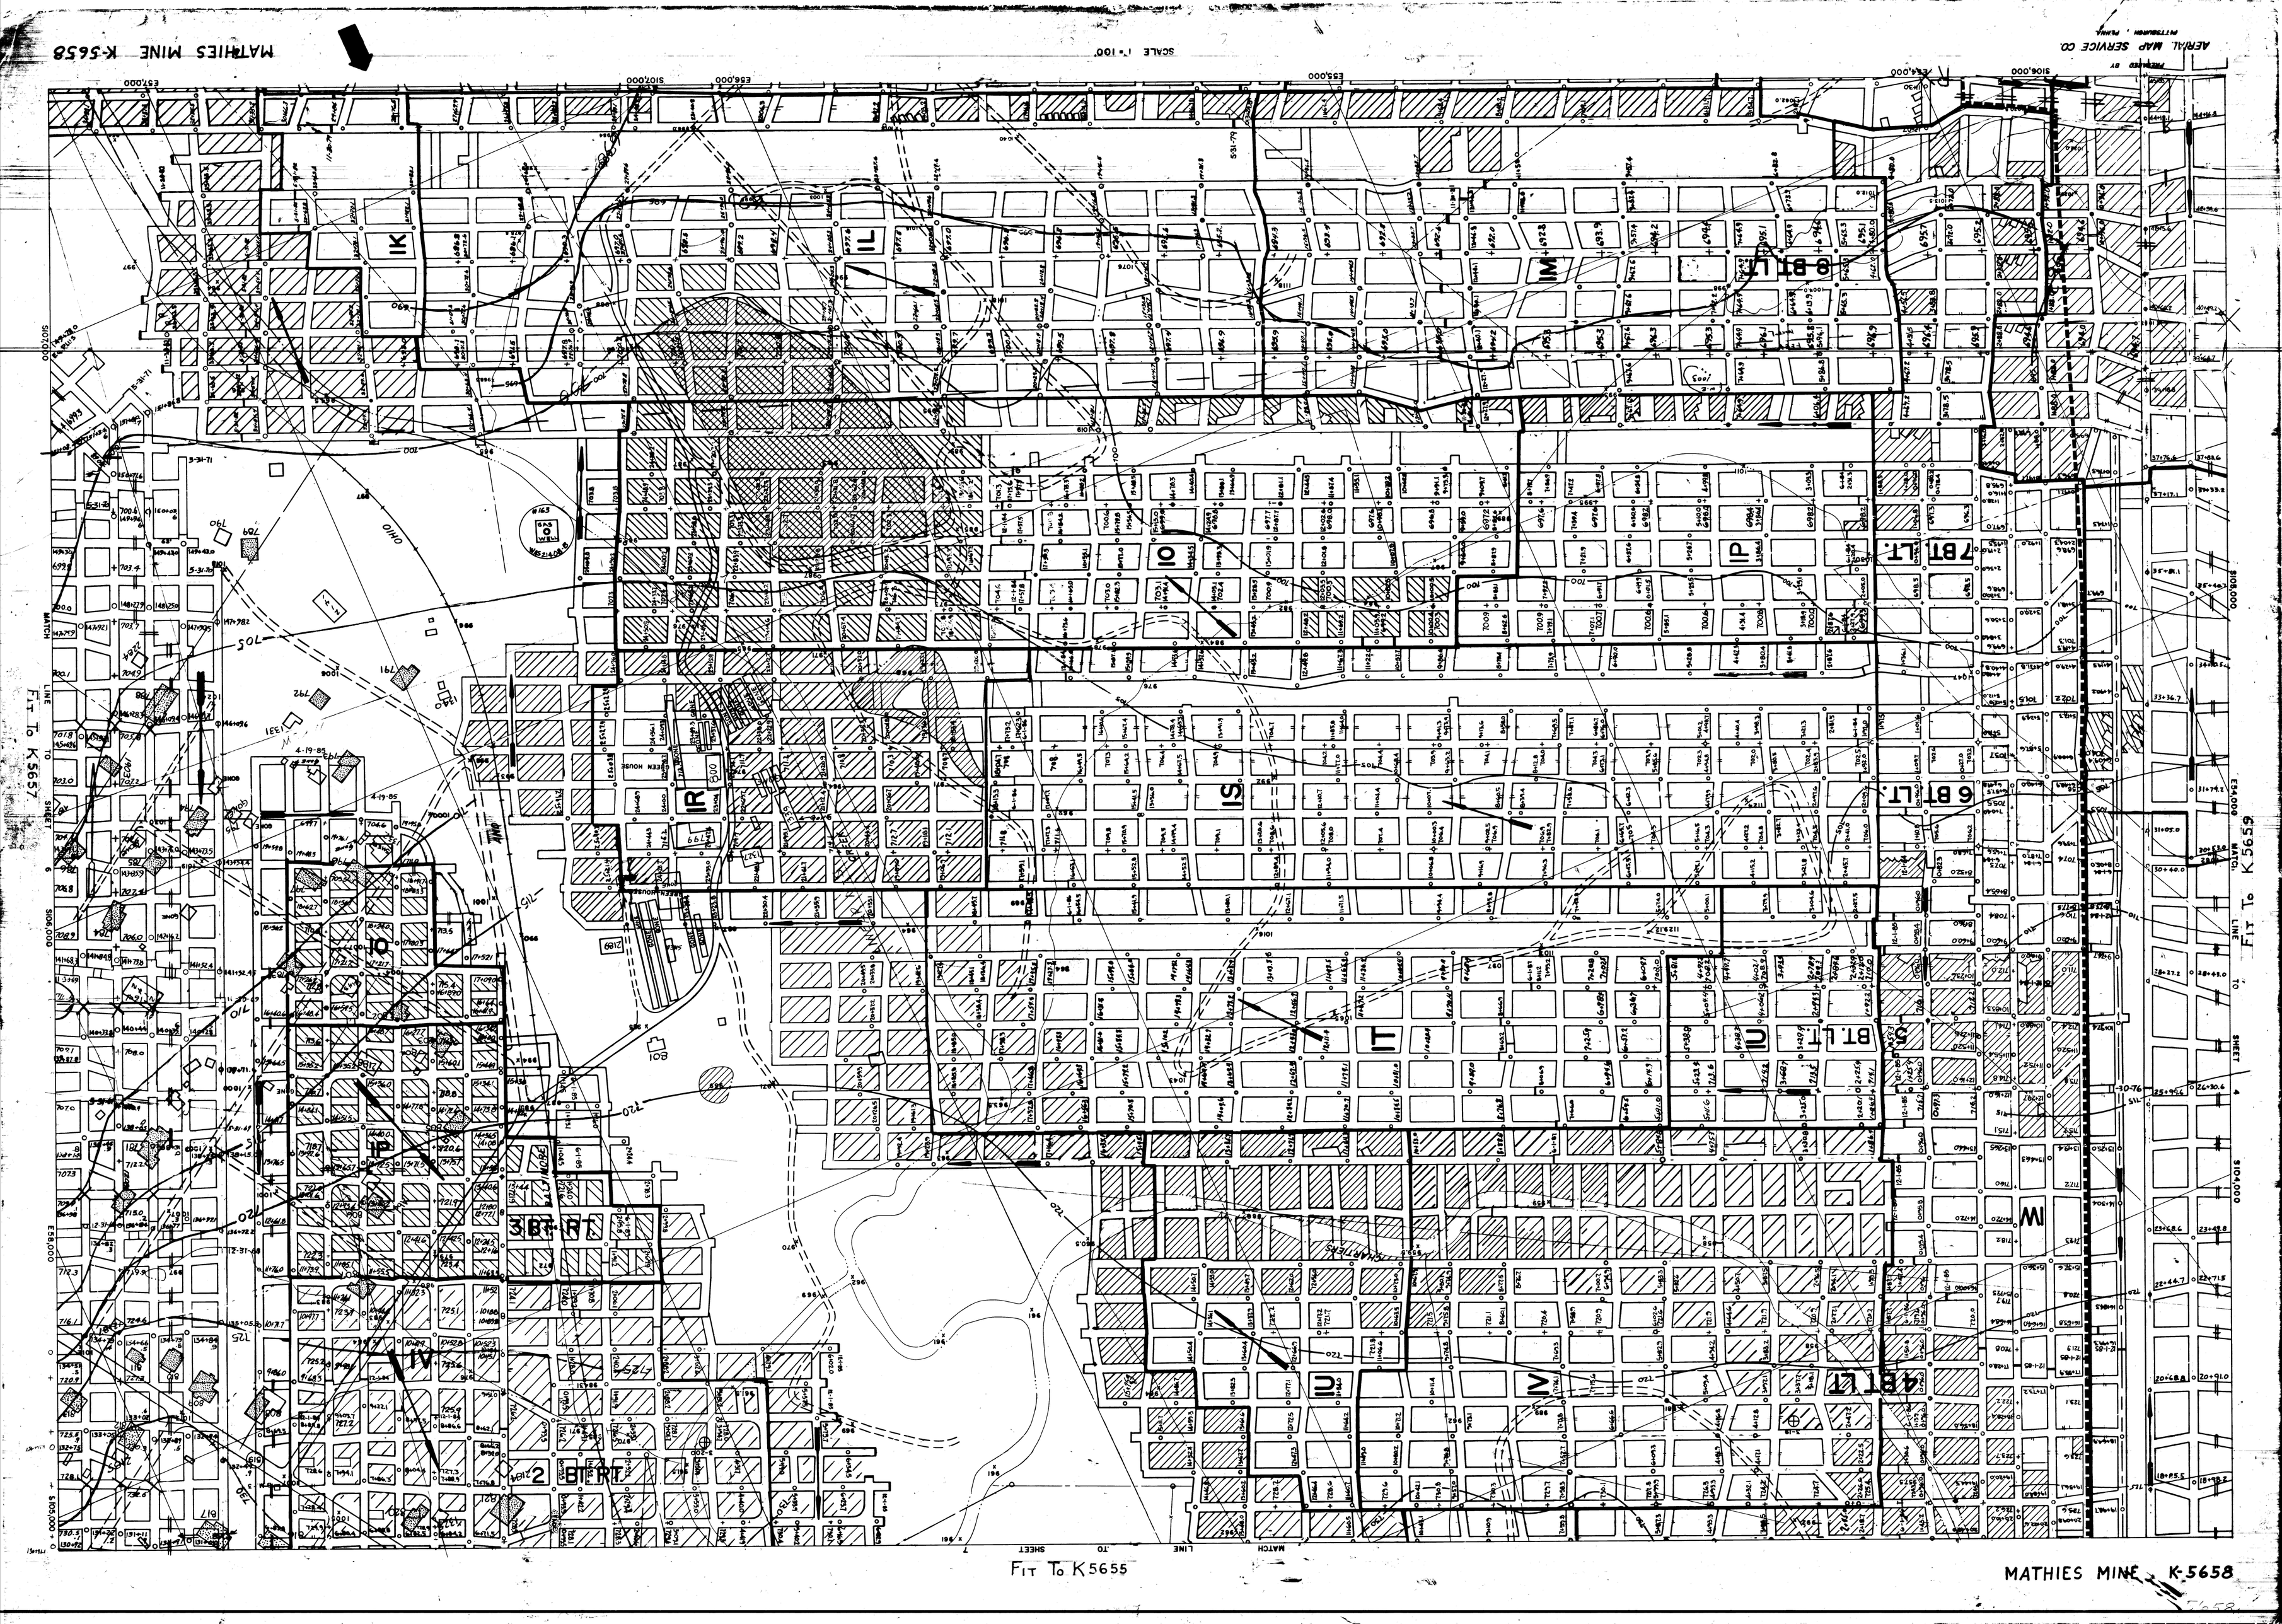
MATHIES MINE K-5658
SCALE 1"=100'
AERIAL MAP SERVICE CO.
PITTSBURGH, PENNA.
FIT TO K5657
FIT TO K5659
FIT TO K5655
MATCH LINE TO SHEET 6
MATCH LINE TO SHEET 7
MATCH LINE TO SHEET 4
IK
IL
IM
IO
IP
IR
IS
IT
IU
IV
IW
8 BT LT
7 BT LT
6 BT LT
5 BT LT
4 BT LT
3 BT RT
2 BT RT
OHIO
GREEN HOUSE
CHARTERS
MATHIES MINE K-5658