


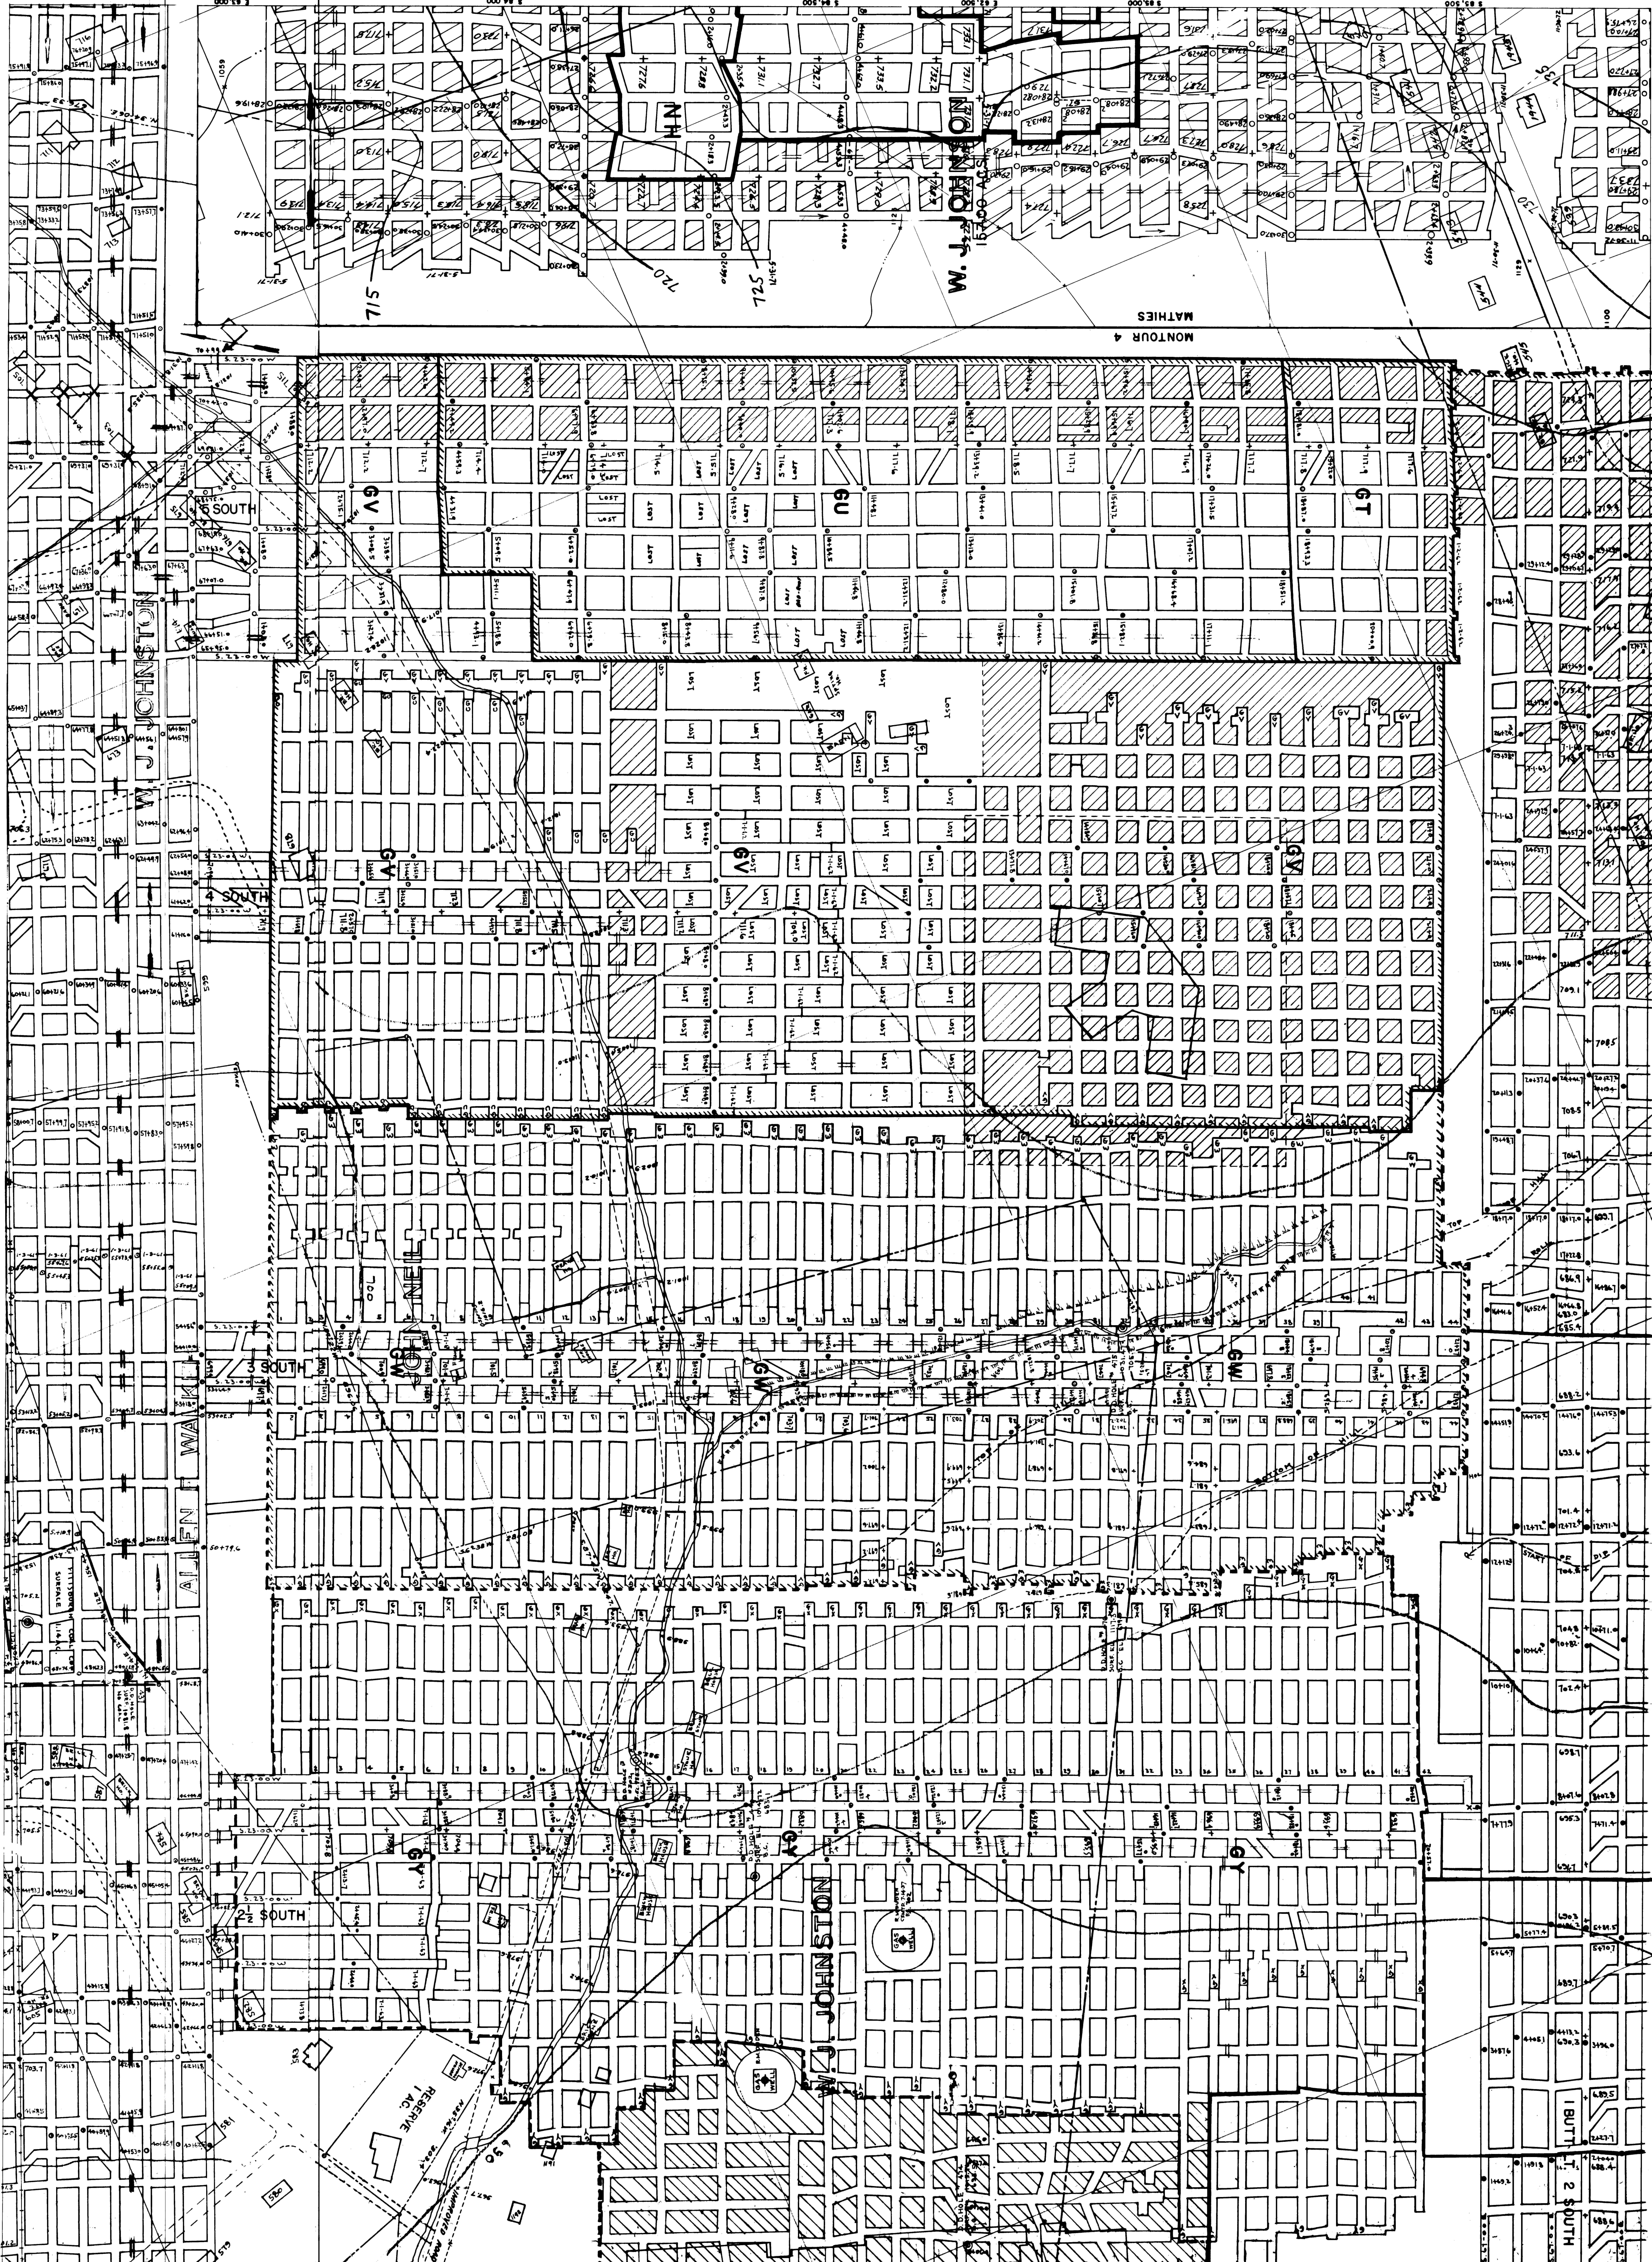

FIT TO K-5642

FIT TO K-5665

MATHIES MINE K-5664