


FIT TO K-5667

K-5667

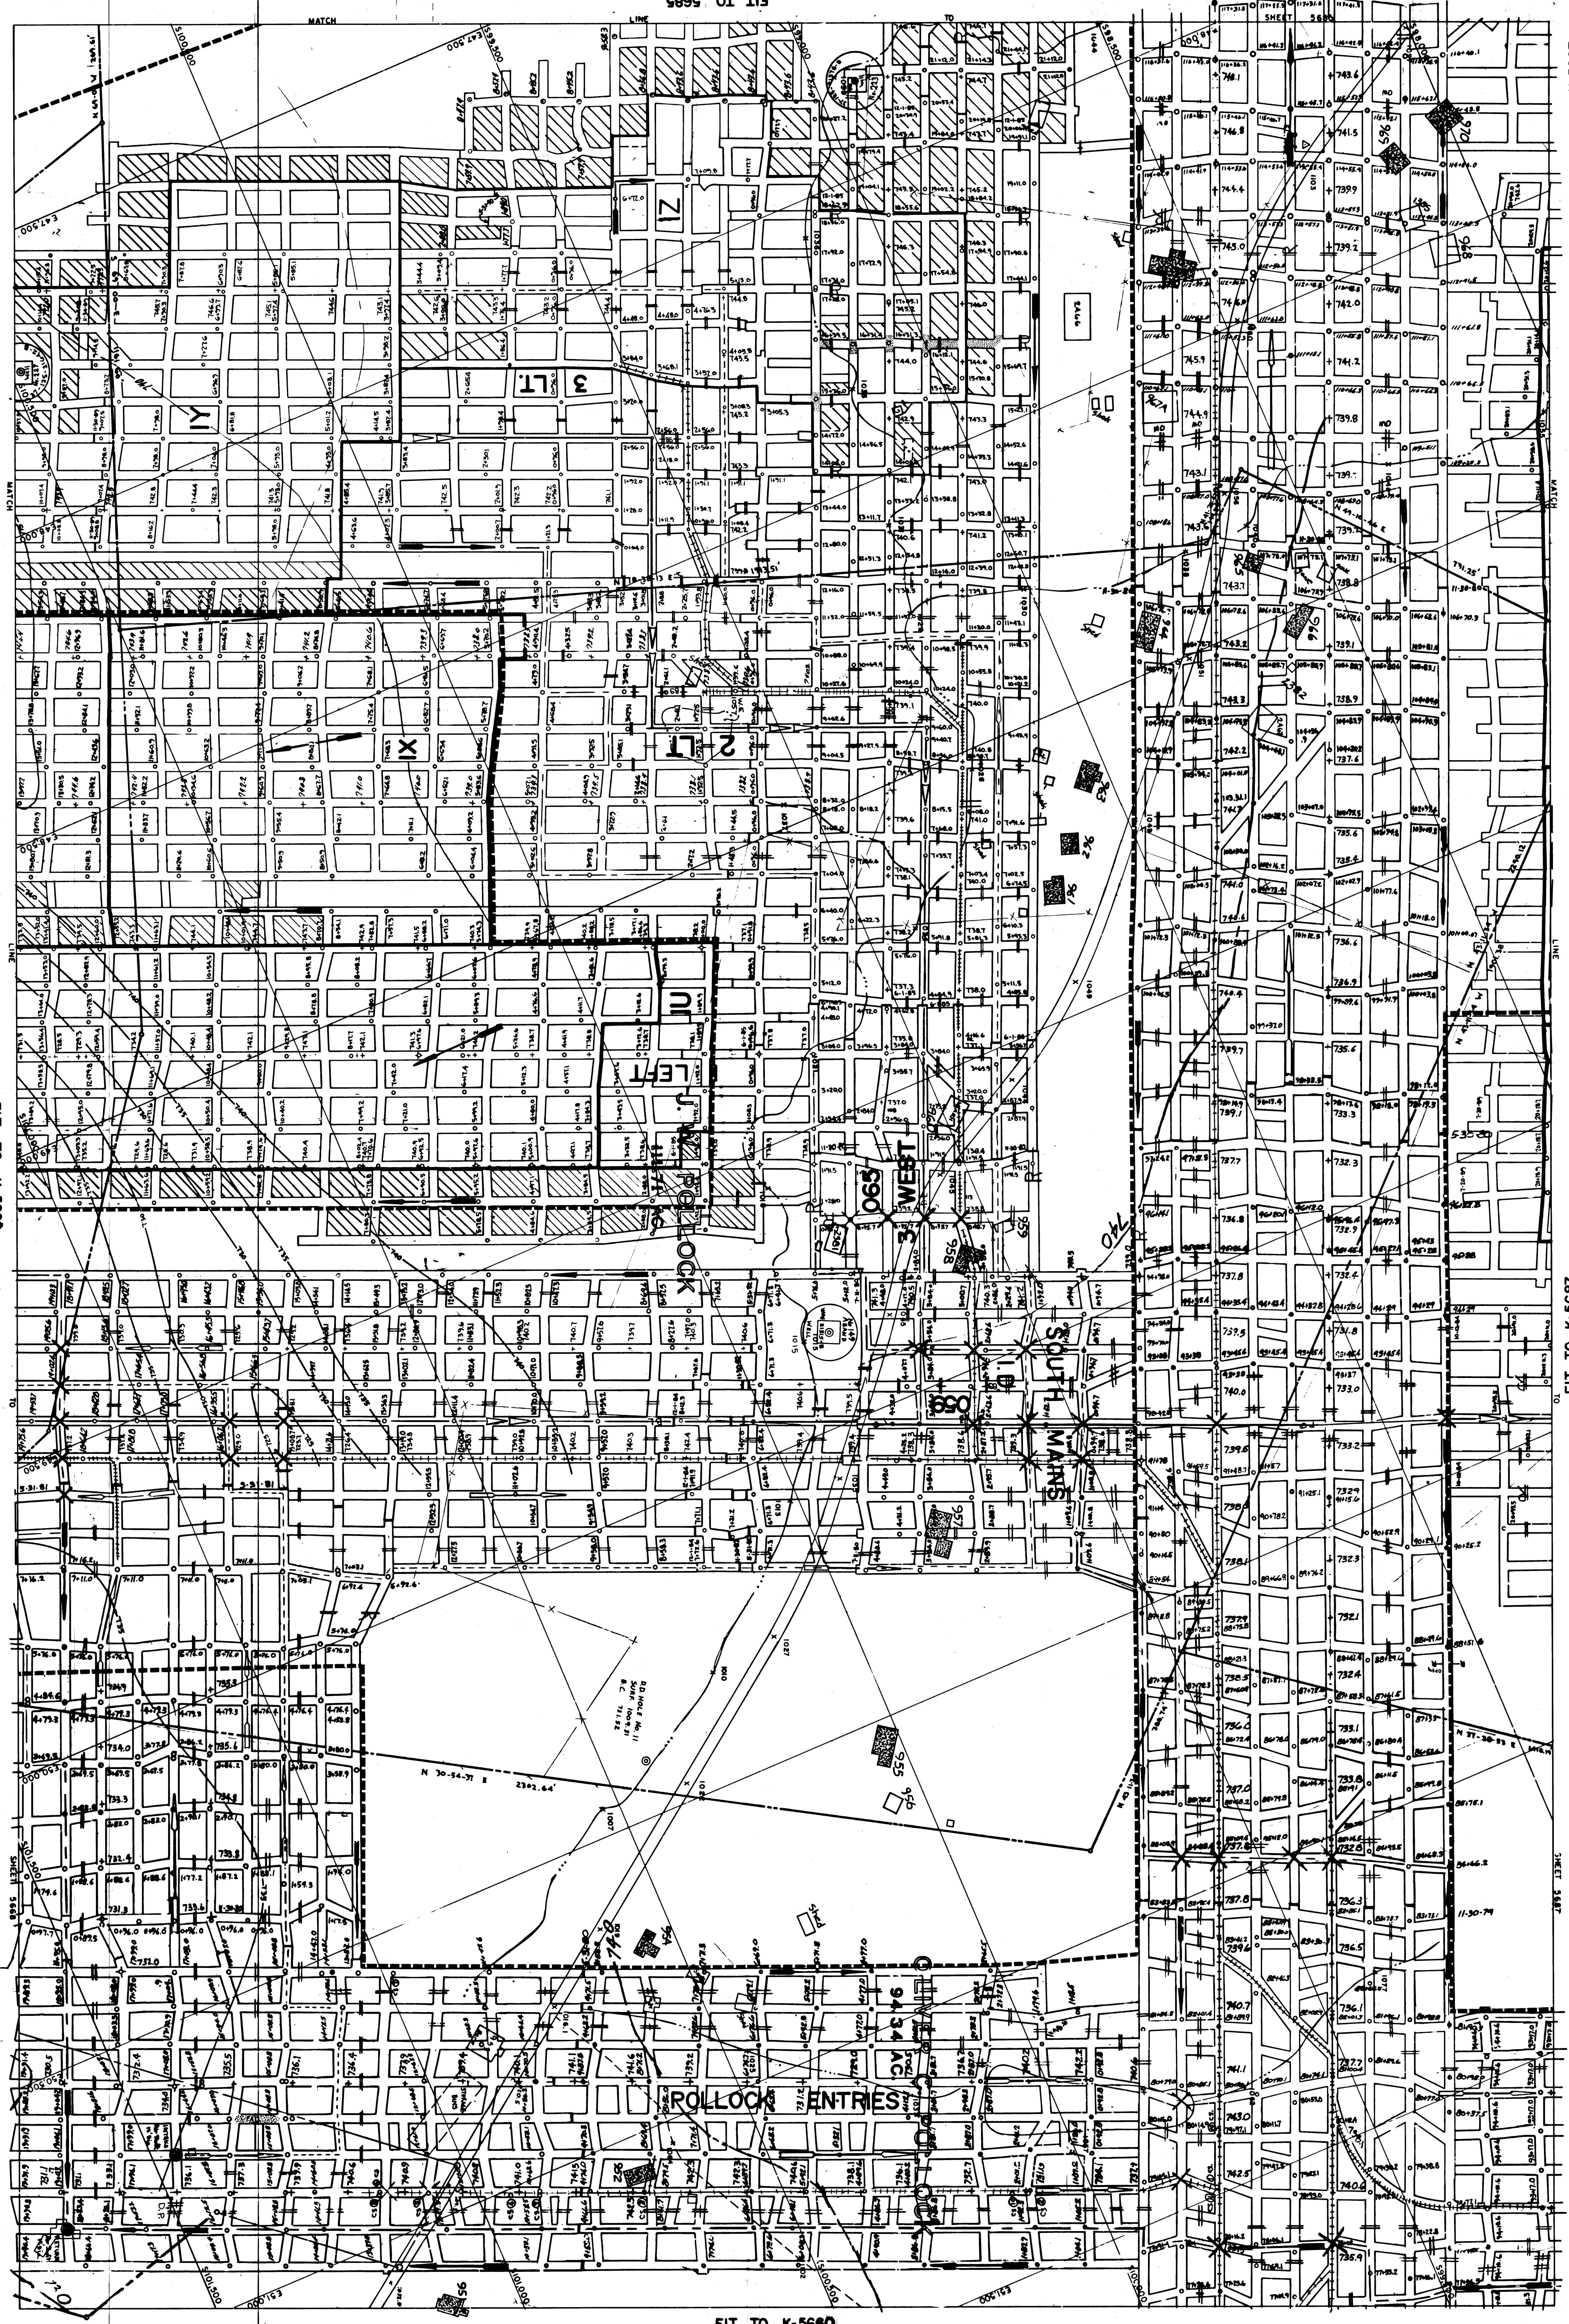

K-5667

FIT TO K-5687

SHEET 5667

5667