

MATCH

LINE

TO

SHEET

FIT TO K-5673

TO FIT TO K-5679

SHEET

LINE

MATCH

514.000







FIT TO K-5677

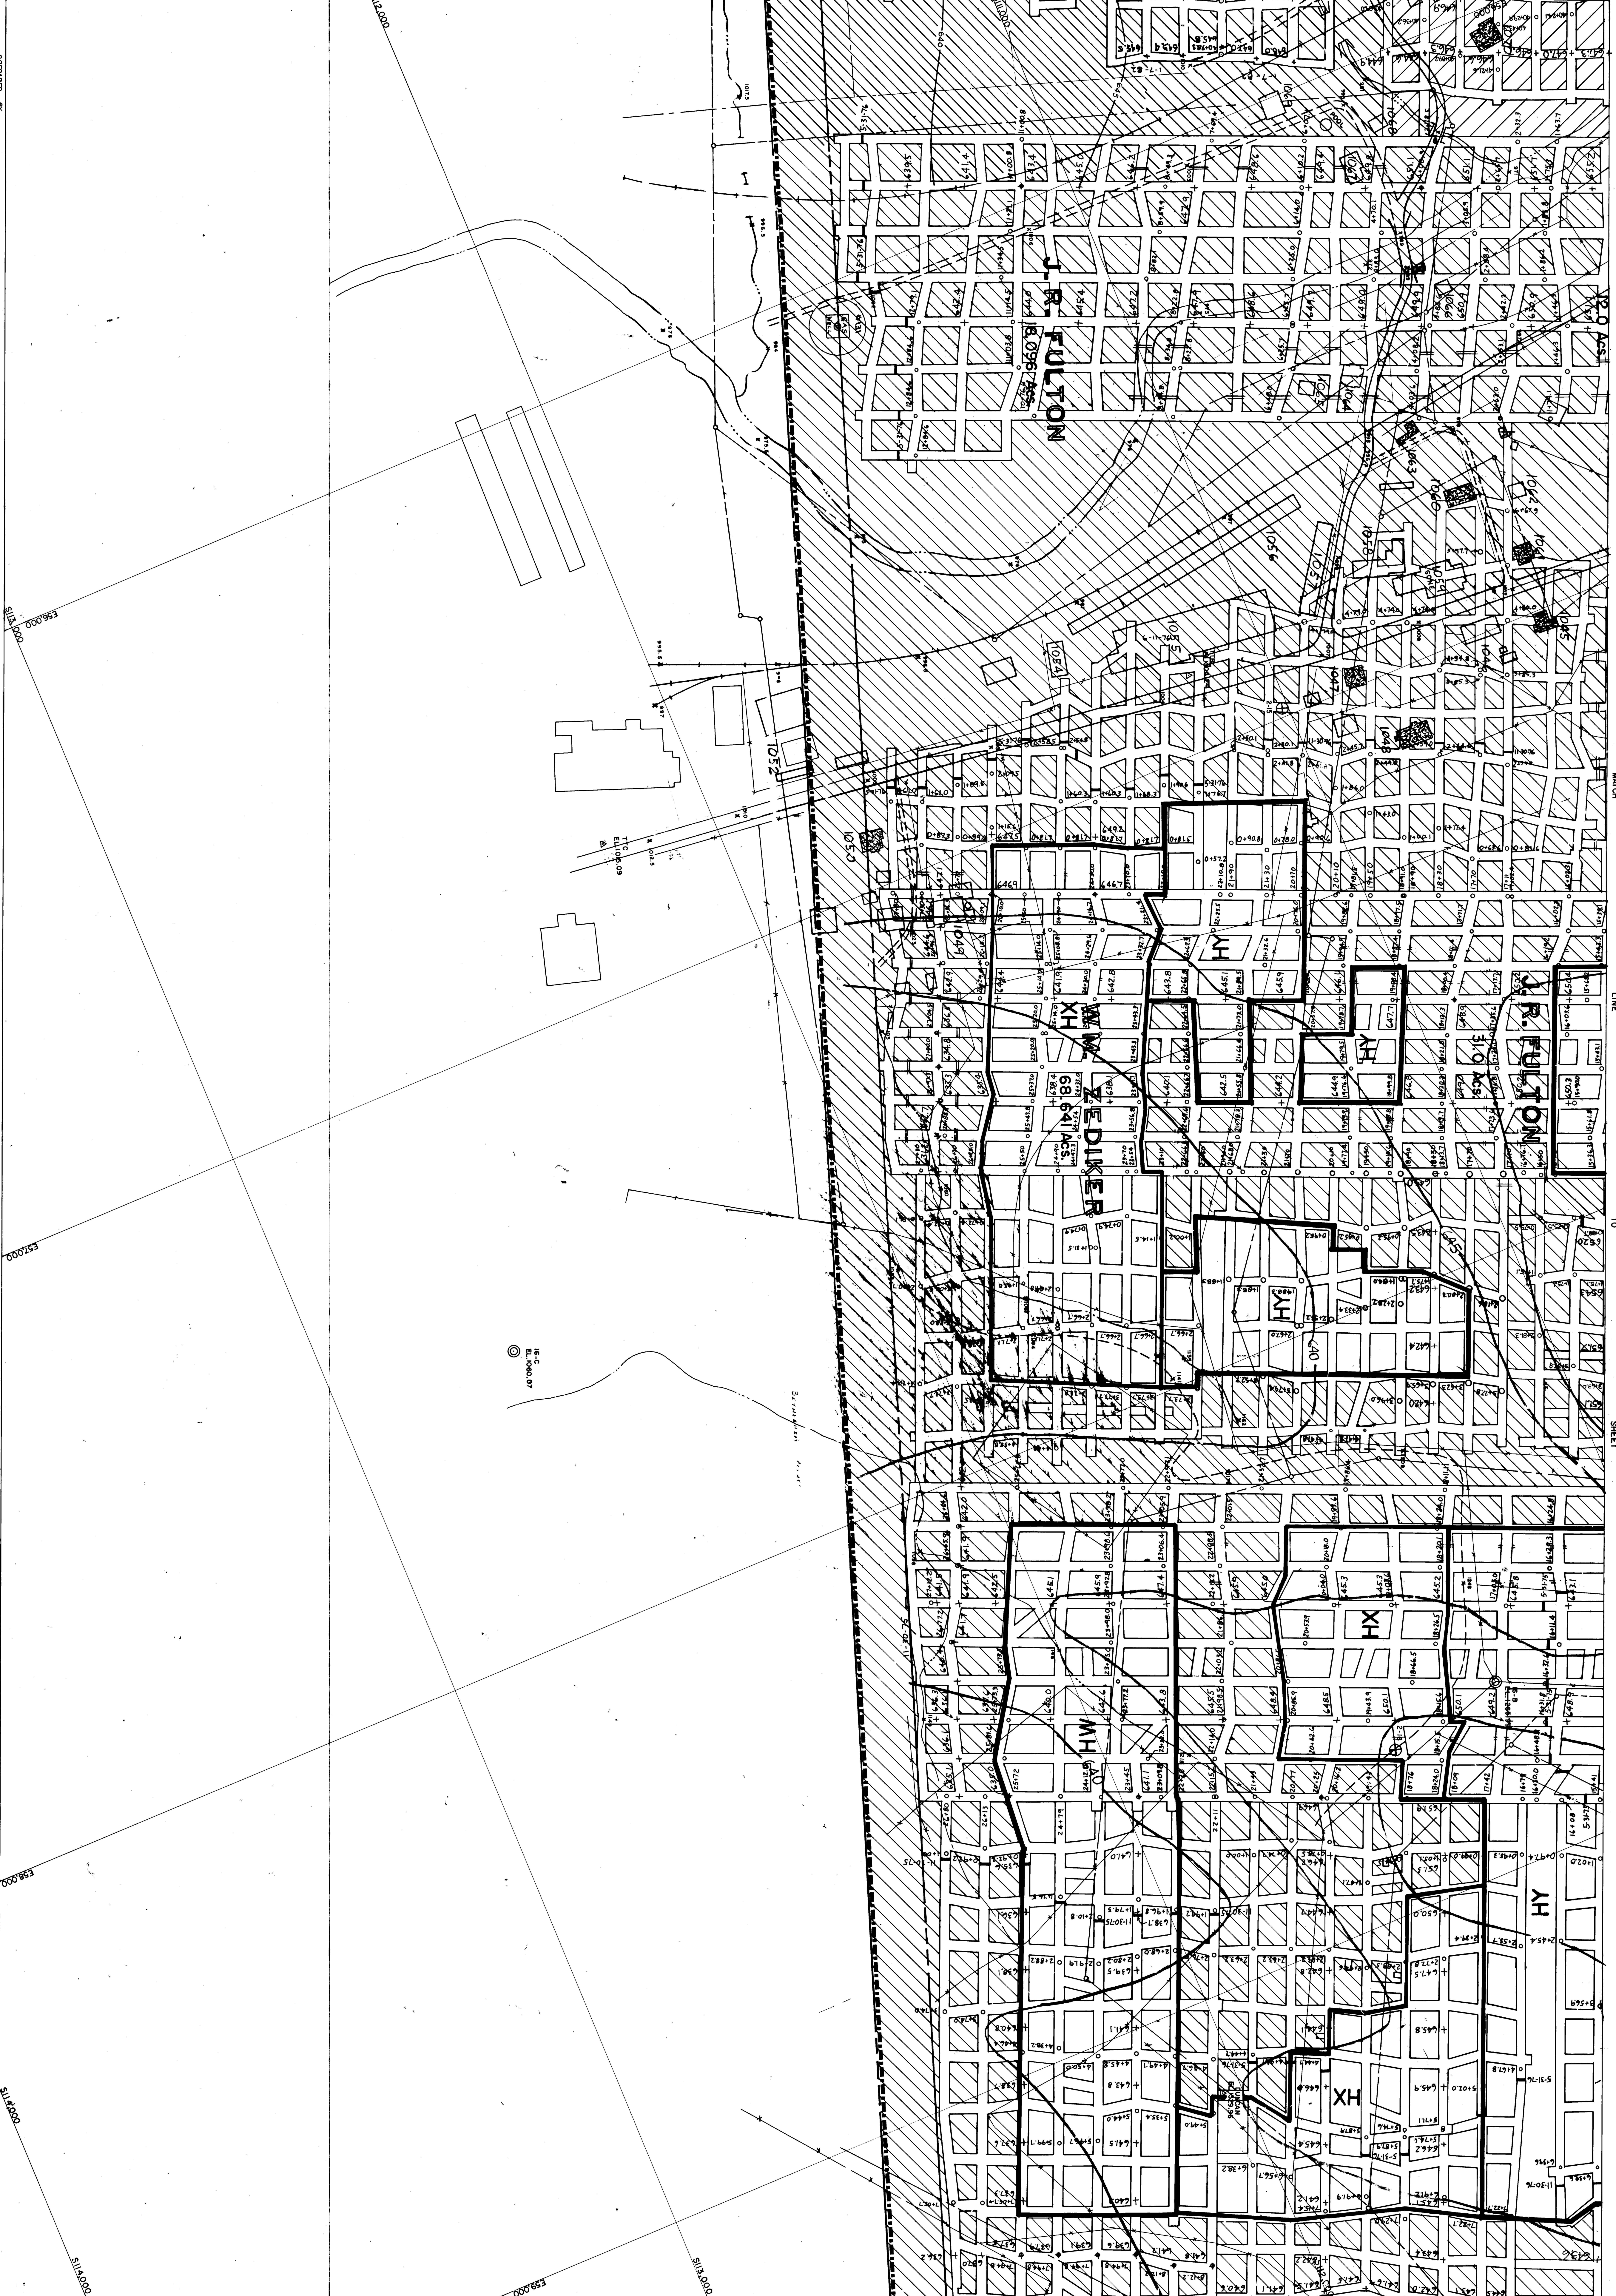

PREPARED BY

AERIAL MAP SERVICE CO.

PITTSBURGH, PENNA.

SCALE 1"=100'

SHEET OF