


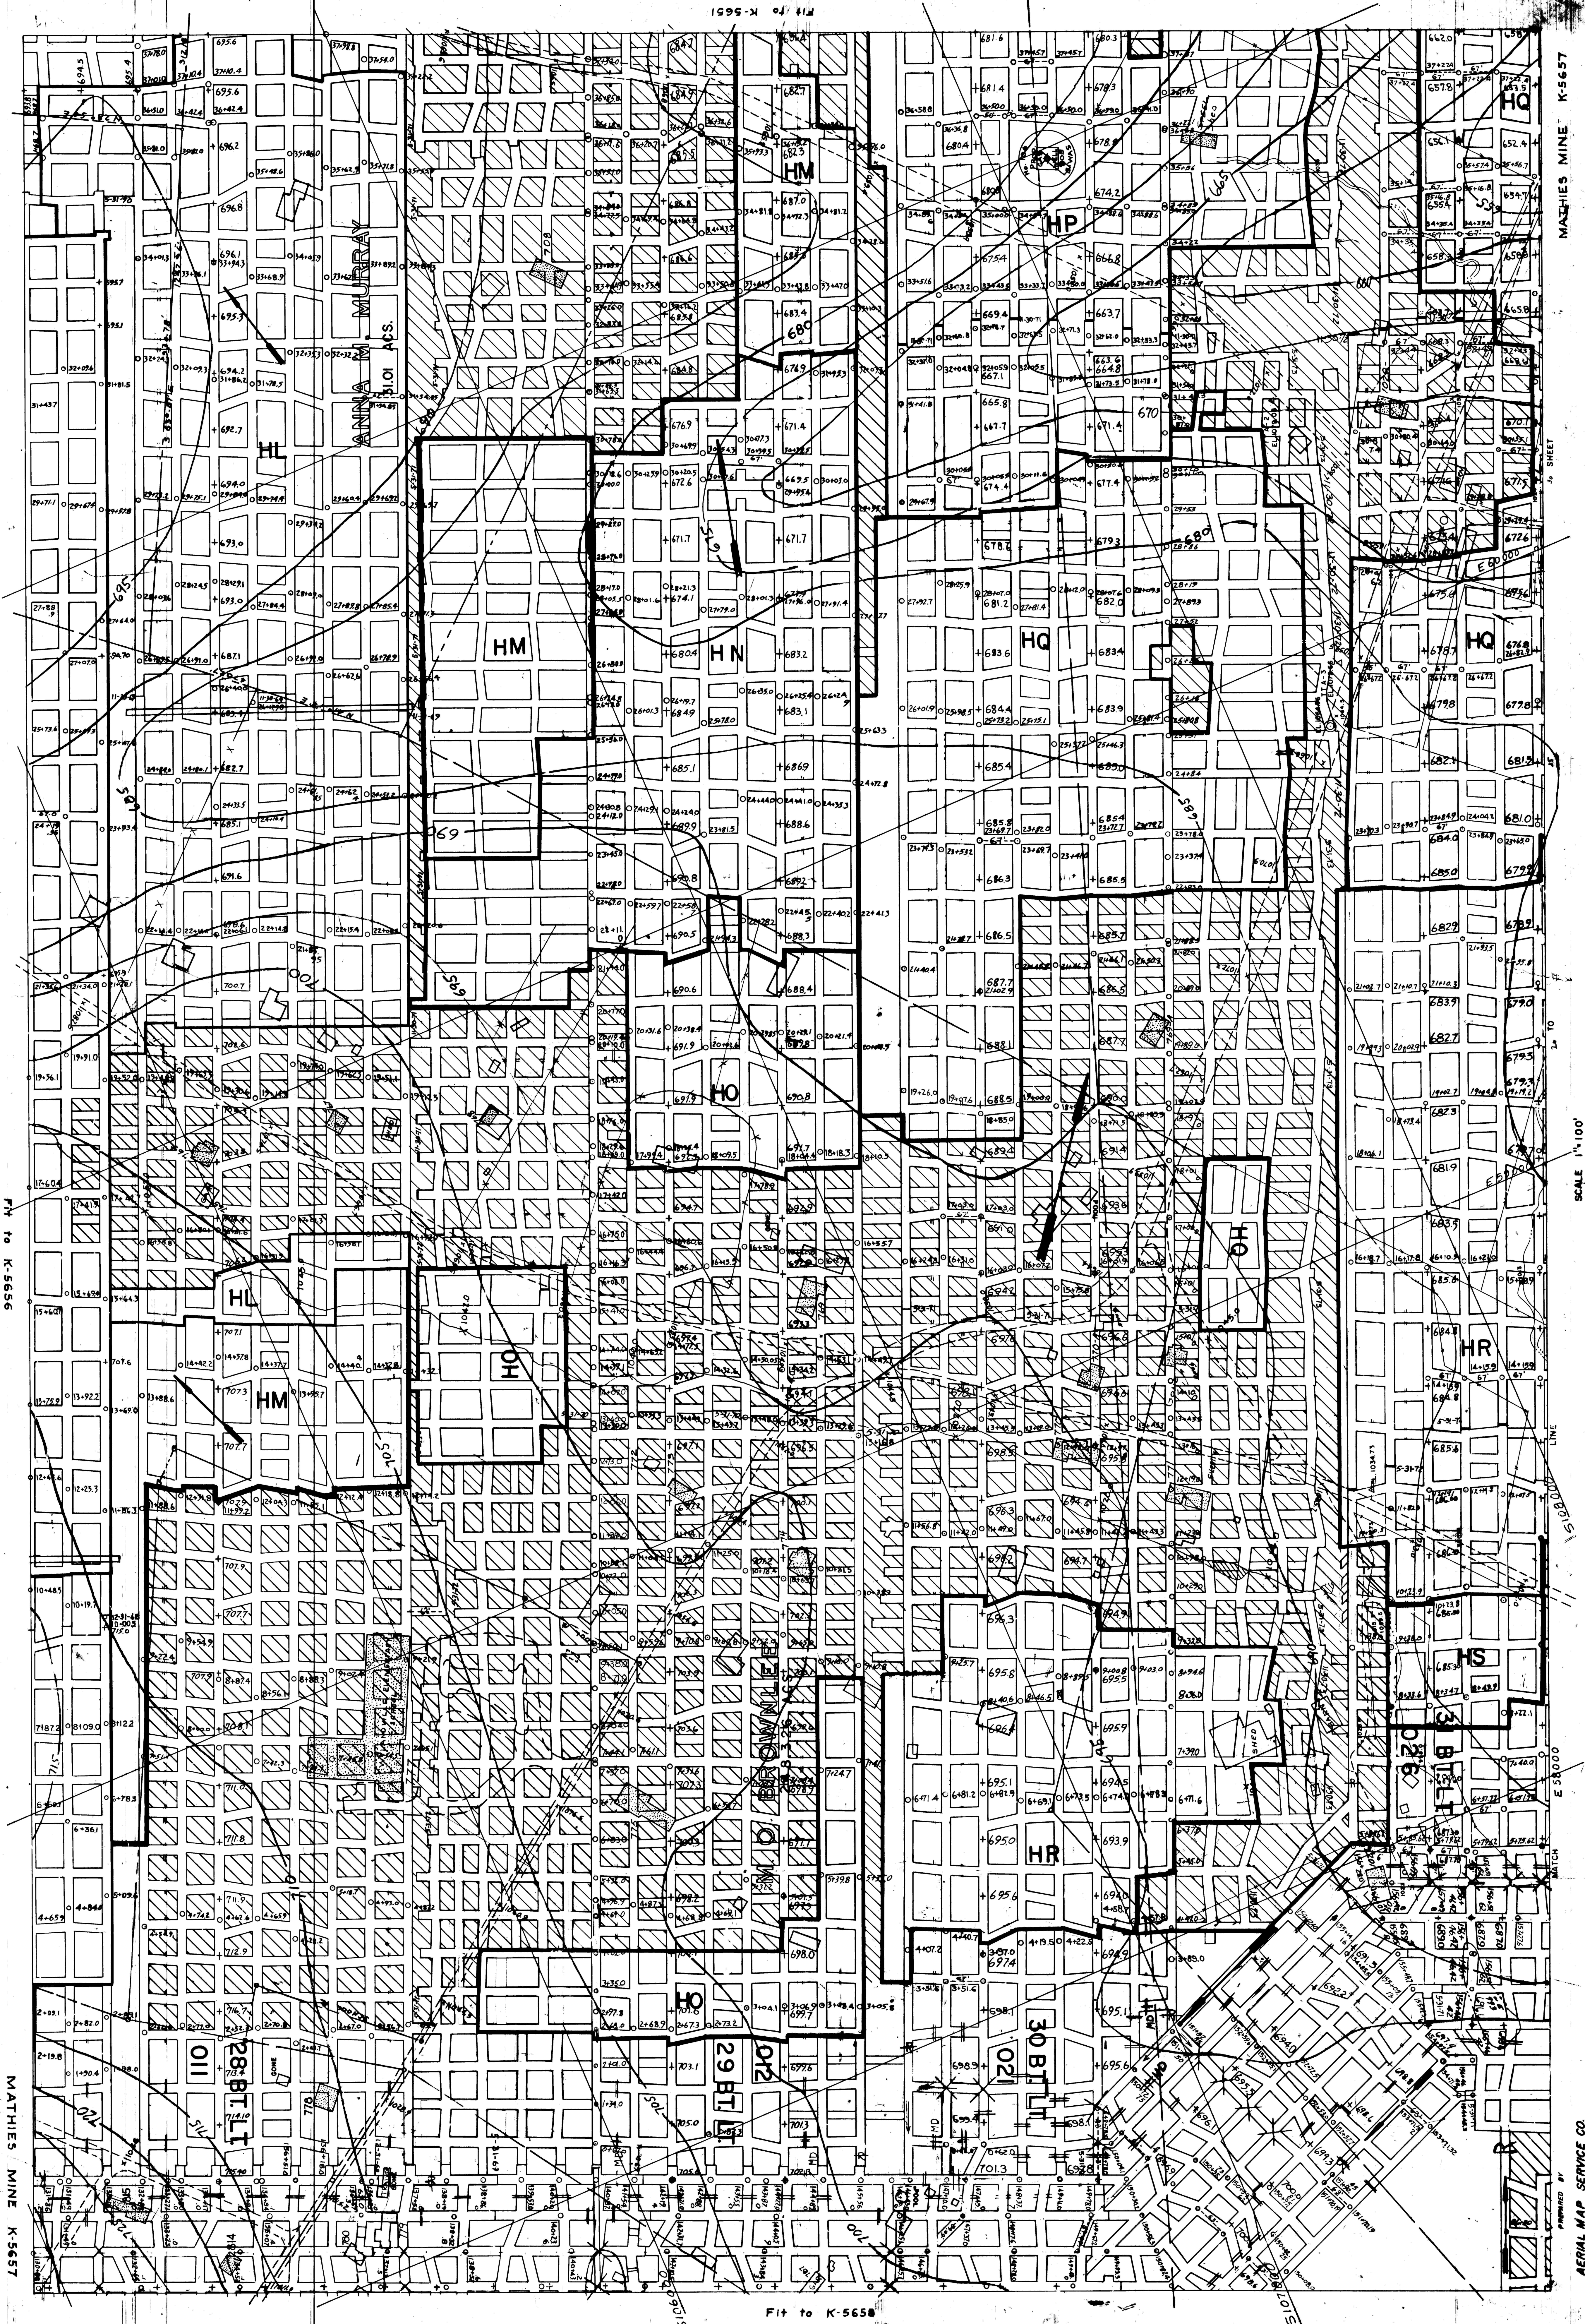

Fit to K-5656

MATHIES MINE K-5657

Fit to K-5658