


SHEET 5682

FIT TO K-5682

MATCH

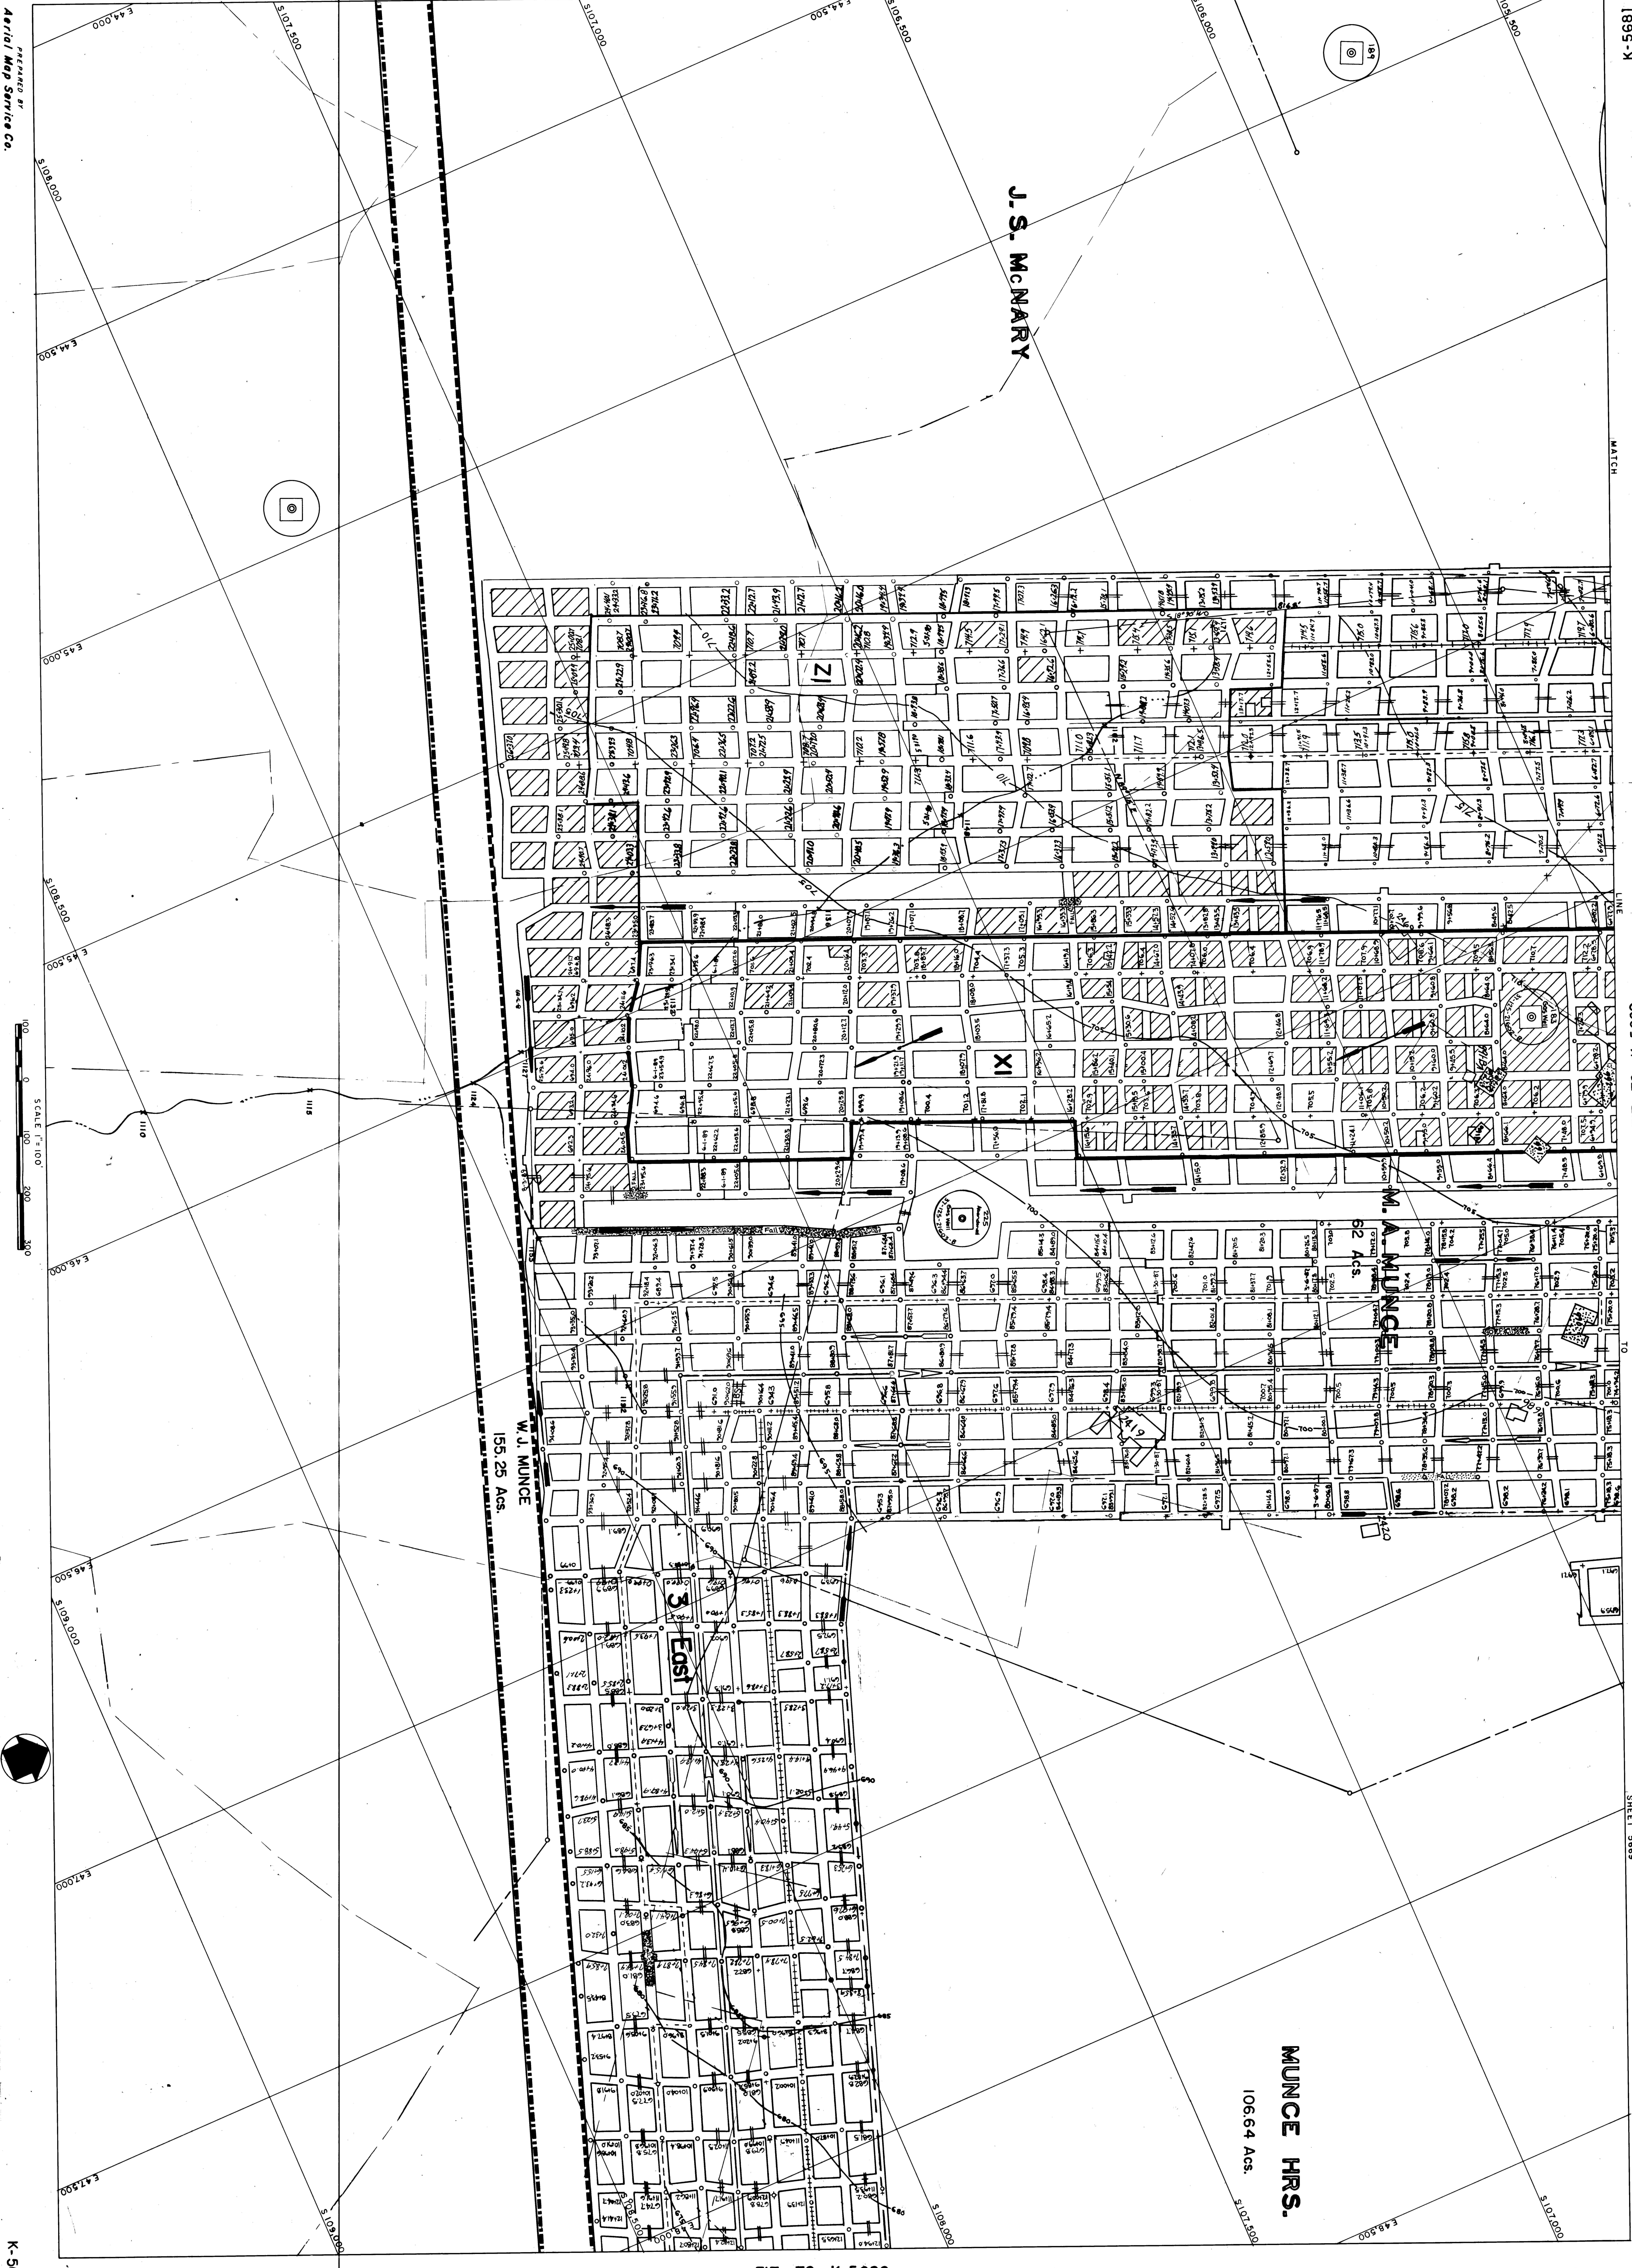

J.S. McNARY

MUNCE HRS.
106.64 Acs.

W.J. MUNCE
155.25 Acs.

East

PREPARED BY
Aerial Map Service Co.
Pittsburgh, Penna.

K-5681

FIT TO K-5680