


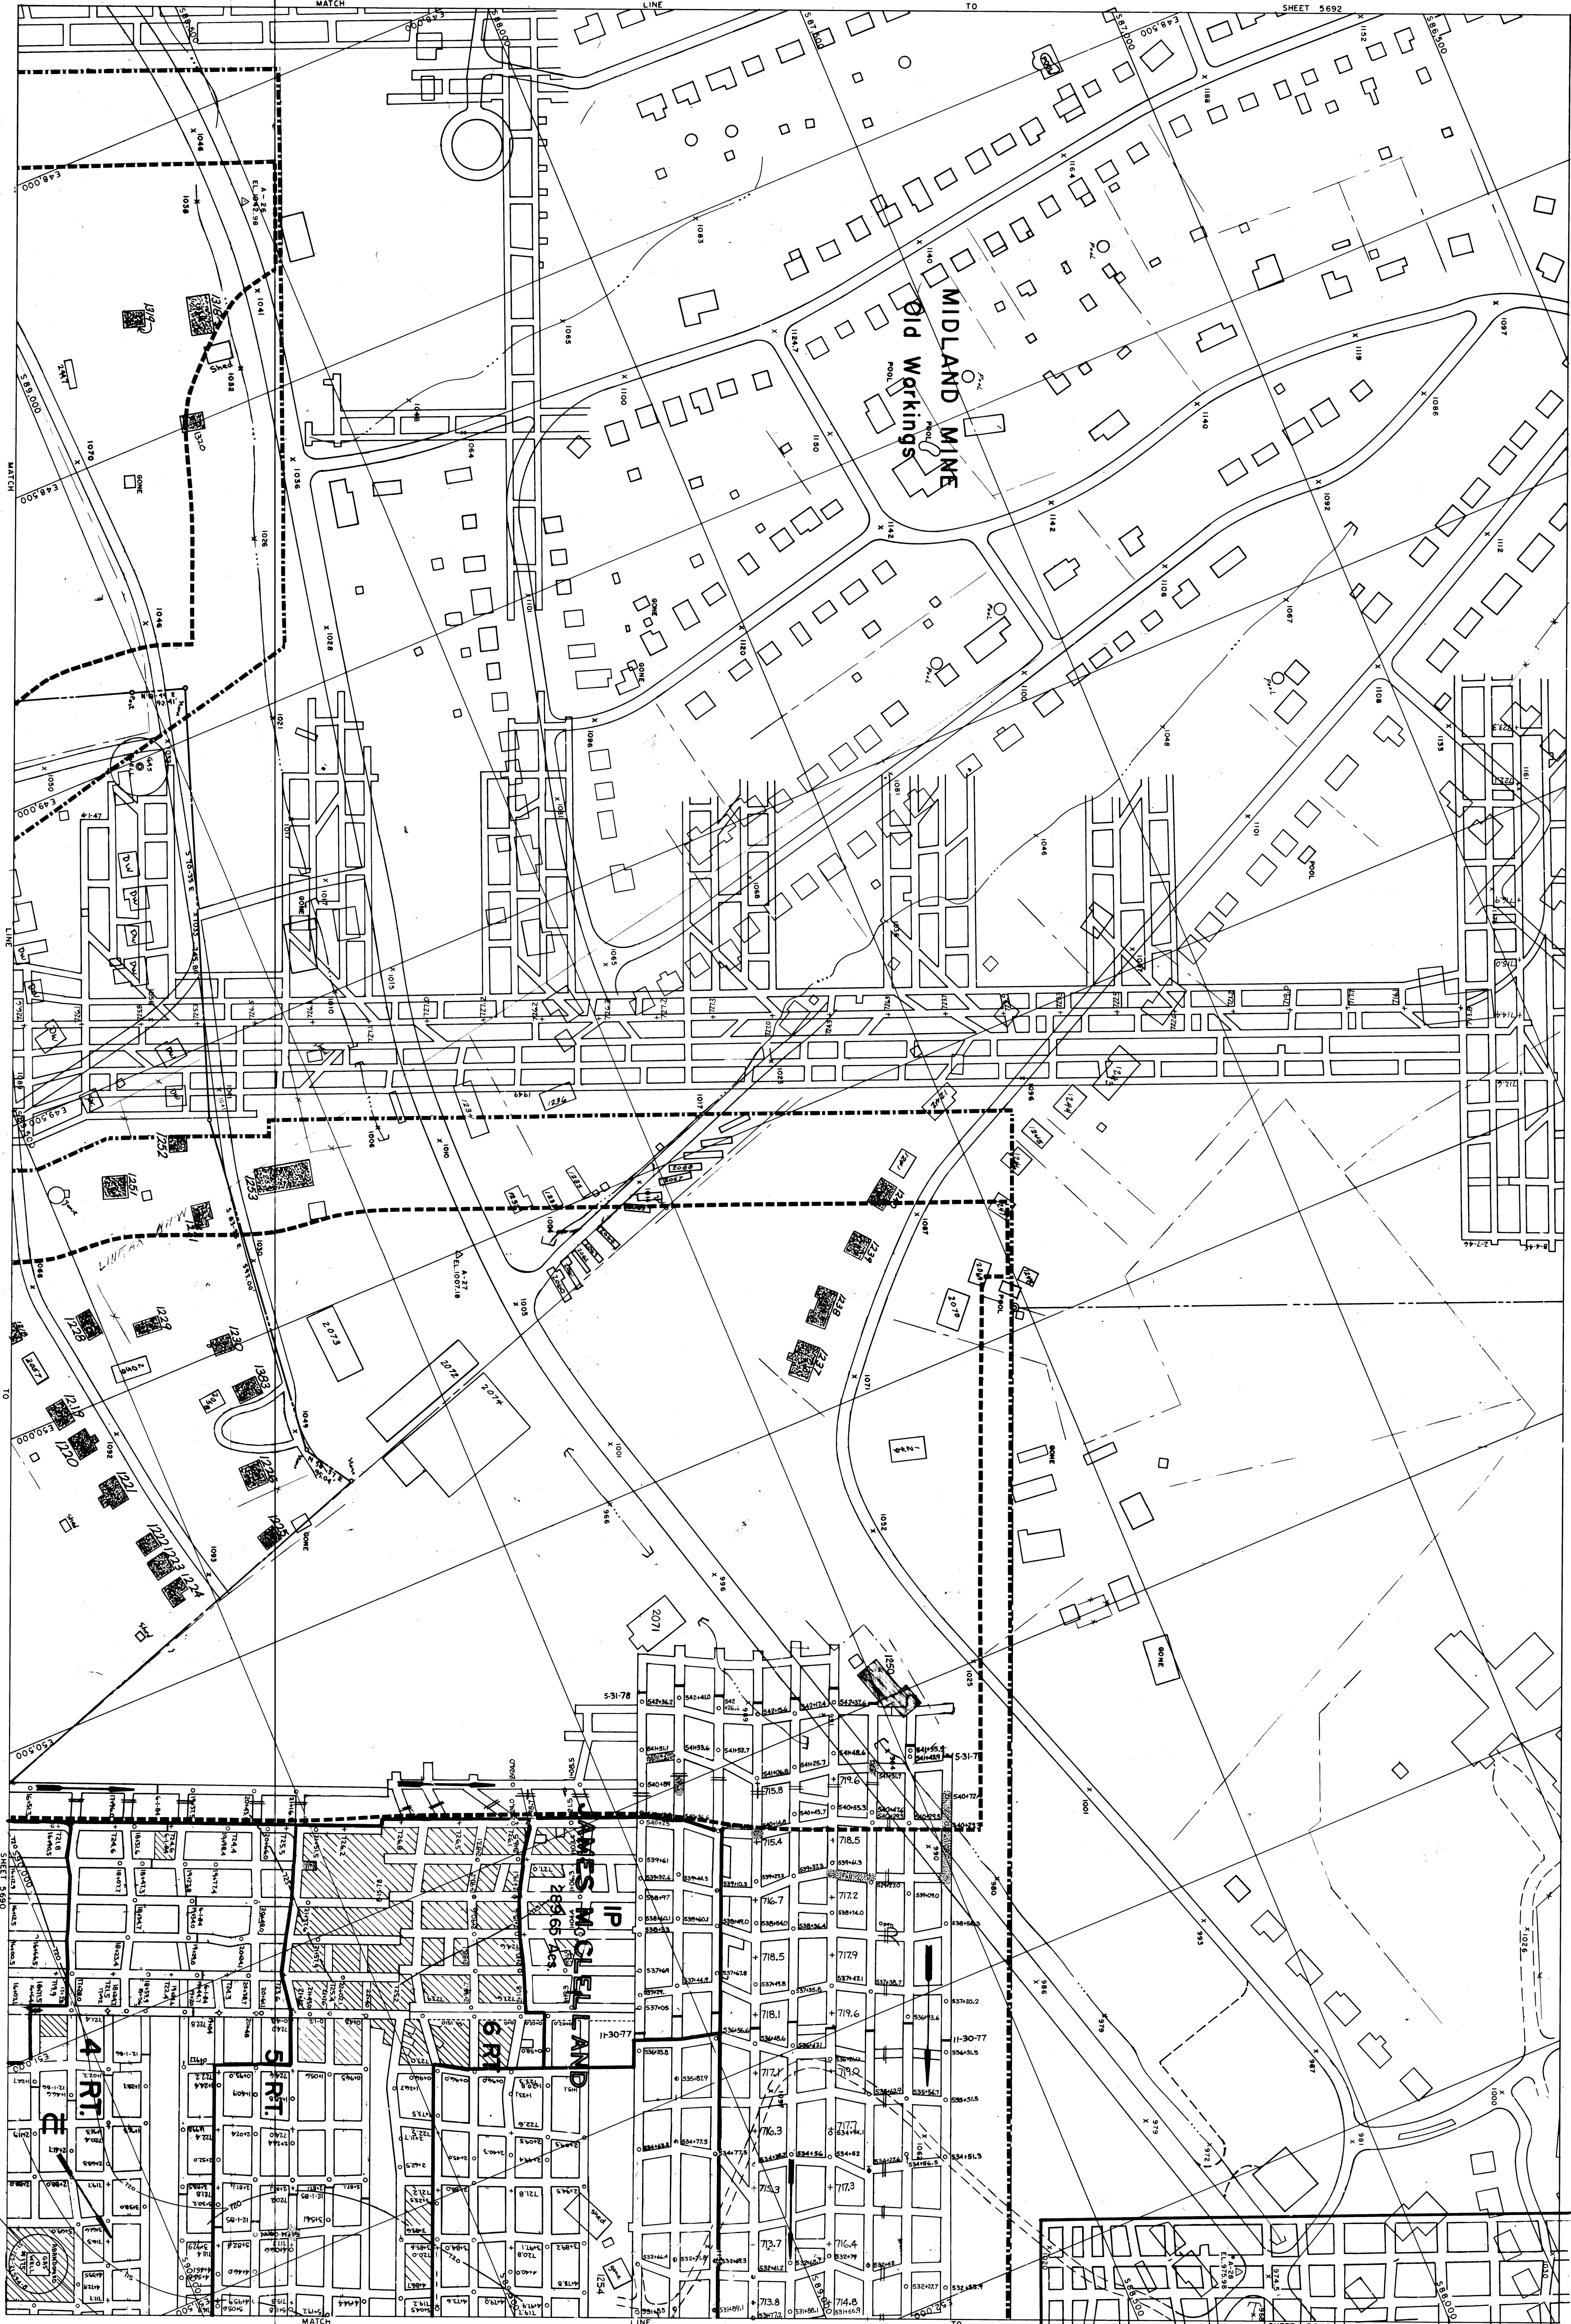

FIT TO K-5690