


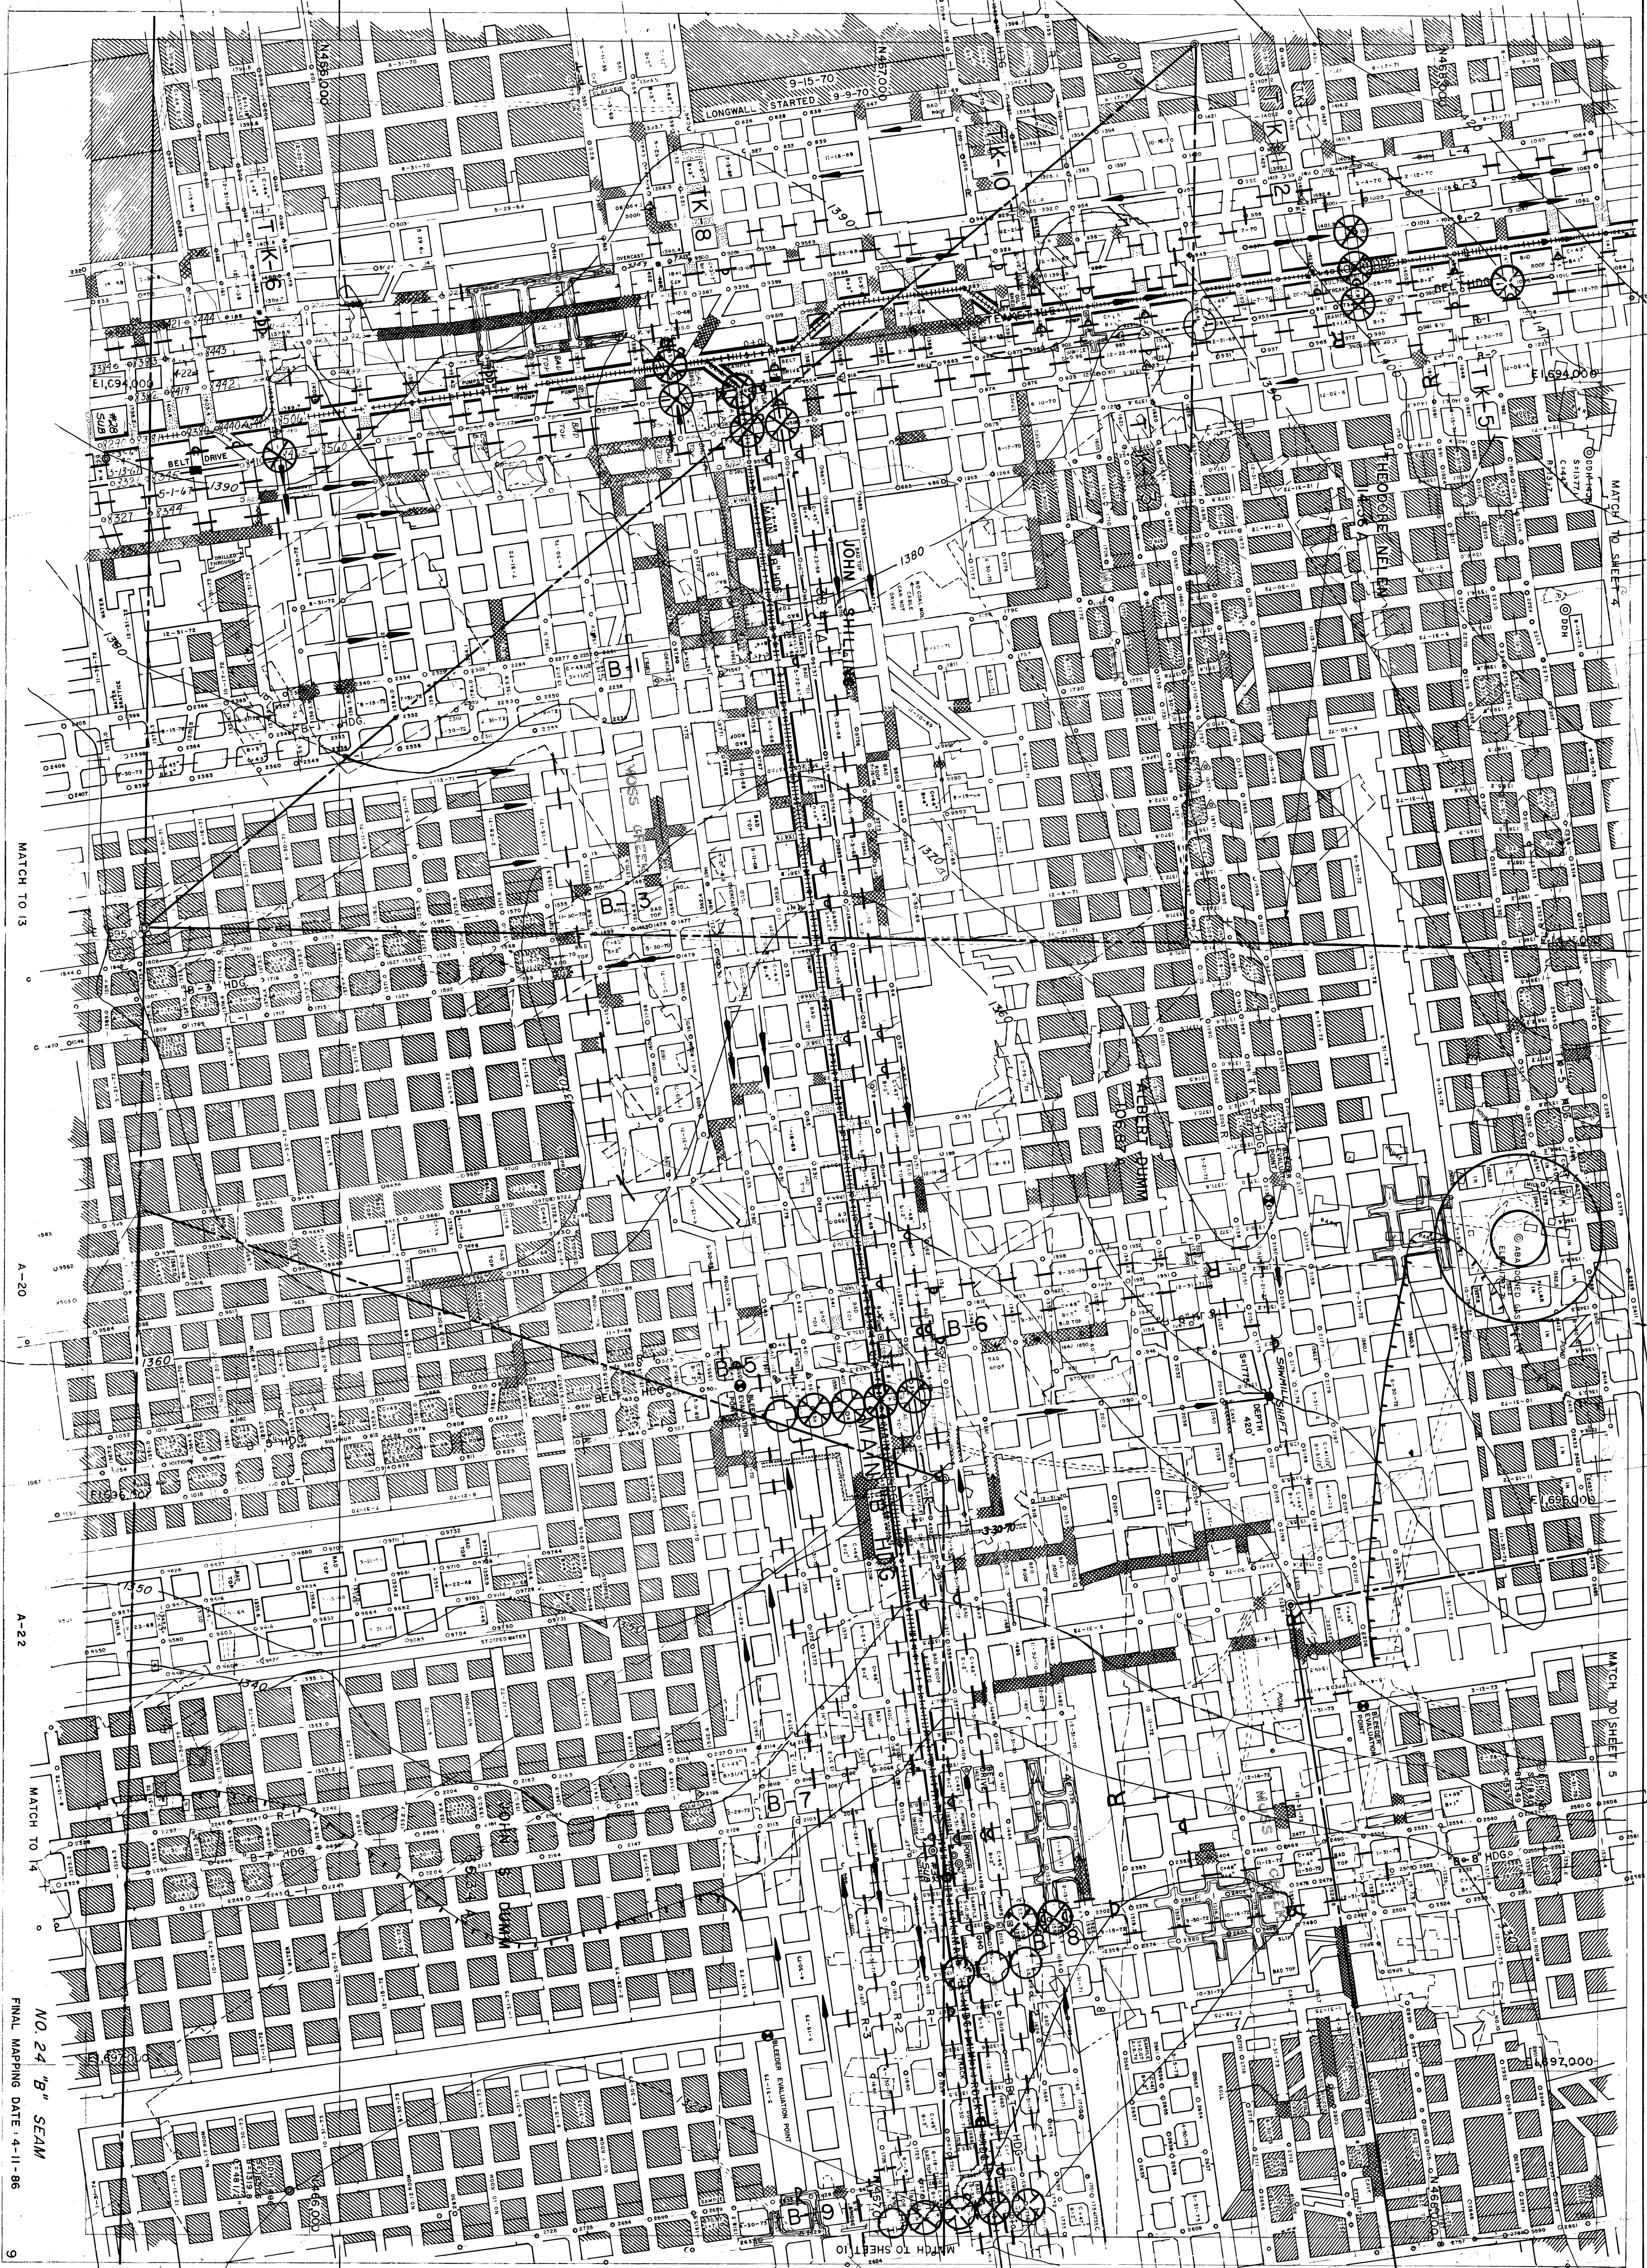

MATCH TO 13

A-20

A-22

MATCH TO 14

NO. 24 "B" SEAM
FINAL MAPPING DATE: 4-11-86