


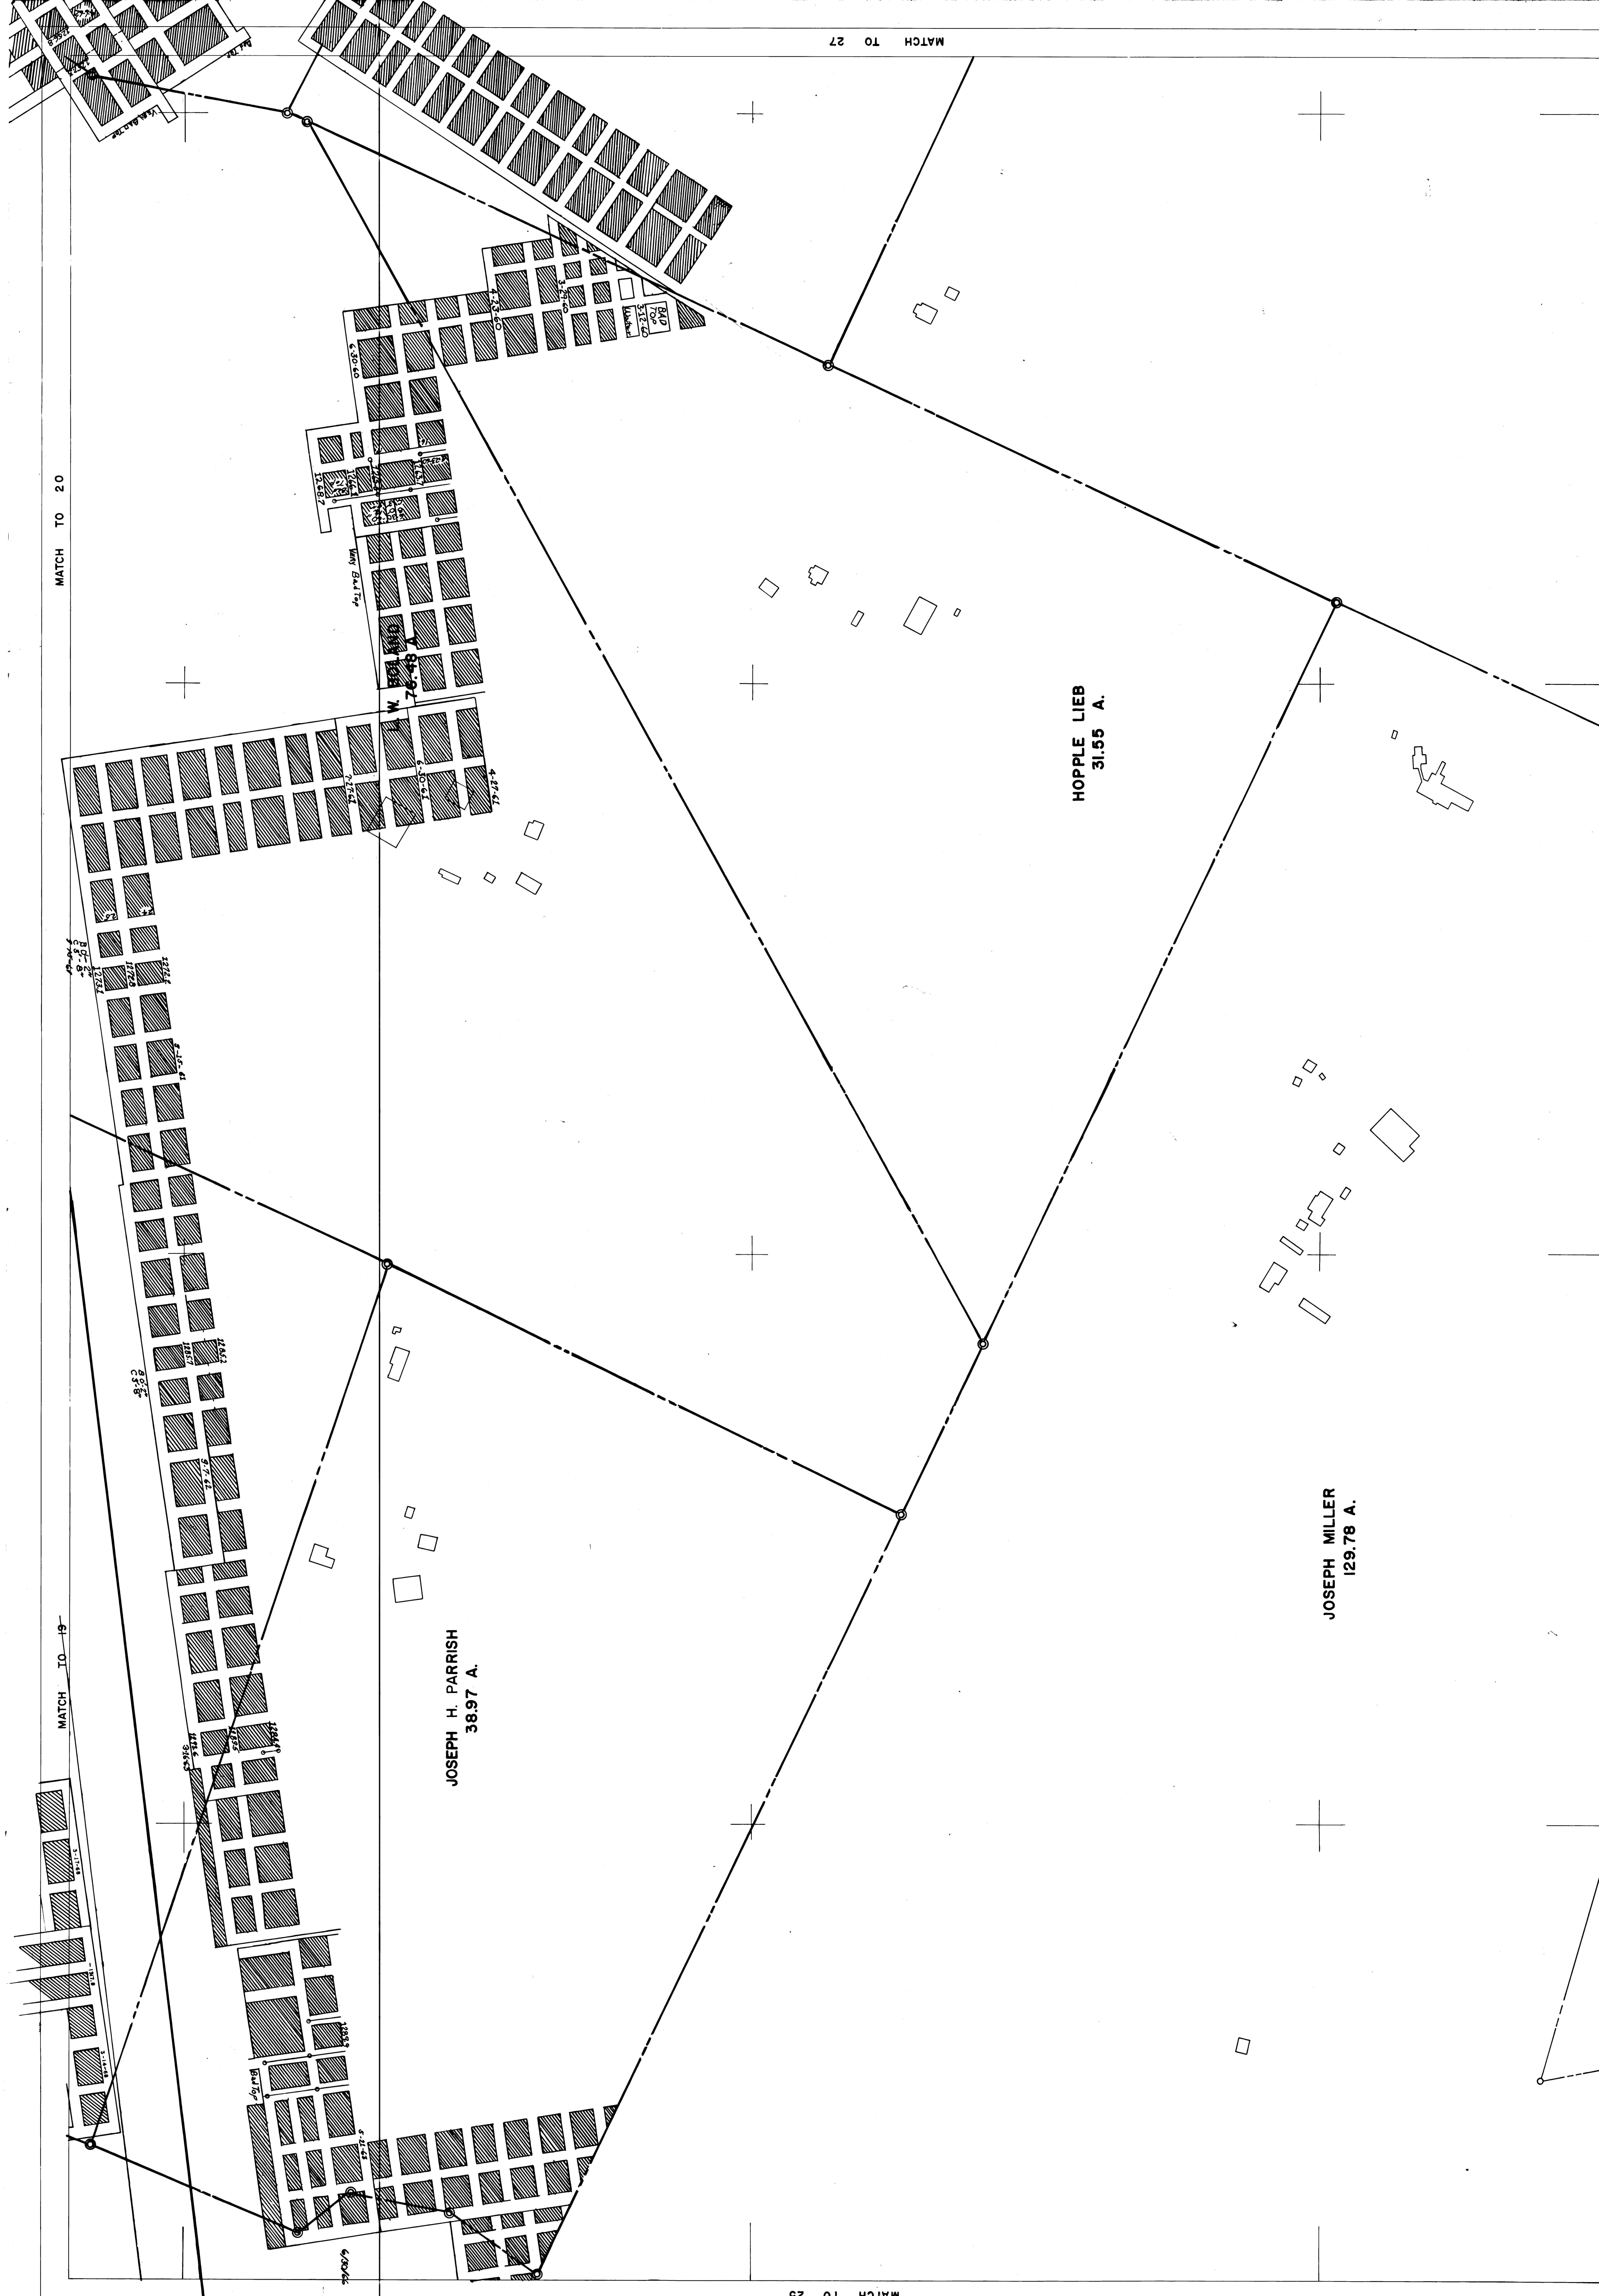

MATCH TO 33

MATCH TO 34