


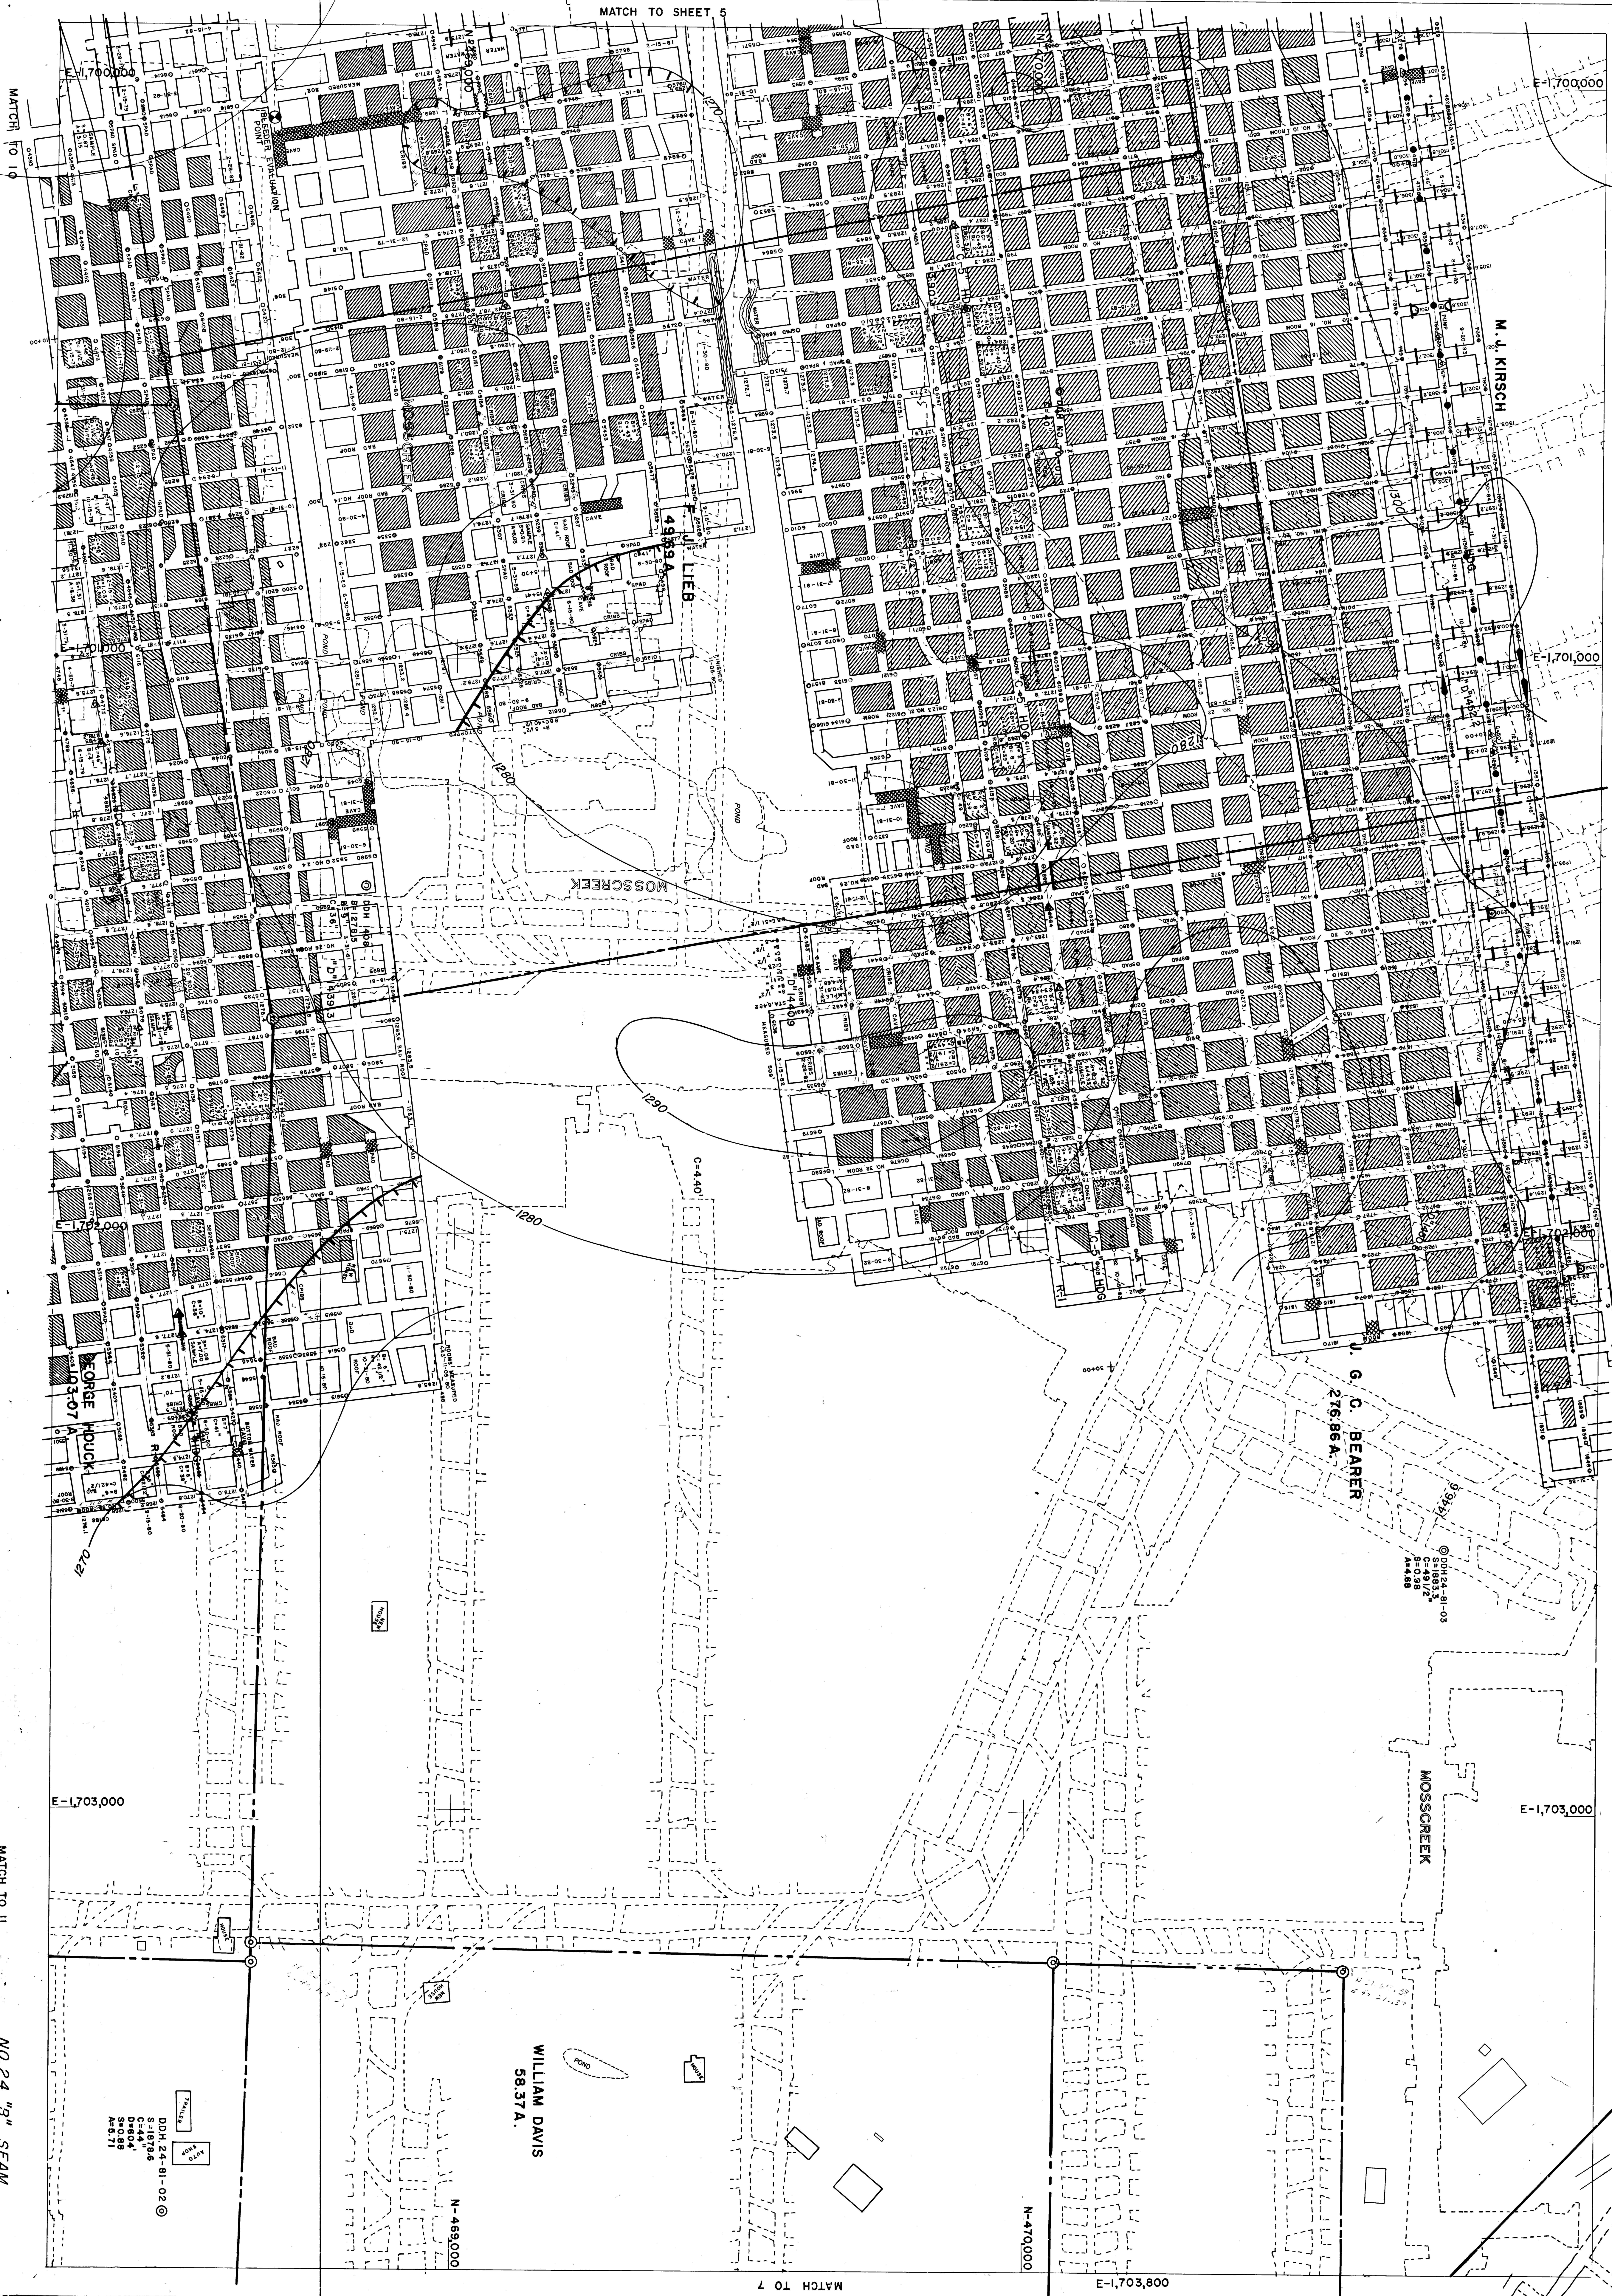

MATCH TO 10

MATCH TO 11

NO. 24 "B" SEAM
FINAL MAPPING DATE: 4-11-86

MATCH TO SHEET 5

MATCH TO 7

008'601'-3

N-470,000

N-469,000

E-1,703,000

E-1,703,000

E-1,700,000

E-1,701,000

DDH 24-B-02 ©
S-18786
C-44
S-086
A-871

WILLIAM DAVIS
58.37 A.

G. C. BEARER
275.86 A.

MOSSCREEK

© 1984-81-03
S-18832
S-0902
A-488