


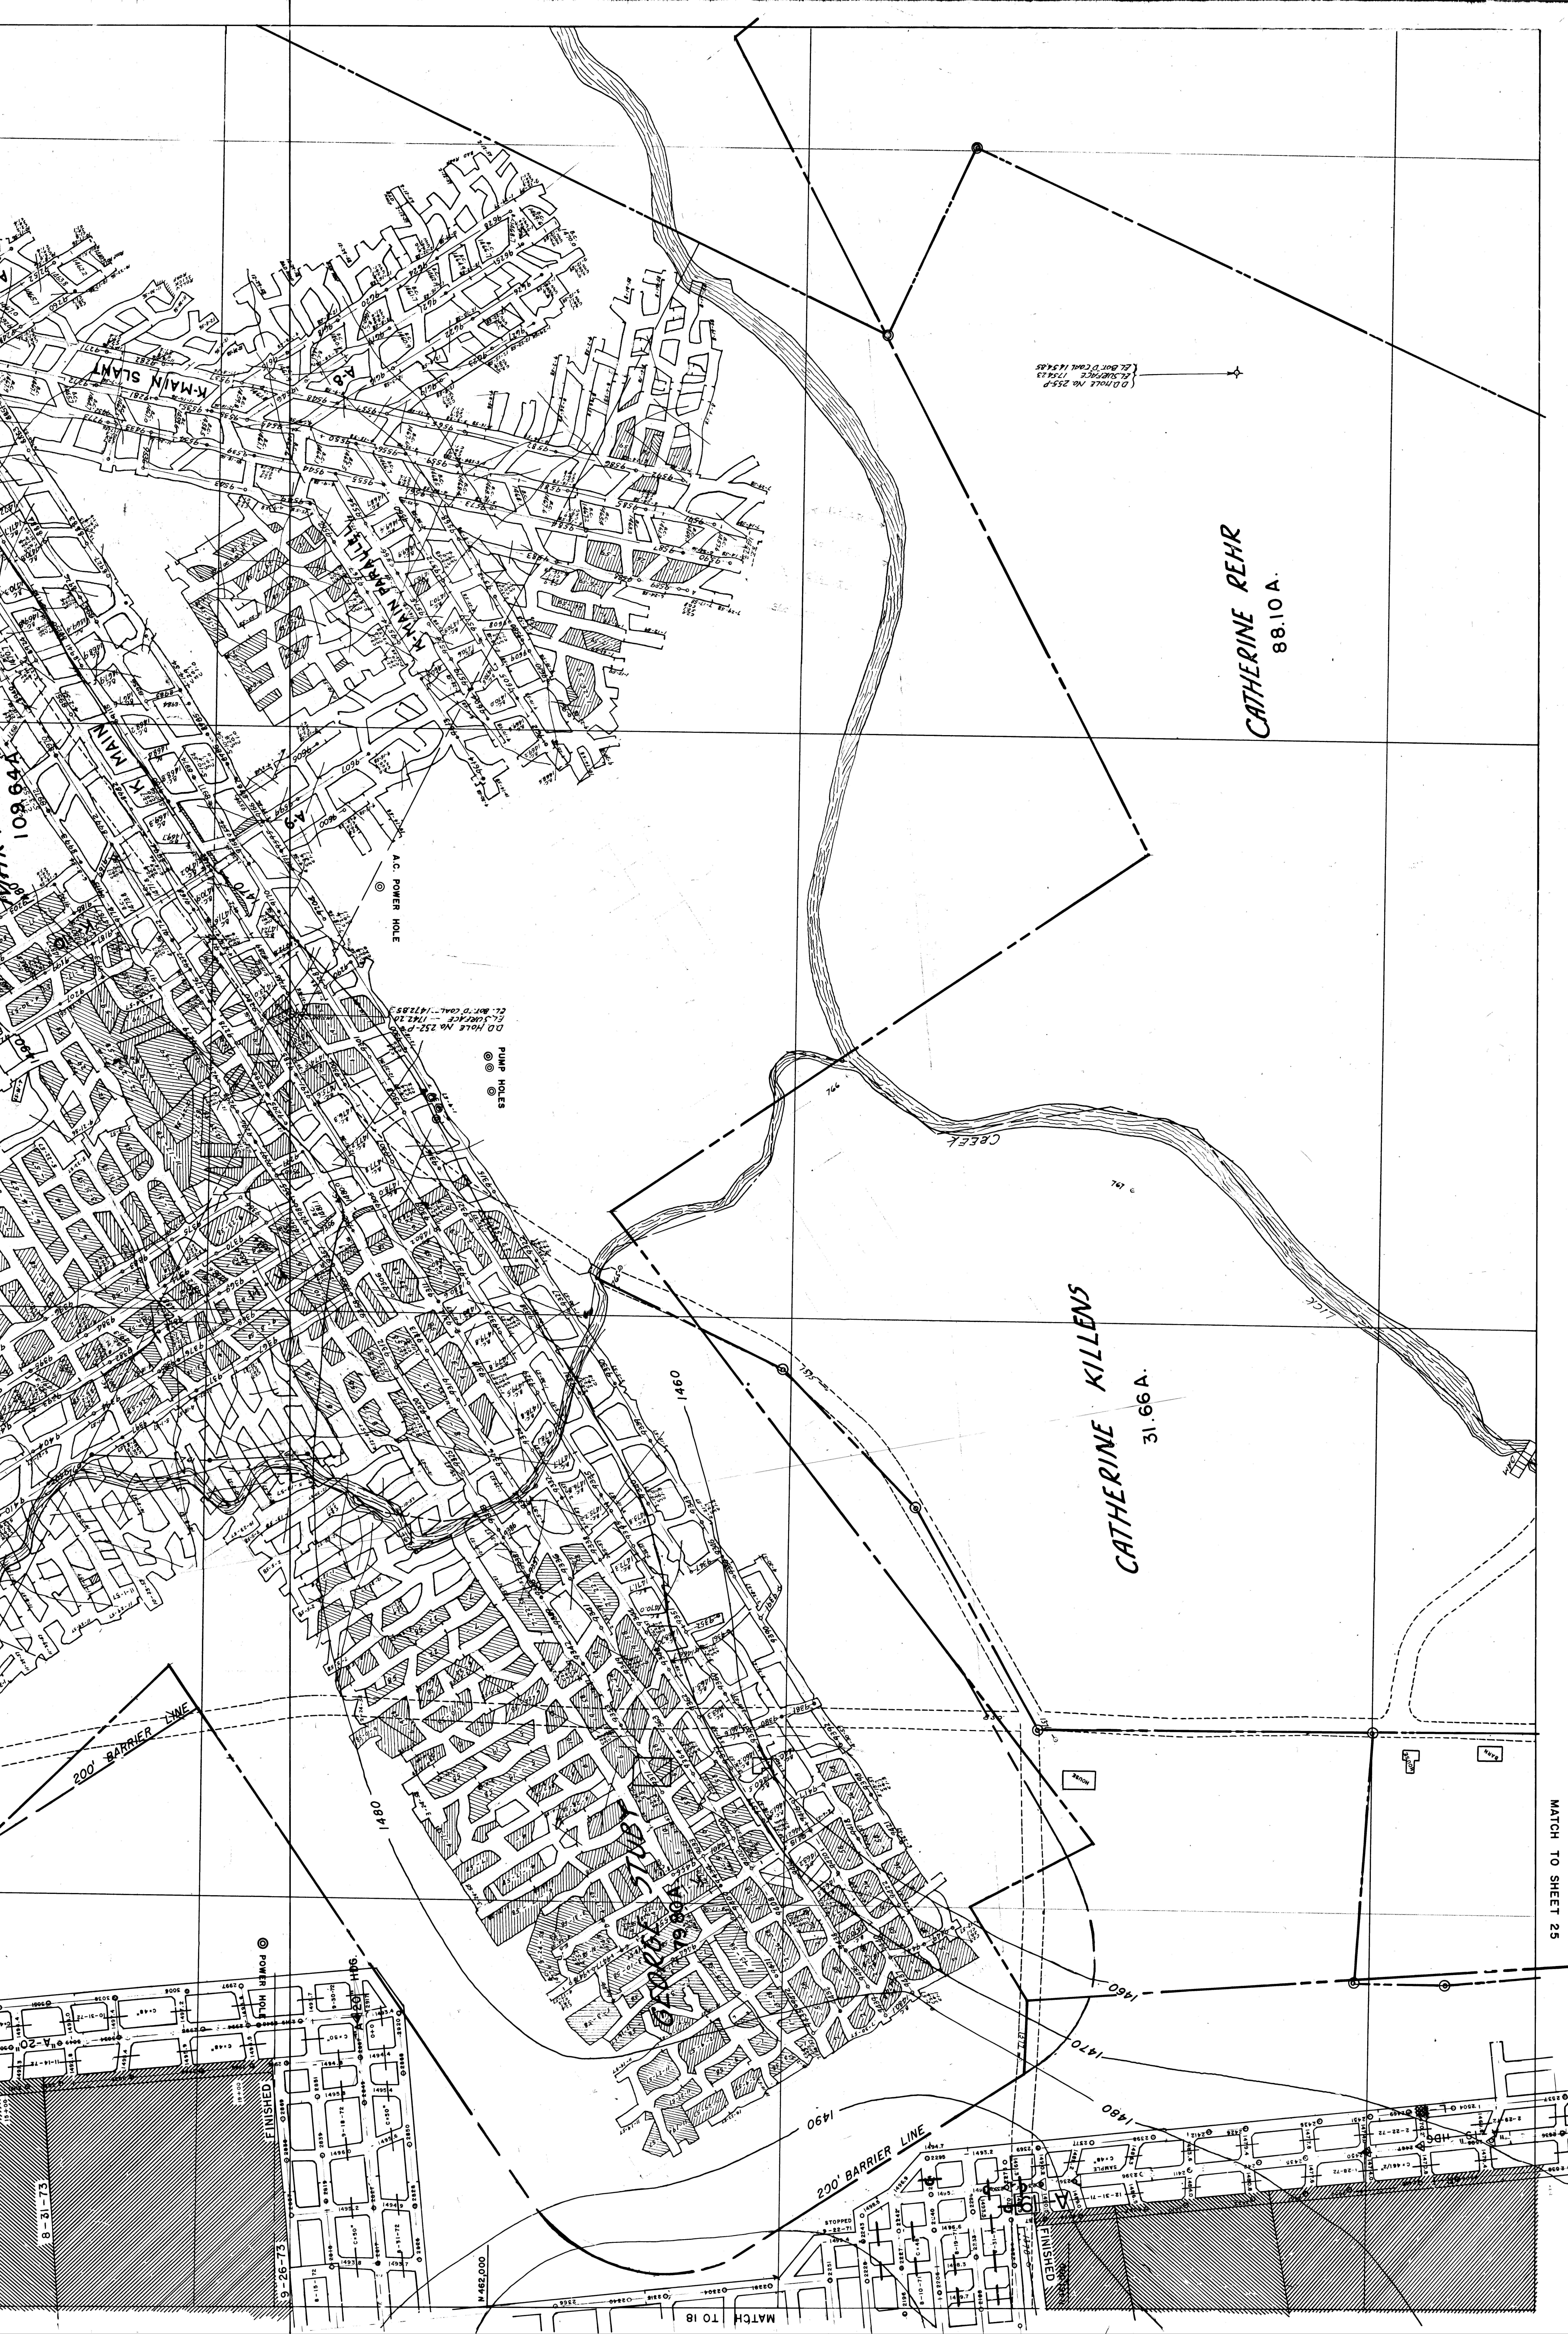

D.H. HOLE NO. 255-P
CL. SURFACE 1754.23
CL. BOT. D. COAL 1454.85

CATHERINE REHR
88.10 A.

CATHERINE KILLENS
31.66 A.

1460

1480

200' BARRIER LINE

MATCH TO 18

MATCH TO SHEET 25

8-31-73

FINISHED

FINISHED