SHEET NO. 1·9·4·7

FIT TO SHEET 1·9·4·10

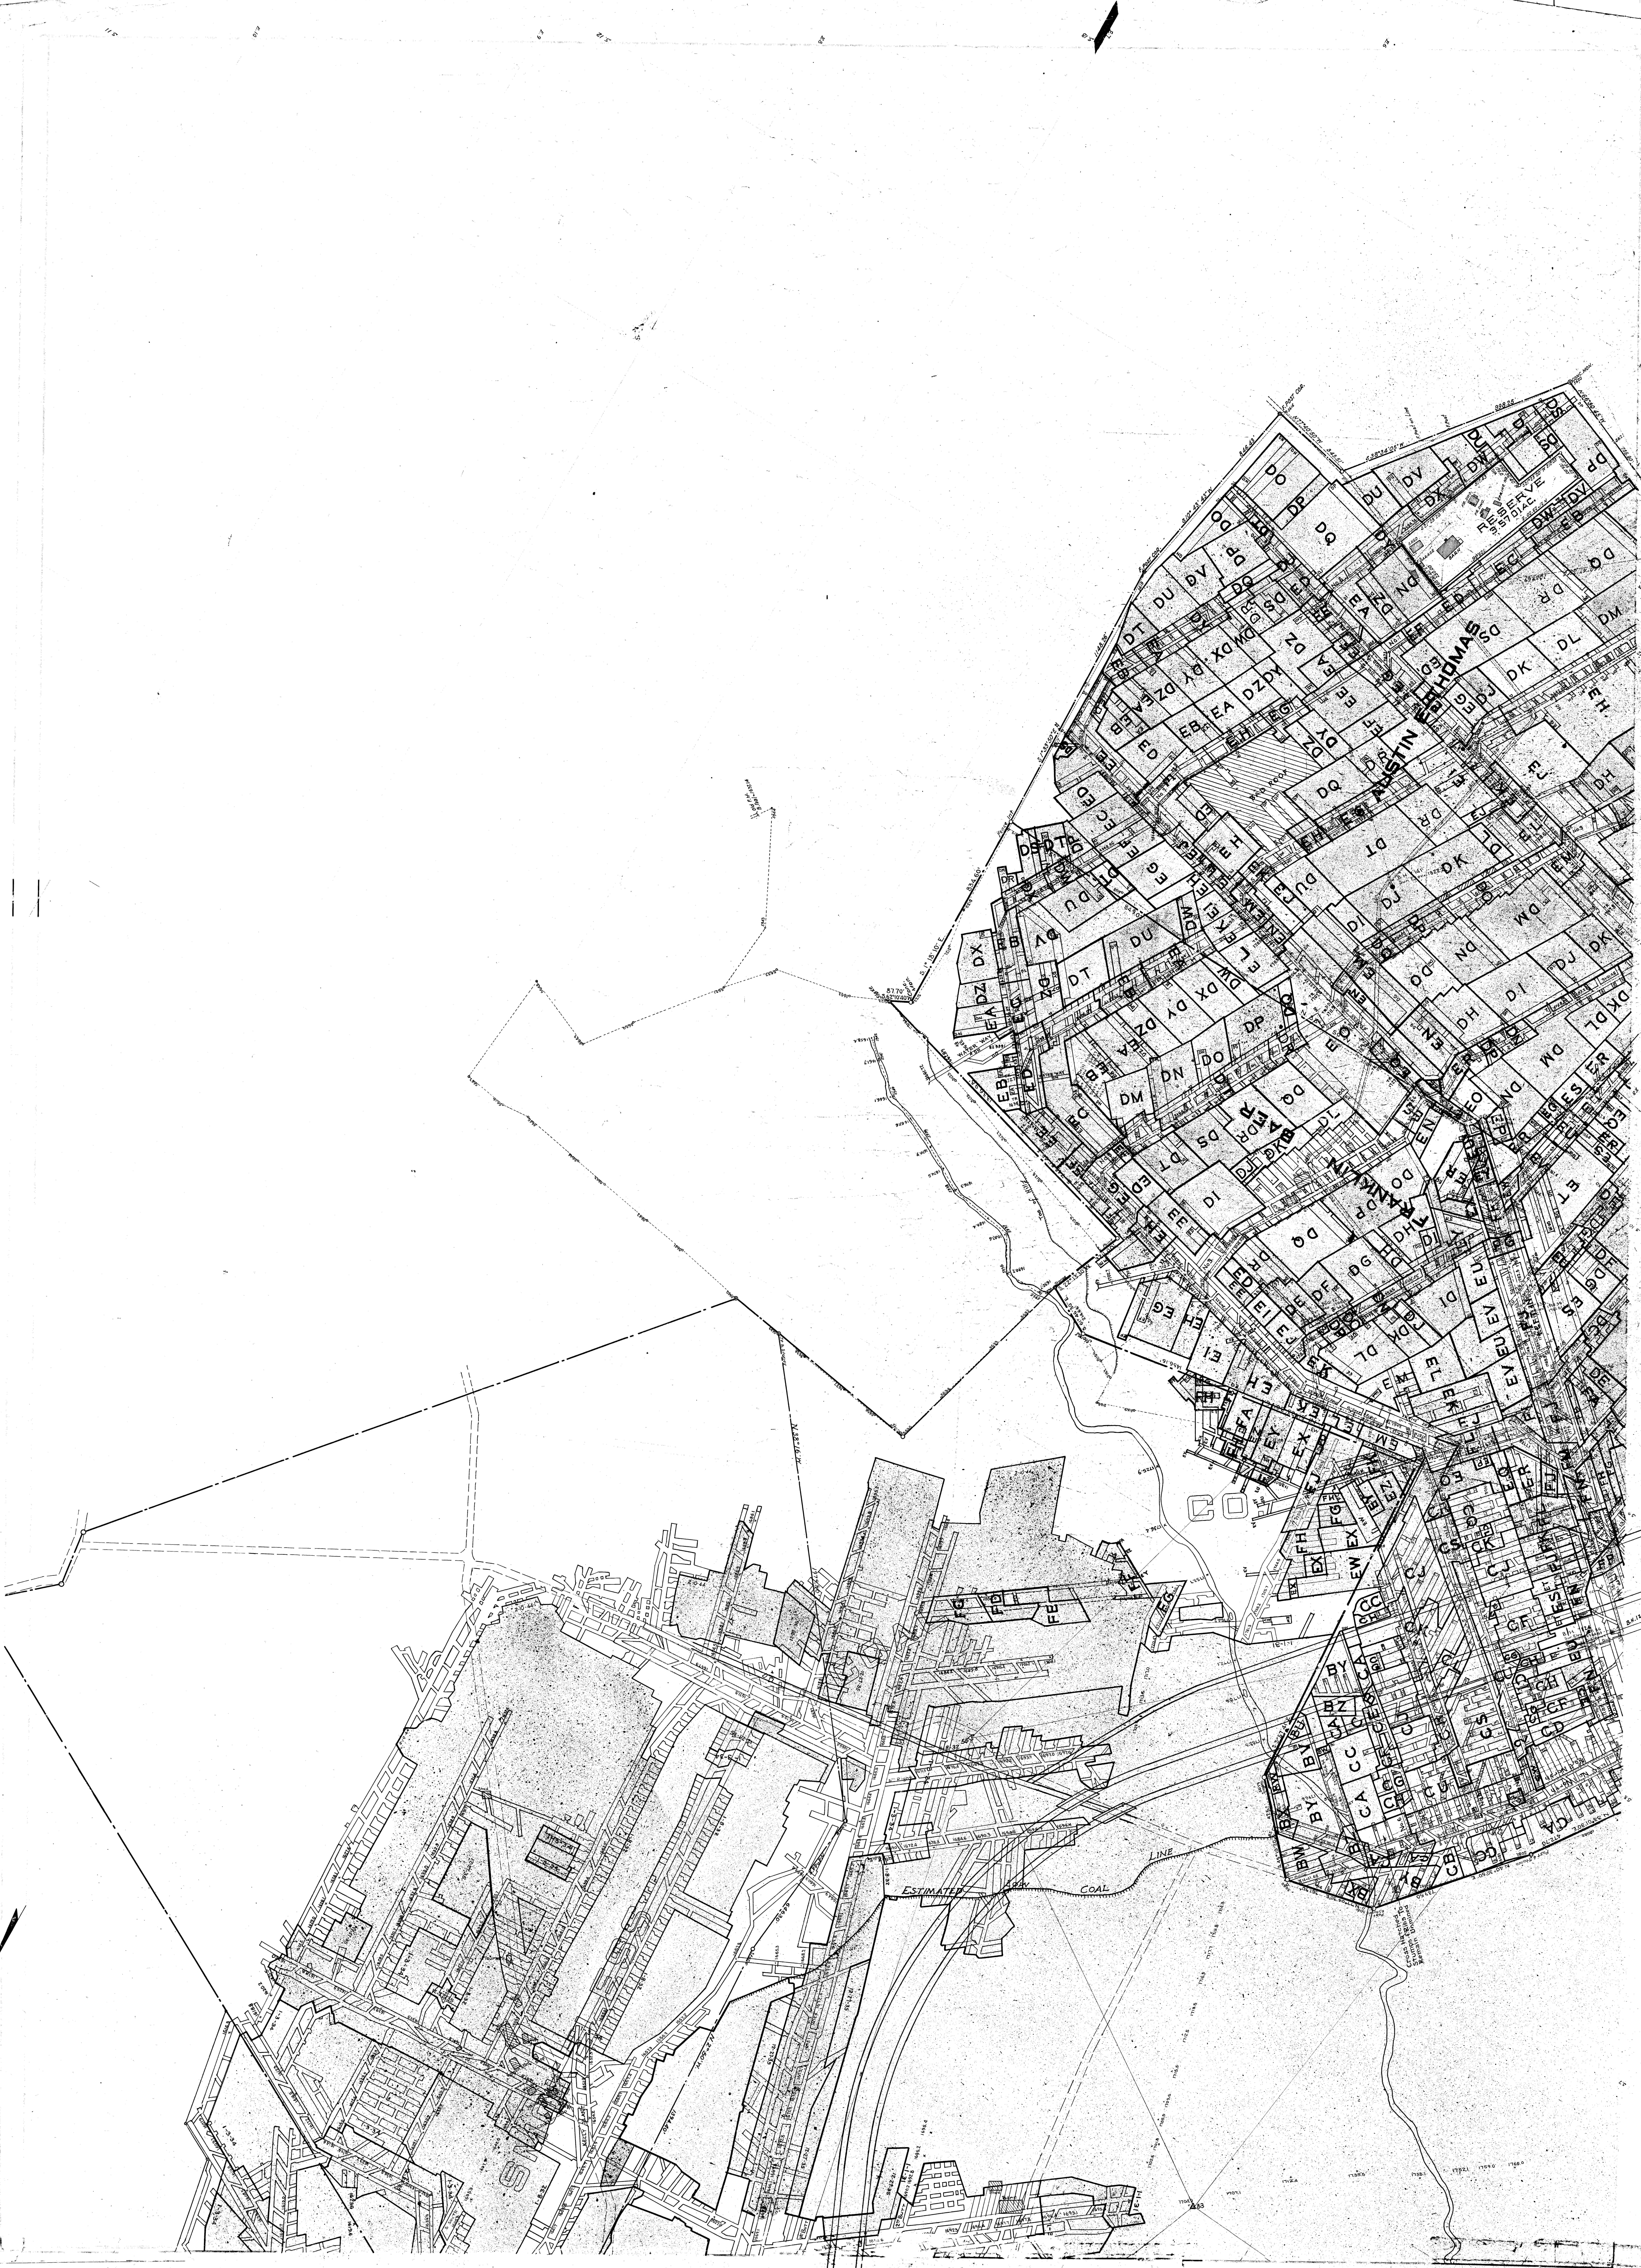
AUSTIN
THOMAS
FRANKLIN
RESERVE
3.57 AC.
BARN
SHED
GARAGE
BAD ROOF
F. POST COR.
CONC. MON.
Fence Int.
WATER WAY
Top of Fill
Old P.M.
CO
ESTIMATED LOW COAL LINE
Cross Hatched Stumps & Ribs To Remain Unmined
KELLY PLANE
B.H. 124
N 38°16' W
S 1°18'10" E
998.25
1148.26'
834.60'
1456.15'
No. 1
No. 3
No. 6
No. 7
No. 8
2·10·44
1·3·34
1·8·32
12·27·35
1-E-1

FIT TO SHEET 1·9·4·4

SHEET NO. 1·9·4·7

FIT TO SHEET 1·9·4·8