FIT TO SHEET NO. 23

SHEET NO. 22

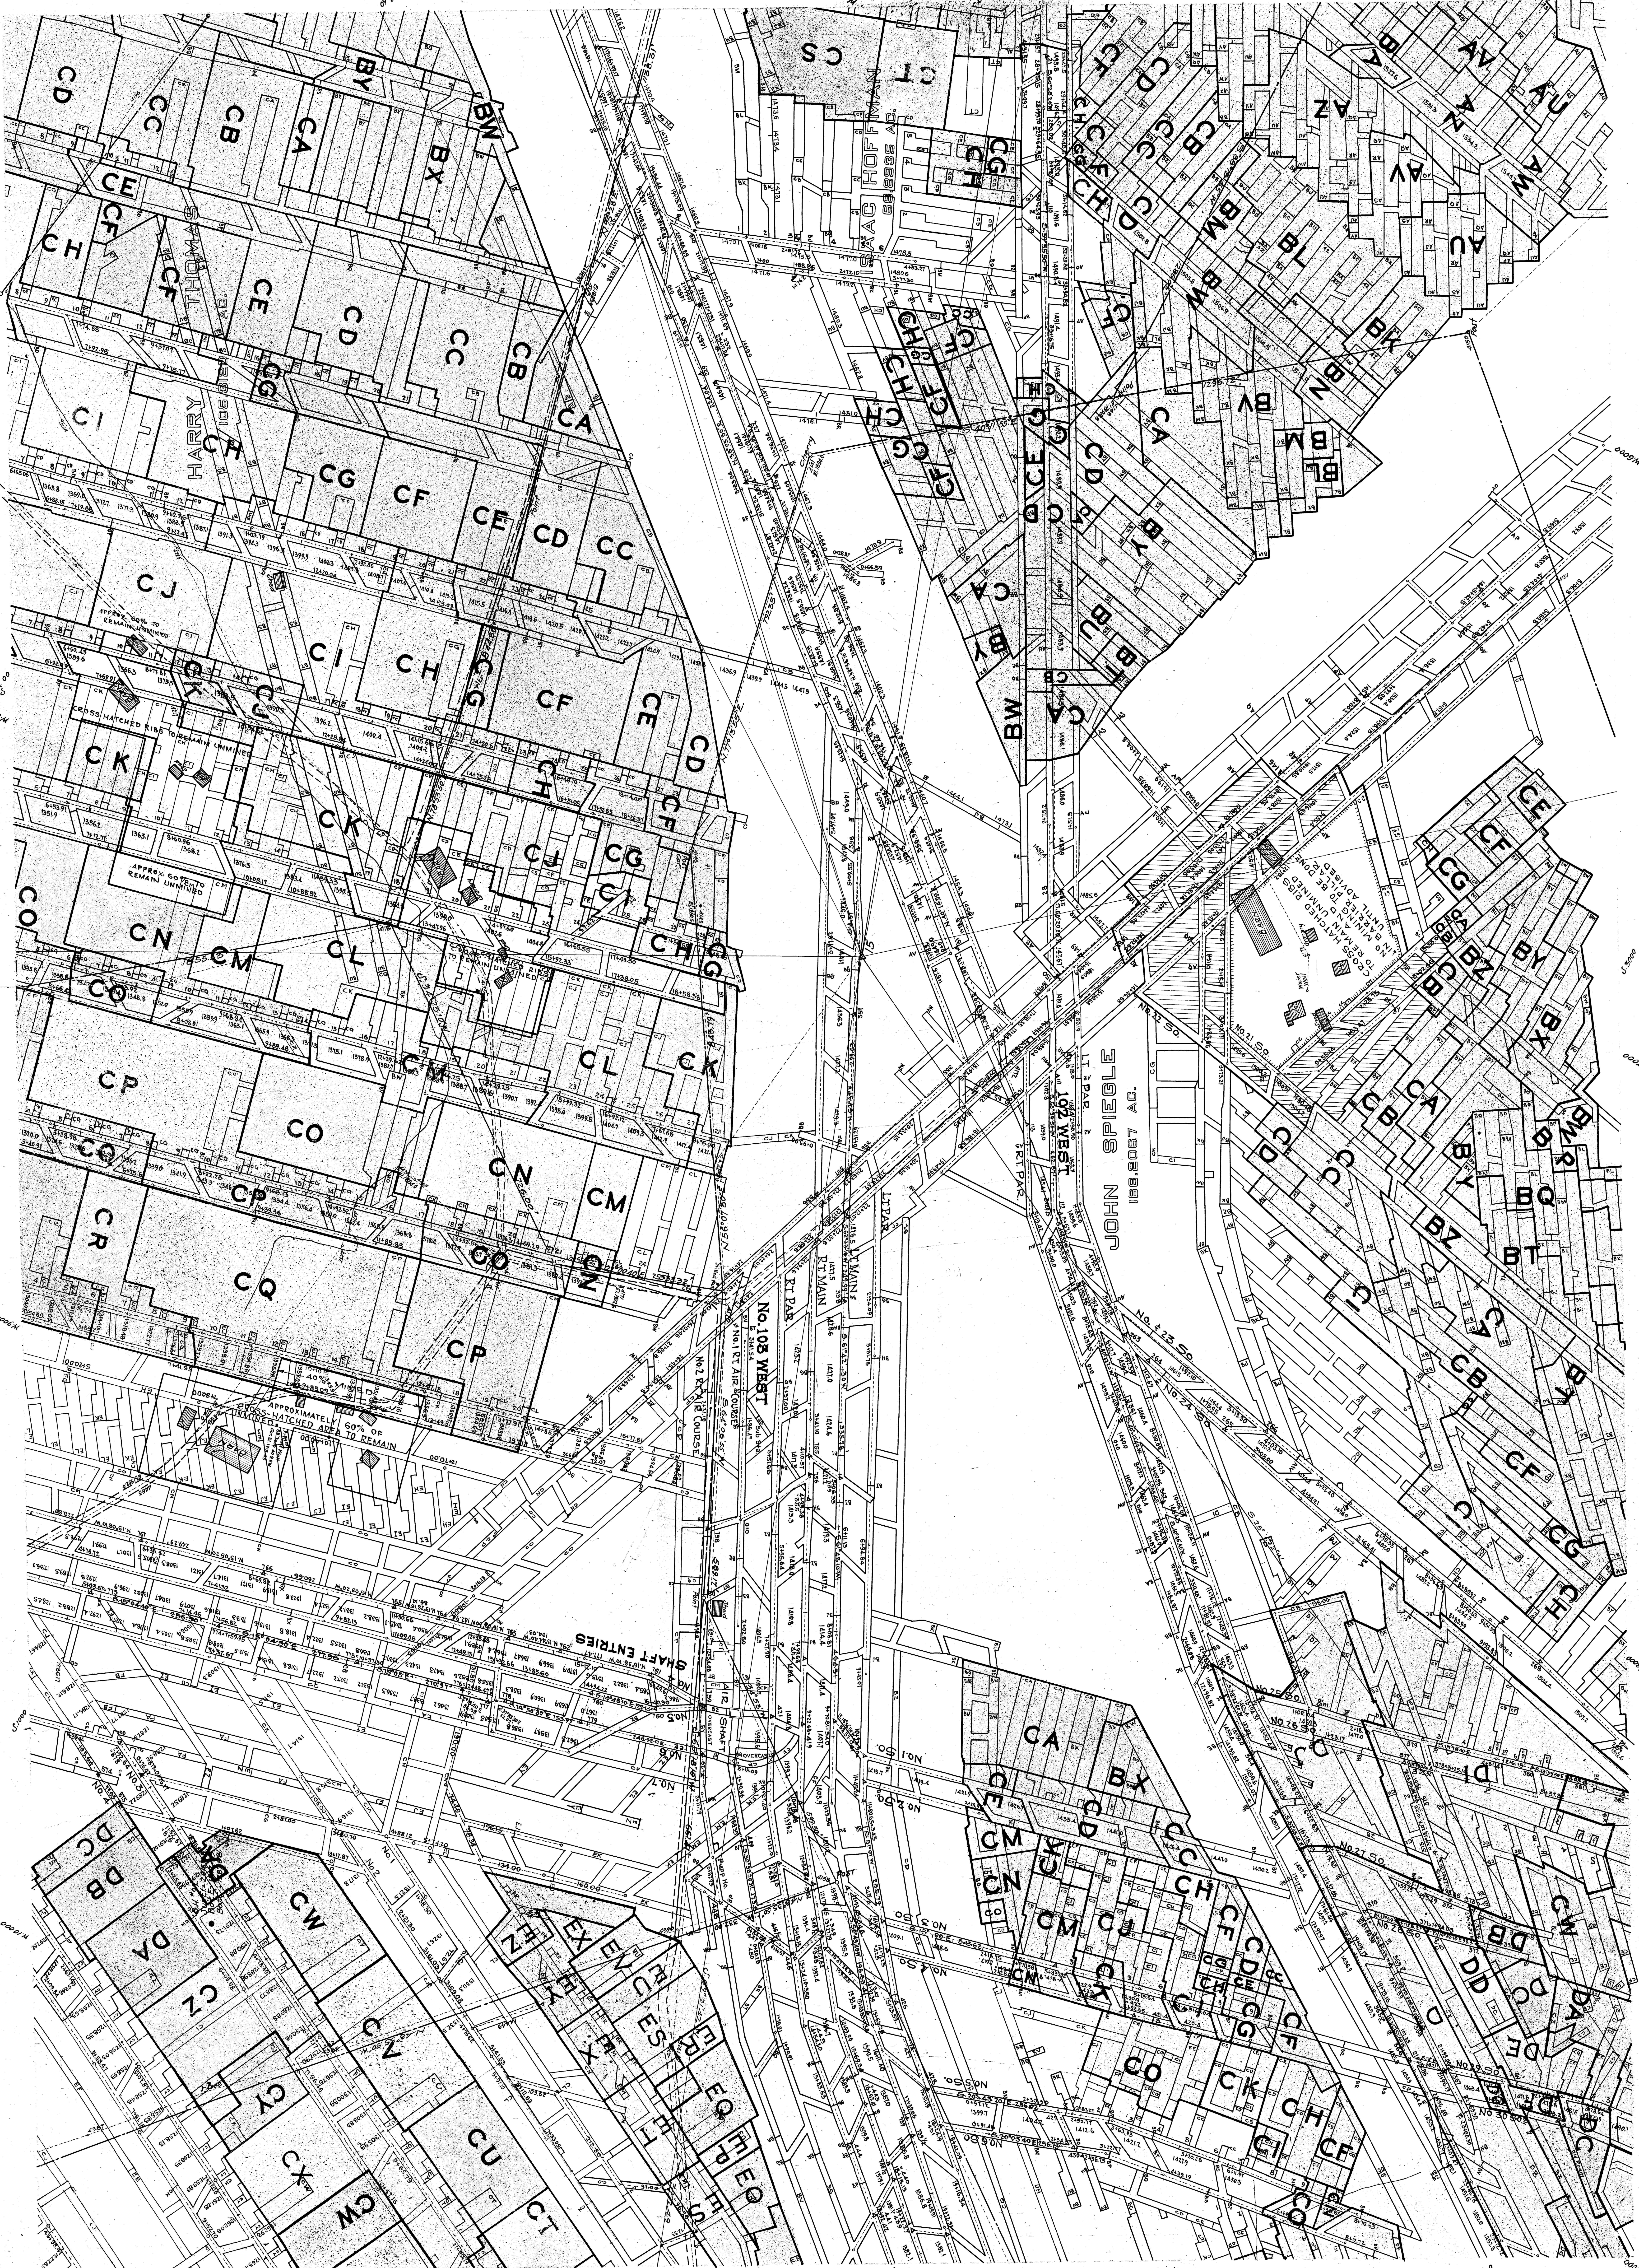
ISAAC HOFFMAN 89.8935 AC.
HARRY THOMAS 105.3120 AC.
JOHN SPIEGLE 166.2067 AC.
No. 103 WEST
102 WEST
No. 1 Rt. AIR COURSE
No. 2 Rt. AIR COURSE
Rt. MAIN
Lt. MAIN
Rt. PAR.
Lt. PAR.
SHAFT ENTRIES
AIR SHAFT
OVERCAST
Pump Ho.
CROSS HATCHED RIBS TO REMAIN UNMINED
APPROX. 60% TO REMAIN UNMINED
APPROXIMATELY 60% OF CROSS-HATCHED AREA TO REMAIN UNMINED
CROSS HATCHED RIBS TO REMAIN UNMINED
No. 21 So.
No. 22 So.
No. 23 So.
No. 24 So.
No. 25 So.
No. 26 So.
No. 27 So.
No. 28 So.
No. 29 So.
No. 30 So.
No. 1 So.
No. 2 So.
No. 3 So.
No. 4 So.
No. 5 So.
No. 6 So.
W.7000
W.8000
W.9000
W.10000
W.6000
S.1000
S.2000
S.3000
S.4000

FIT TO SHEET NO. 19

FIT TO SHEET NO. 29

SHEET NO. 22

FIT TO SHEET NO. 21