


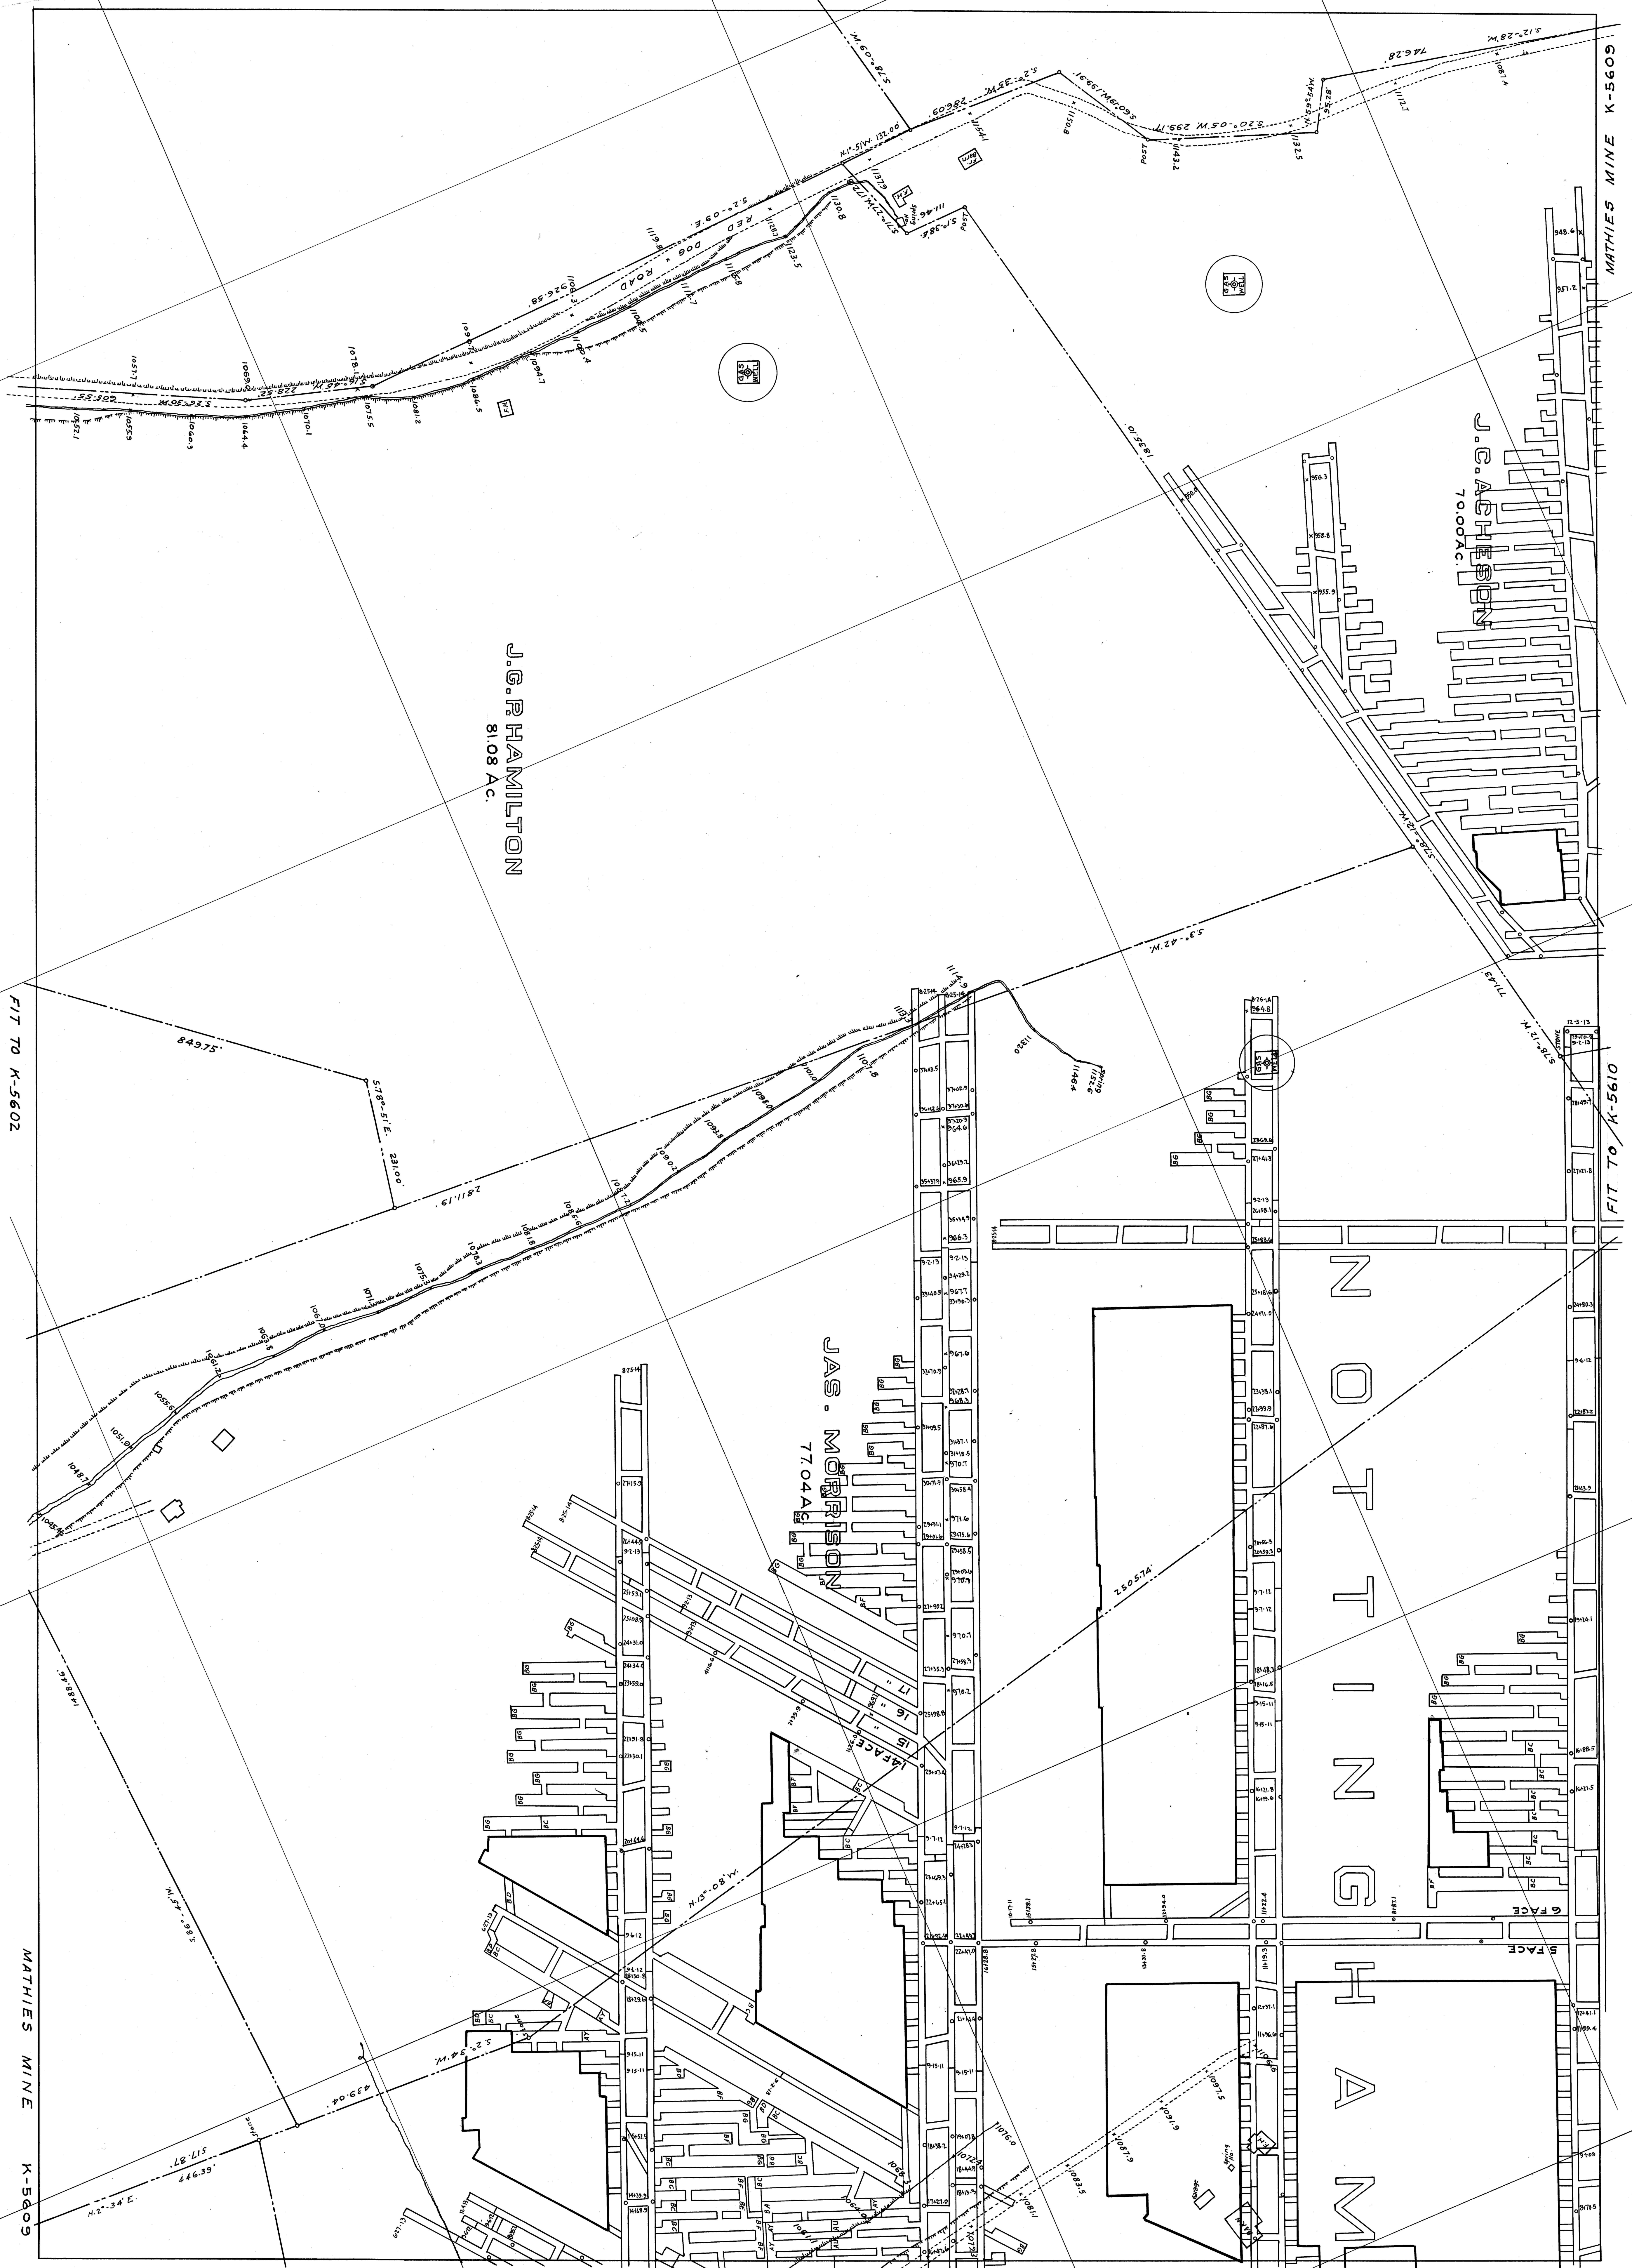

J.G. P. HAMILTON
81.08 AC.

70.00 AC.

JAS. MORRISON
77.04 AC.


FIT TO K-5602



FIT TO K-5610