


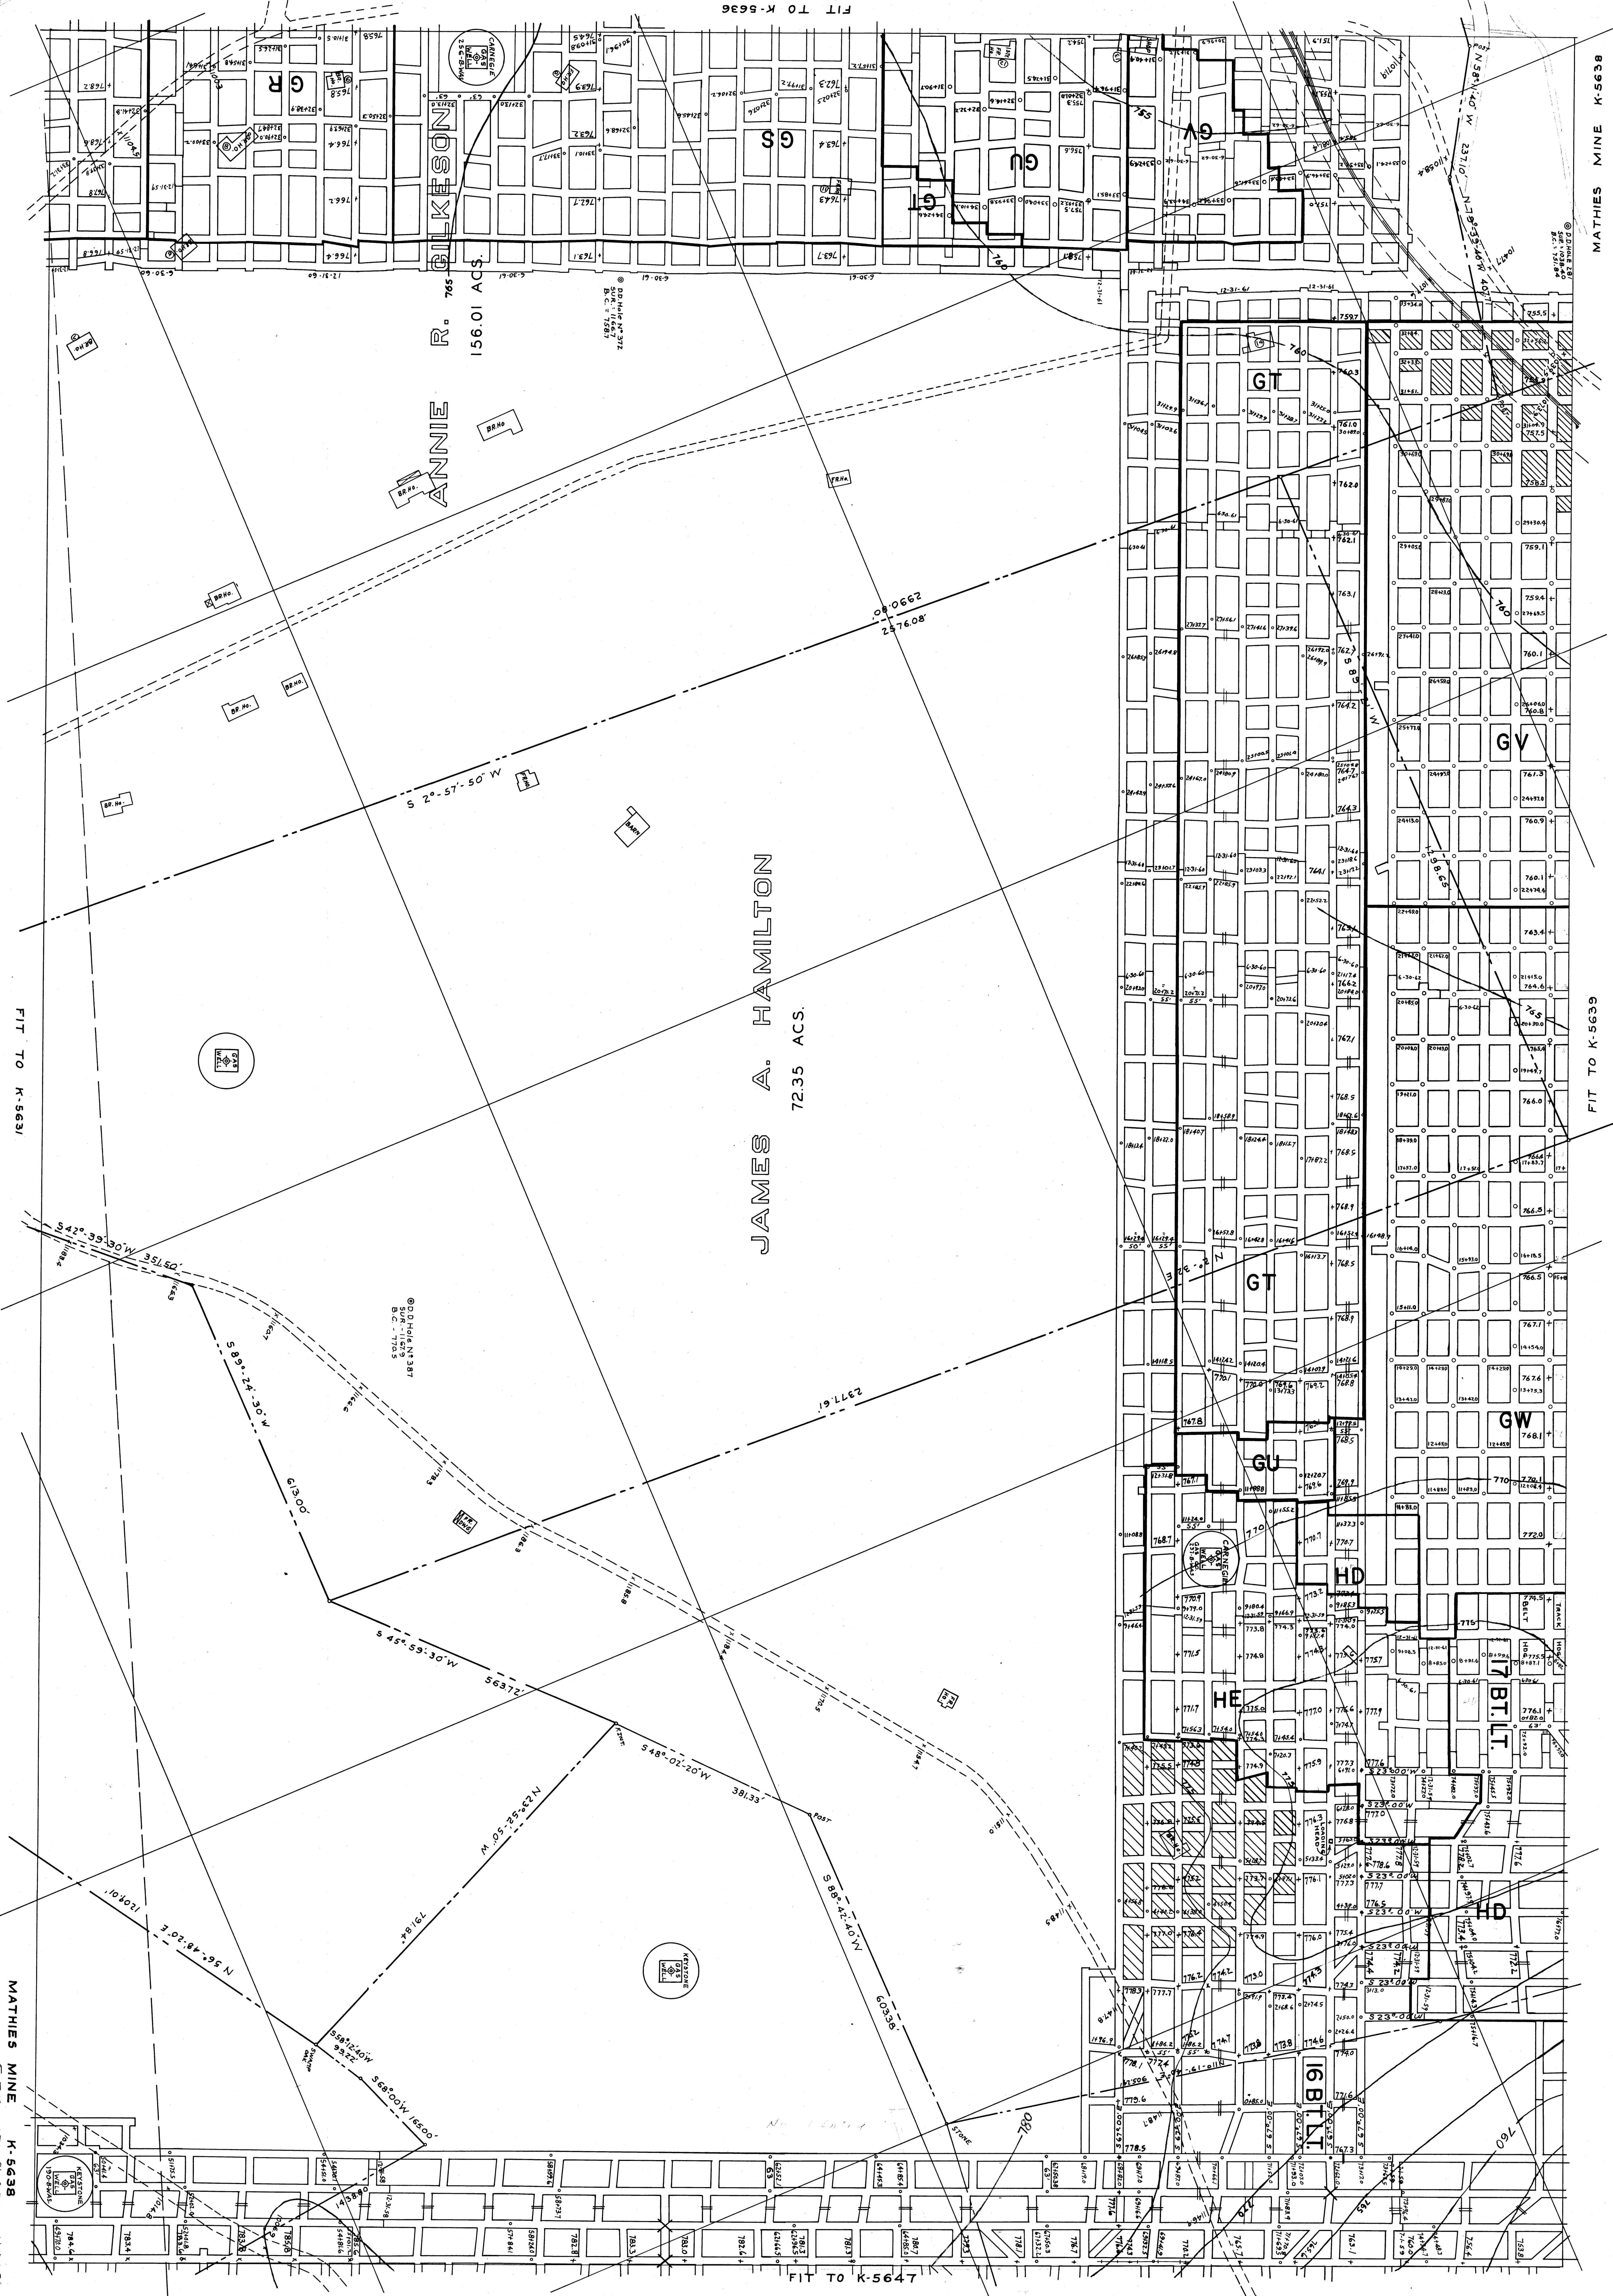

MATHIES MINE K-5638


FIT TO K-5631

MATHIES MINE K-5638

FIT TO K-5647