


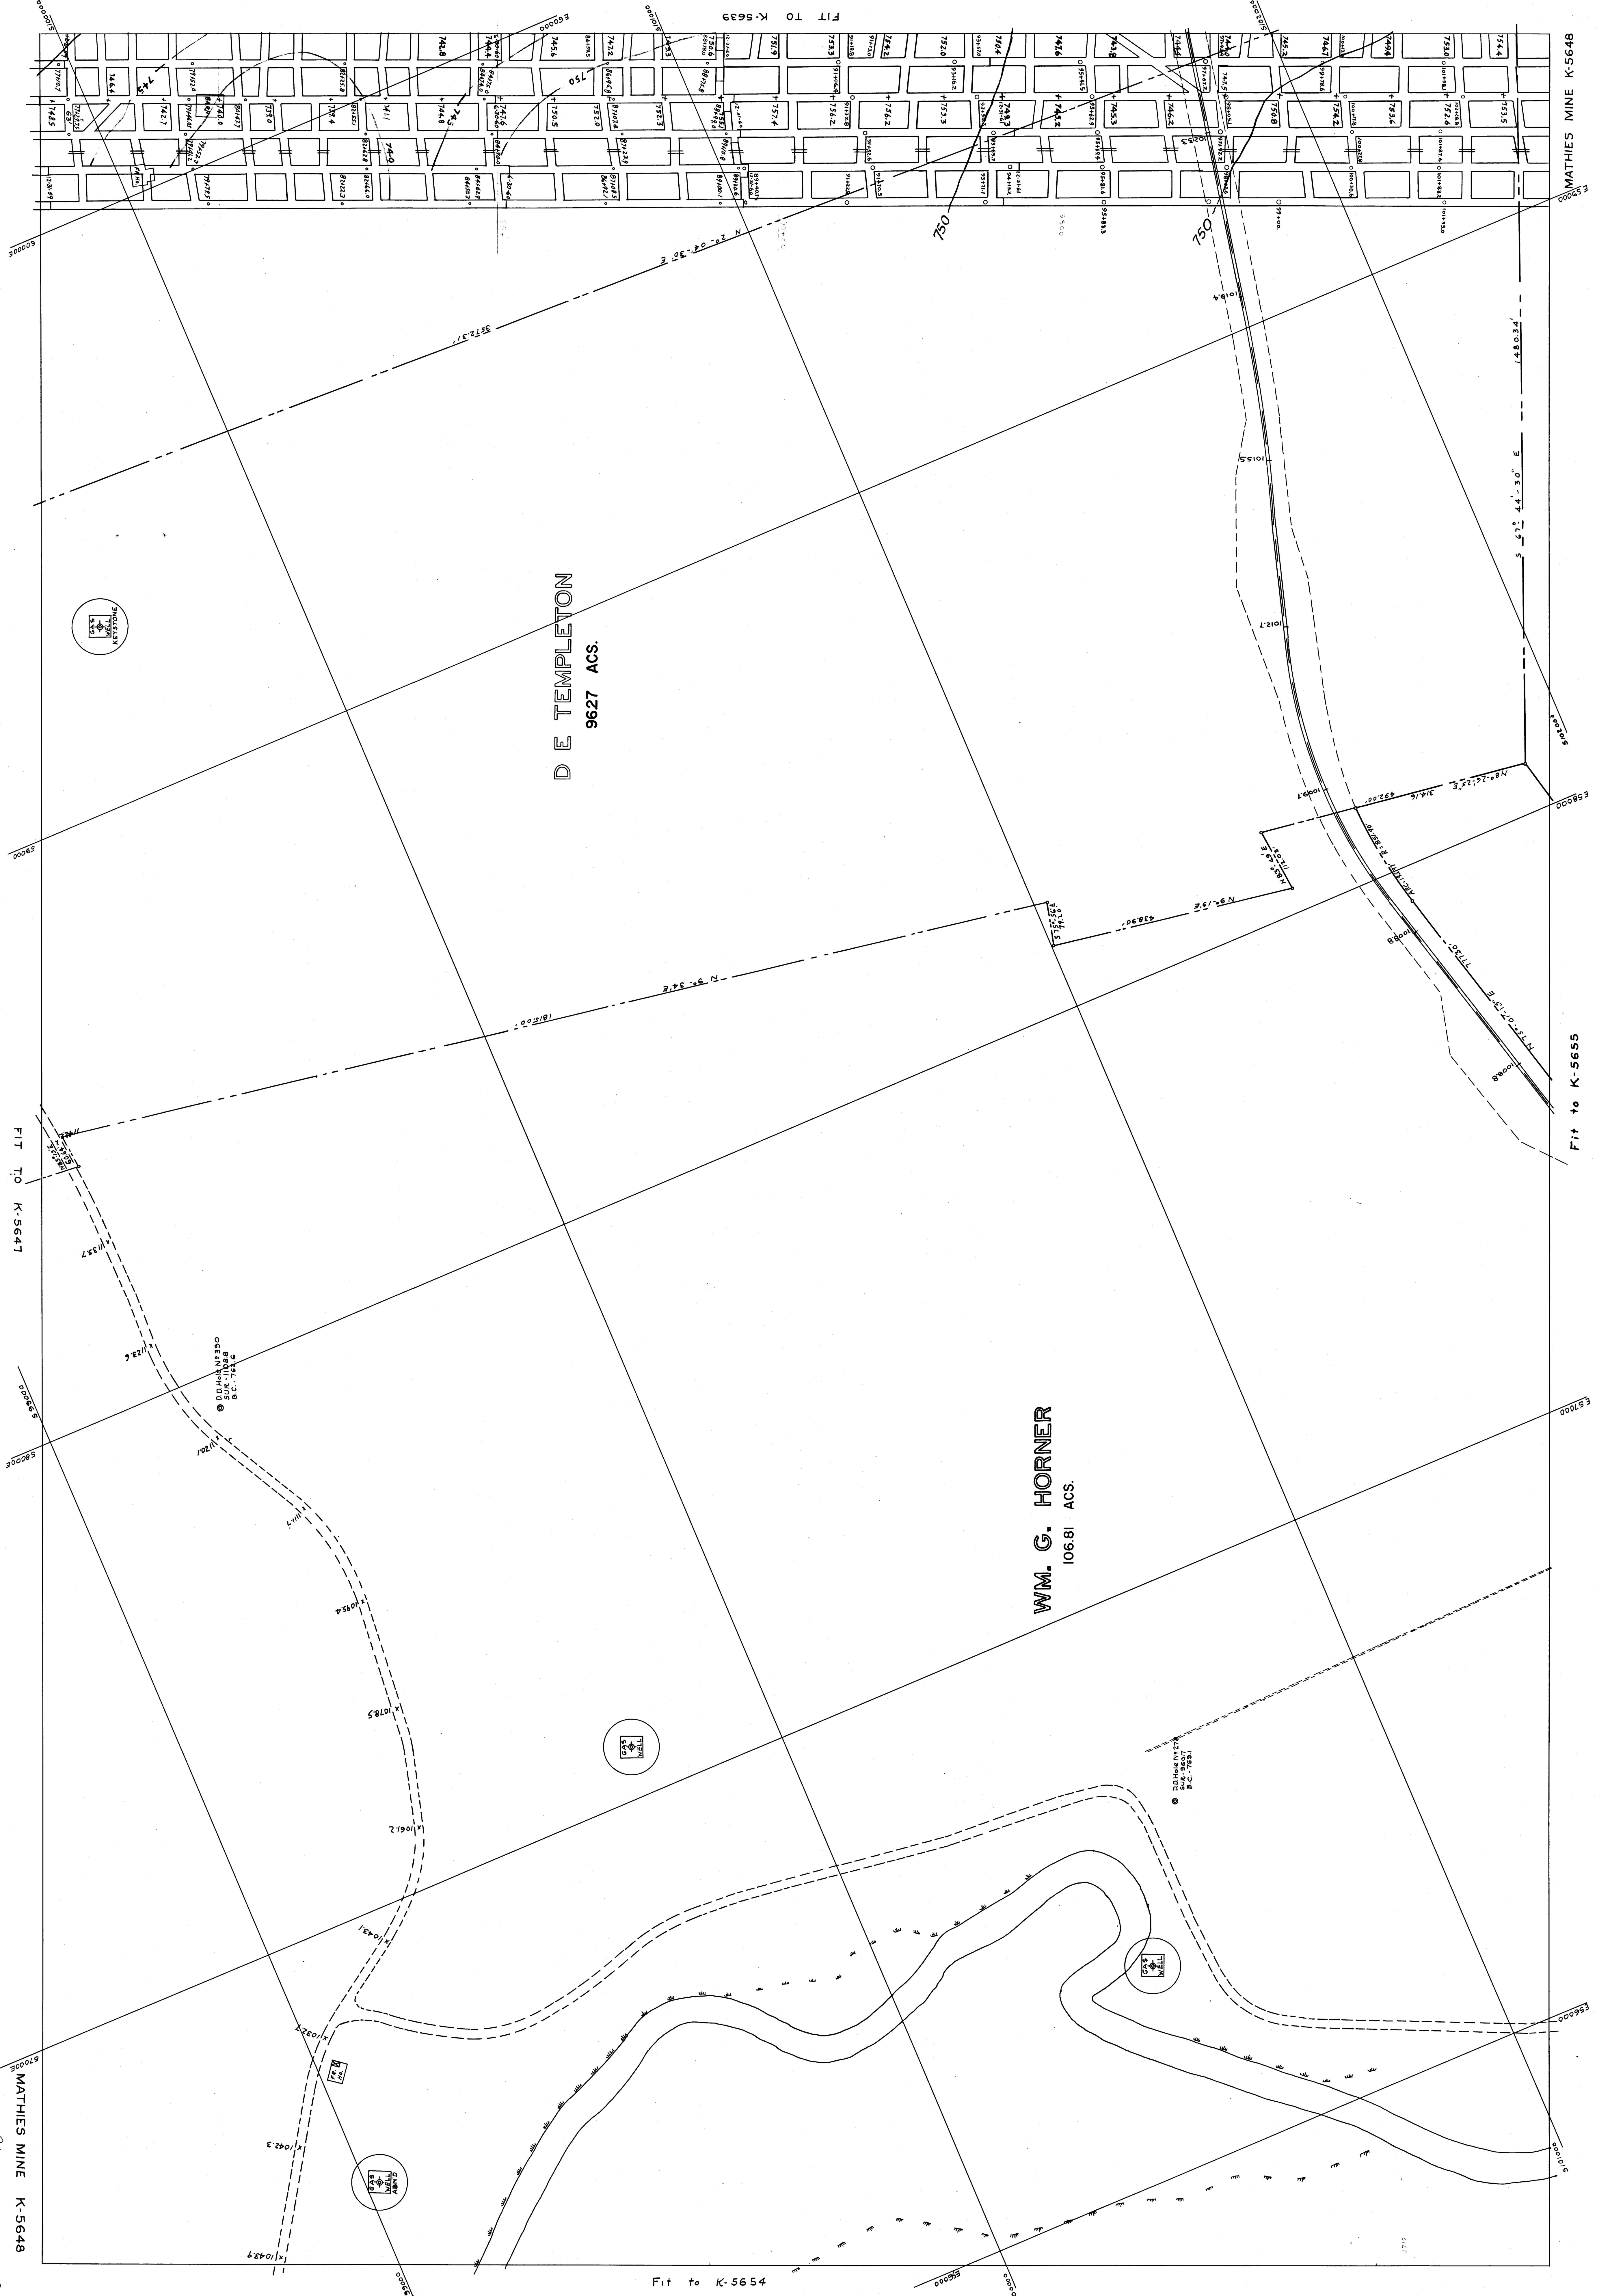

D E TEMPLETON
9627 ACS.

WM. G. HORNER
106.81 ACS.

MATHIES MINE K-5648

Fit to K-5655

Fit to K-5647

Fit to K-5654

SEE NEW PLASTIC K-5648

MATHIES MINE K-5648