


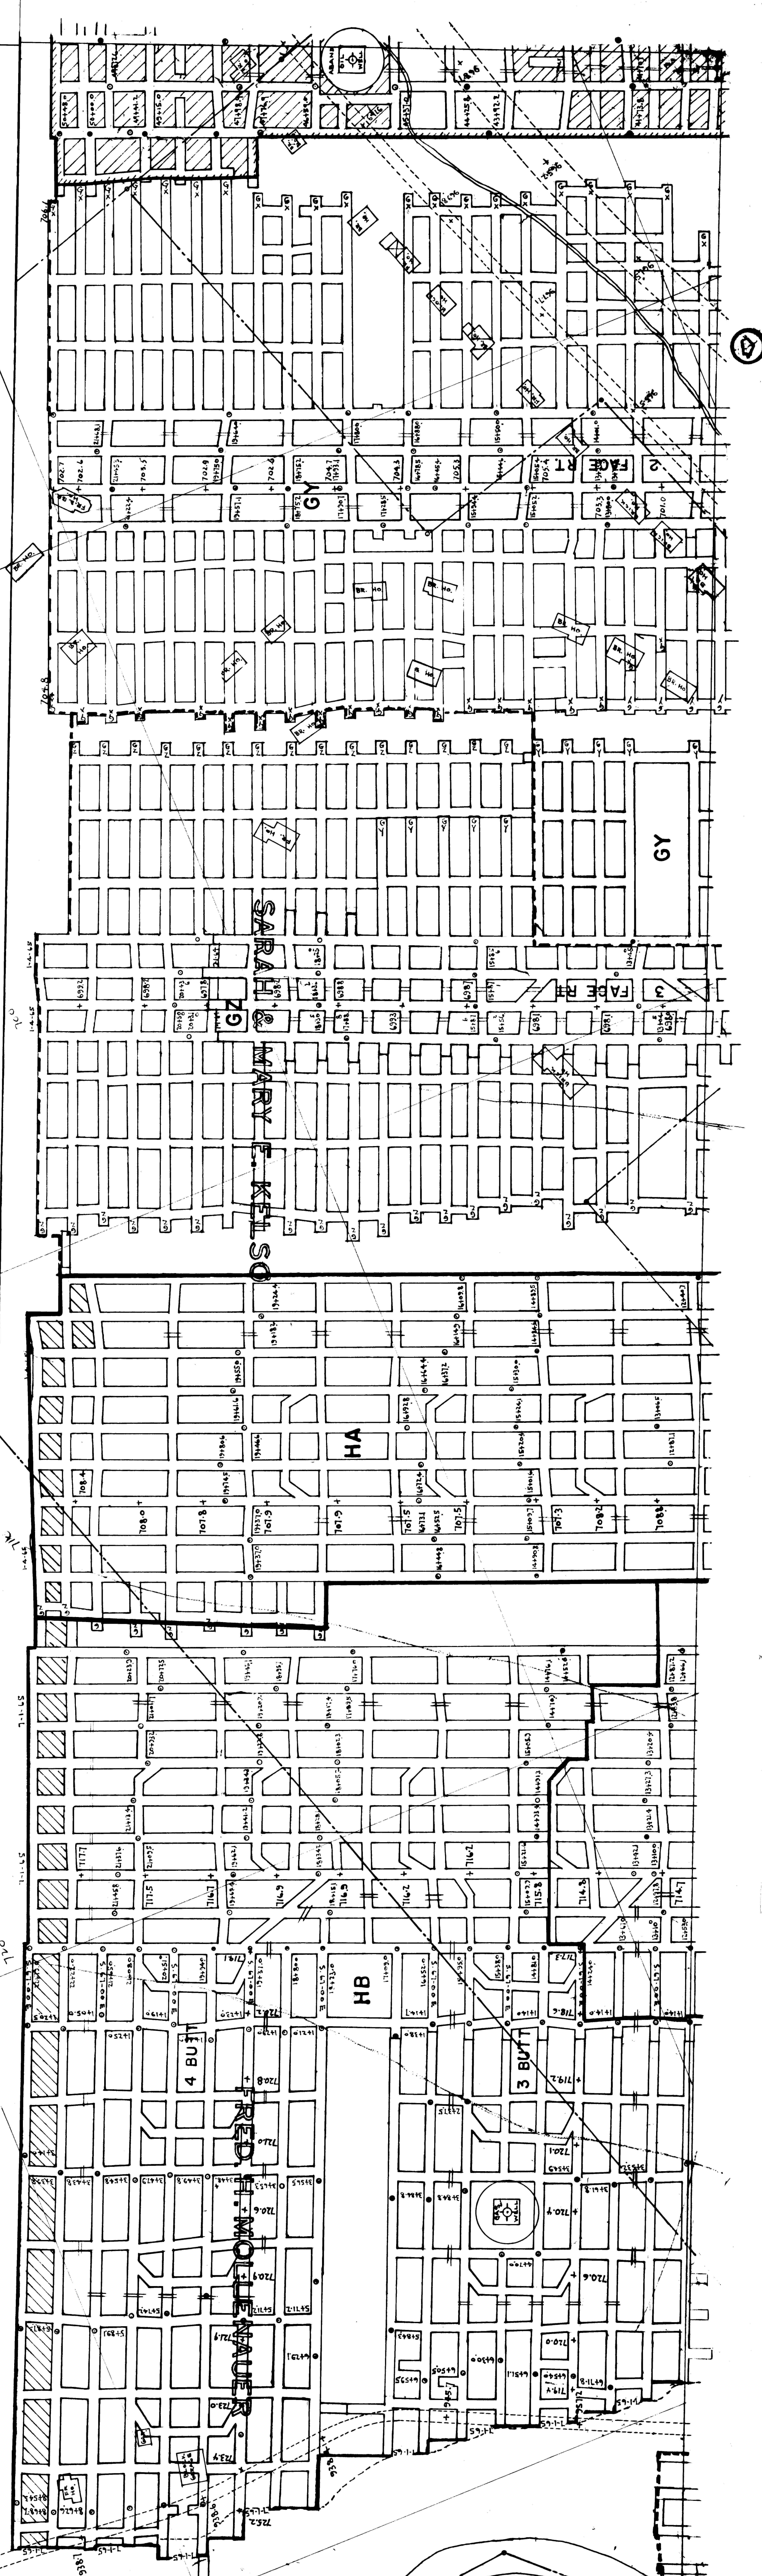

AMCIELLELAND

FIT TO K-5577

N 71° 41' 20" E

1666.09

S 46° 00' 40" E 1397.63

FIT TO K-5645

7600.0

MATHIES COAL CO. SURF.
2.35 ACS.

N 63° 40' W

N 63° 40' W

S 12° 55' 26" E

FIT TO K-5644

MATHIES MINE K-5646
See Also Plat K-5646