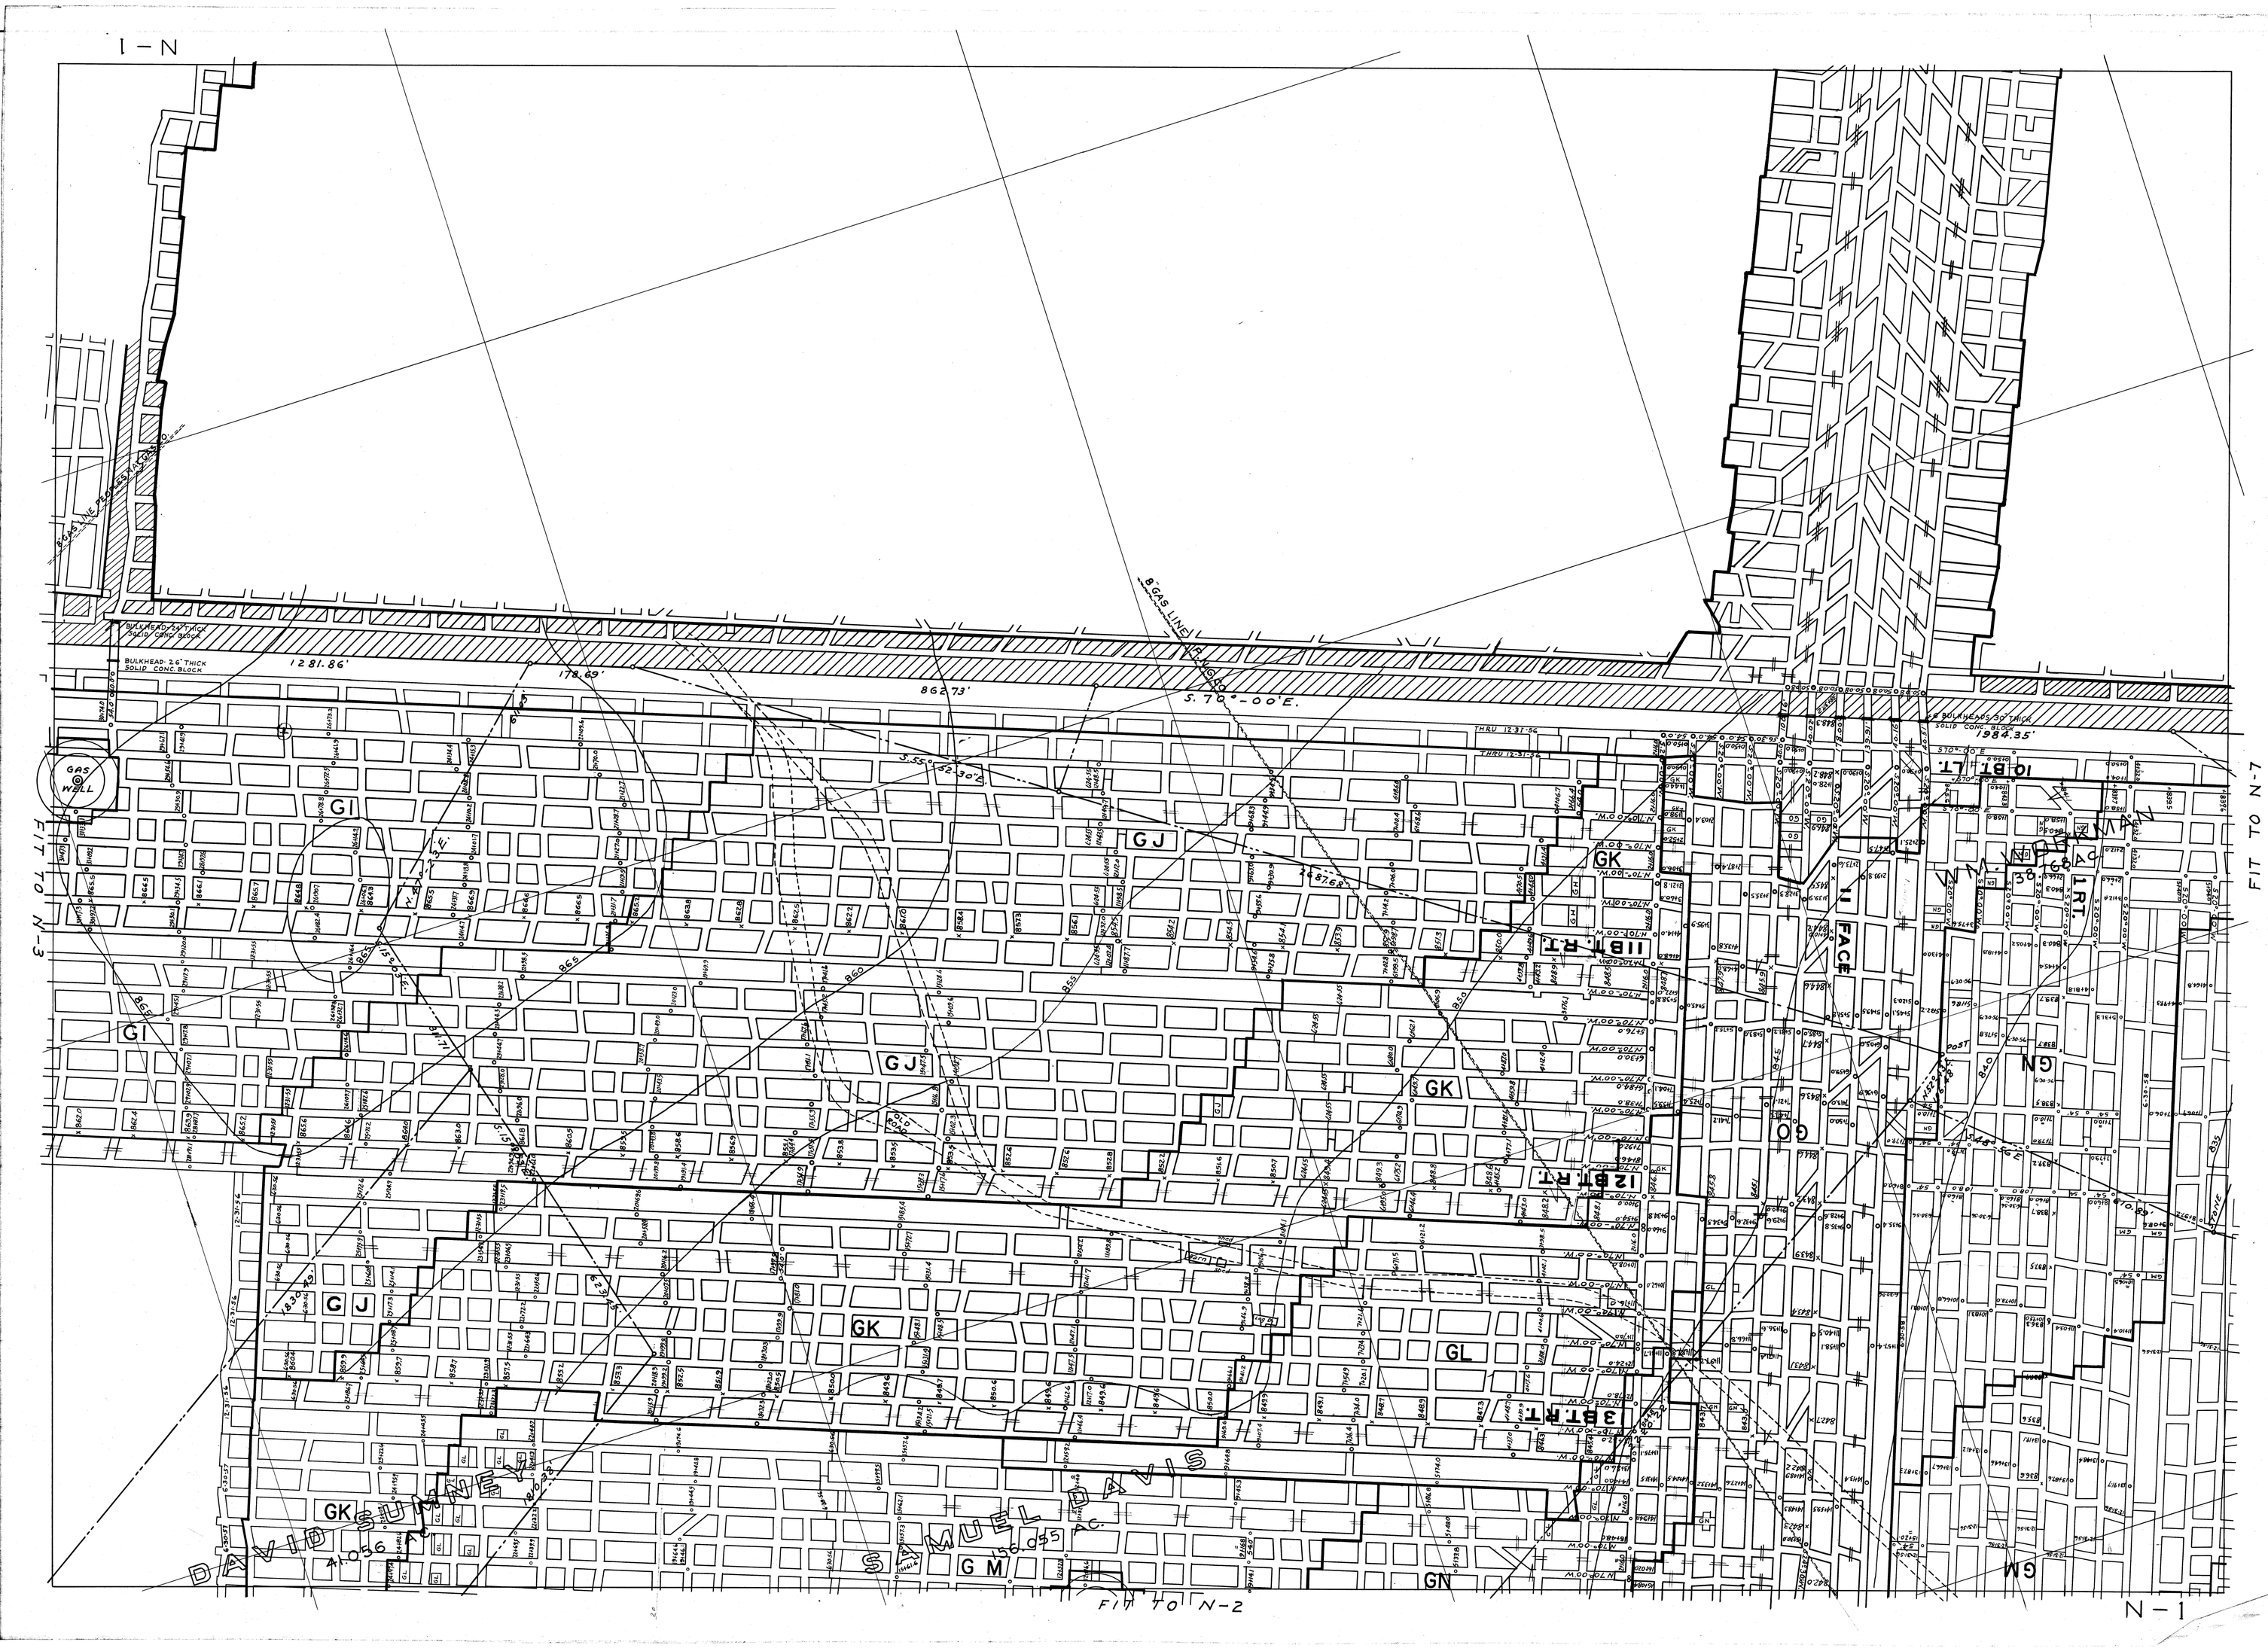
I-N
FIT TO N-3
FIT TO N-7
FIT TO N-2
N-1
8" GAS LINE
BULKHEAD 2.6' THICK SOLID CONC. BLOCK
BULKHEAD 2.5' THICK SOLID CONC. BLOCK
BULKHEAD 2.5' THICK SOLID CONC. BLOCK
12 81.86'
178.69'
862.73'
S. 70°-00'E.
1984.35'
GAS WELL
GI
GJ
GK
GL
GM
GN
GO
10 BT. LT.
11 BT. RT.
12 BT. RT.
13 BT. RT.
11 FACE
SAMUEL DAVIS
