


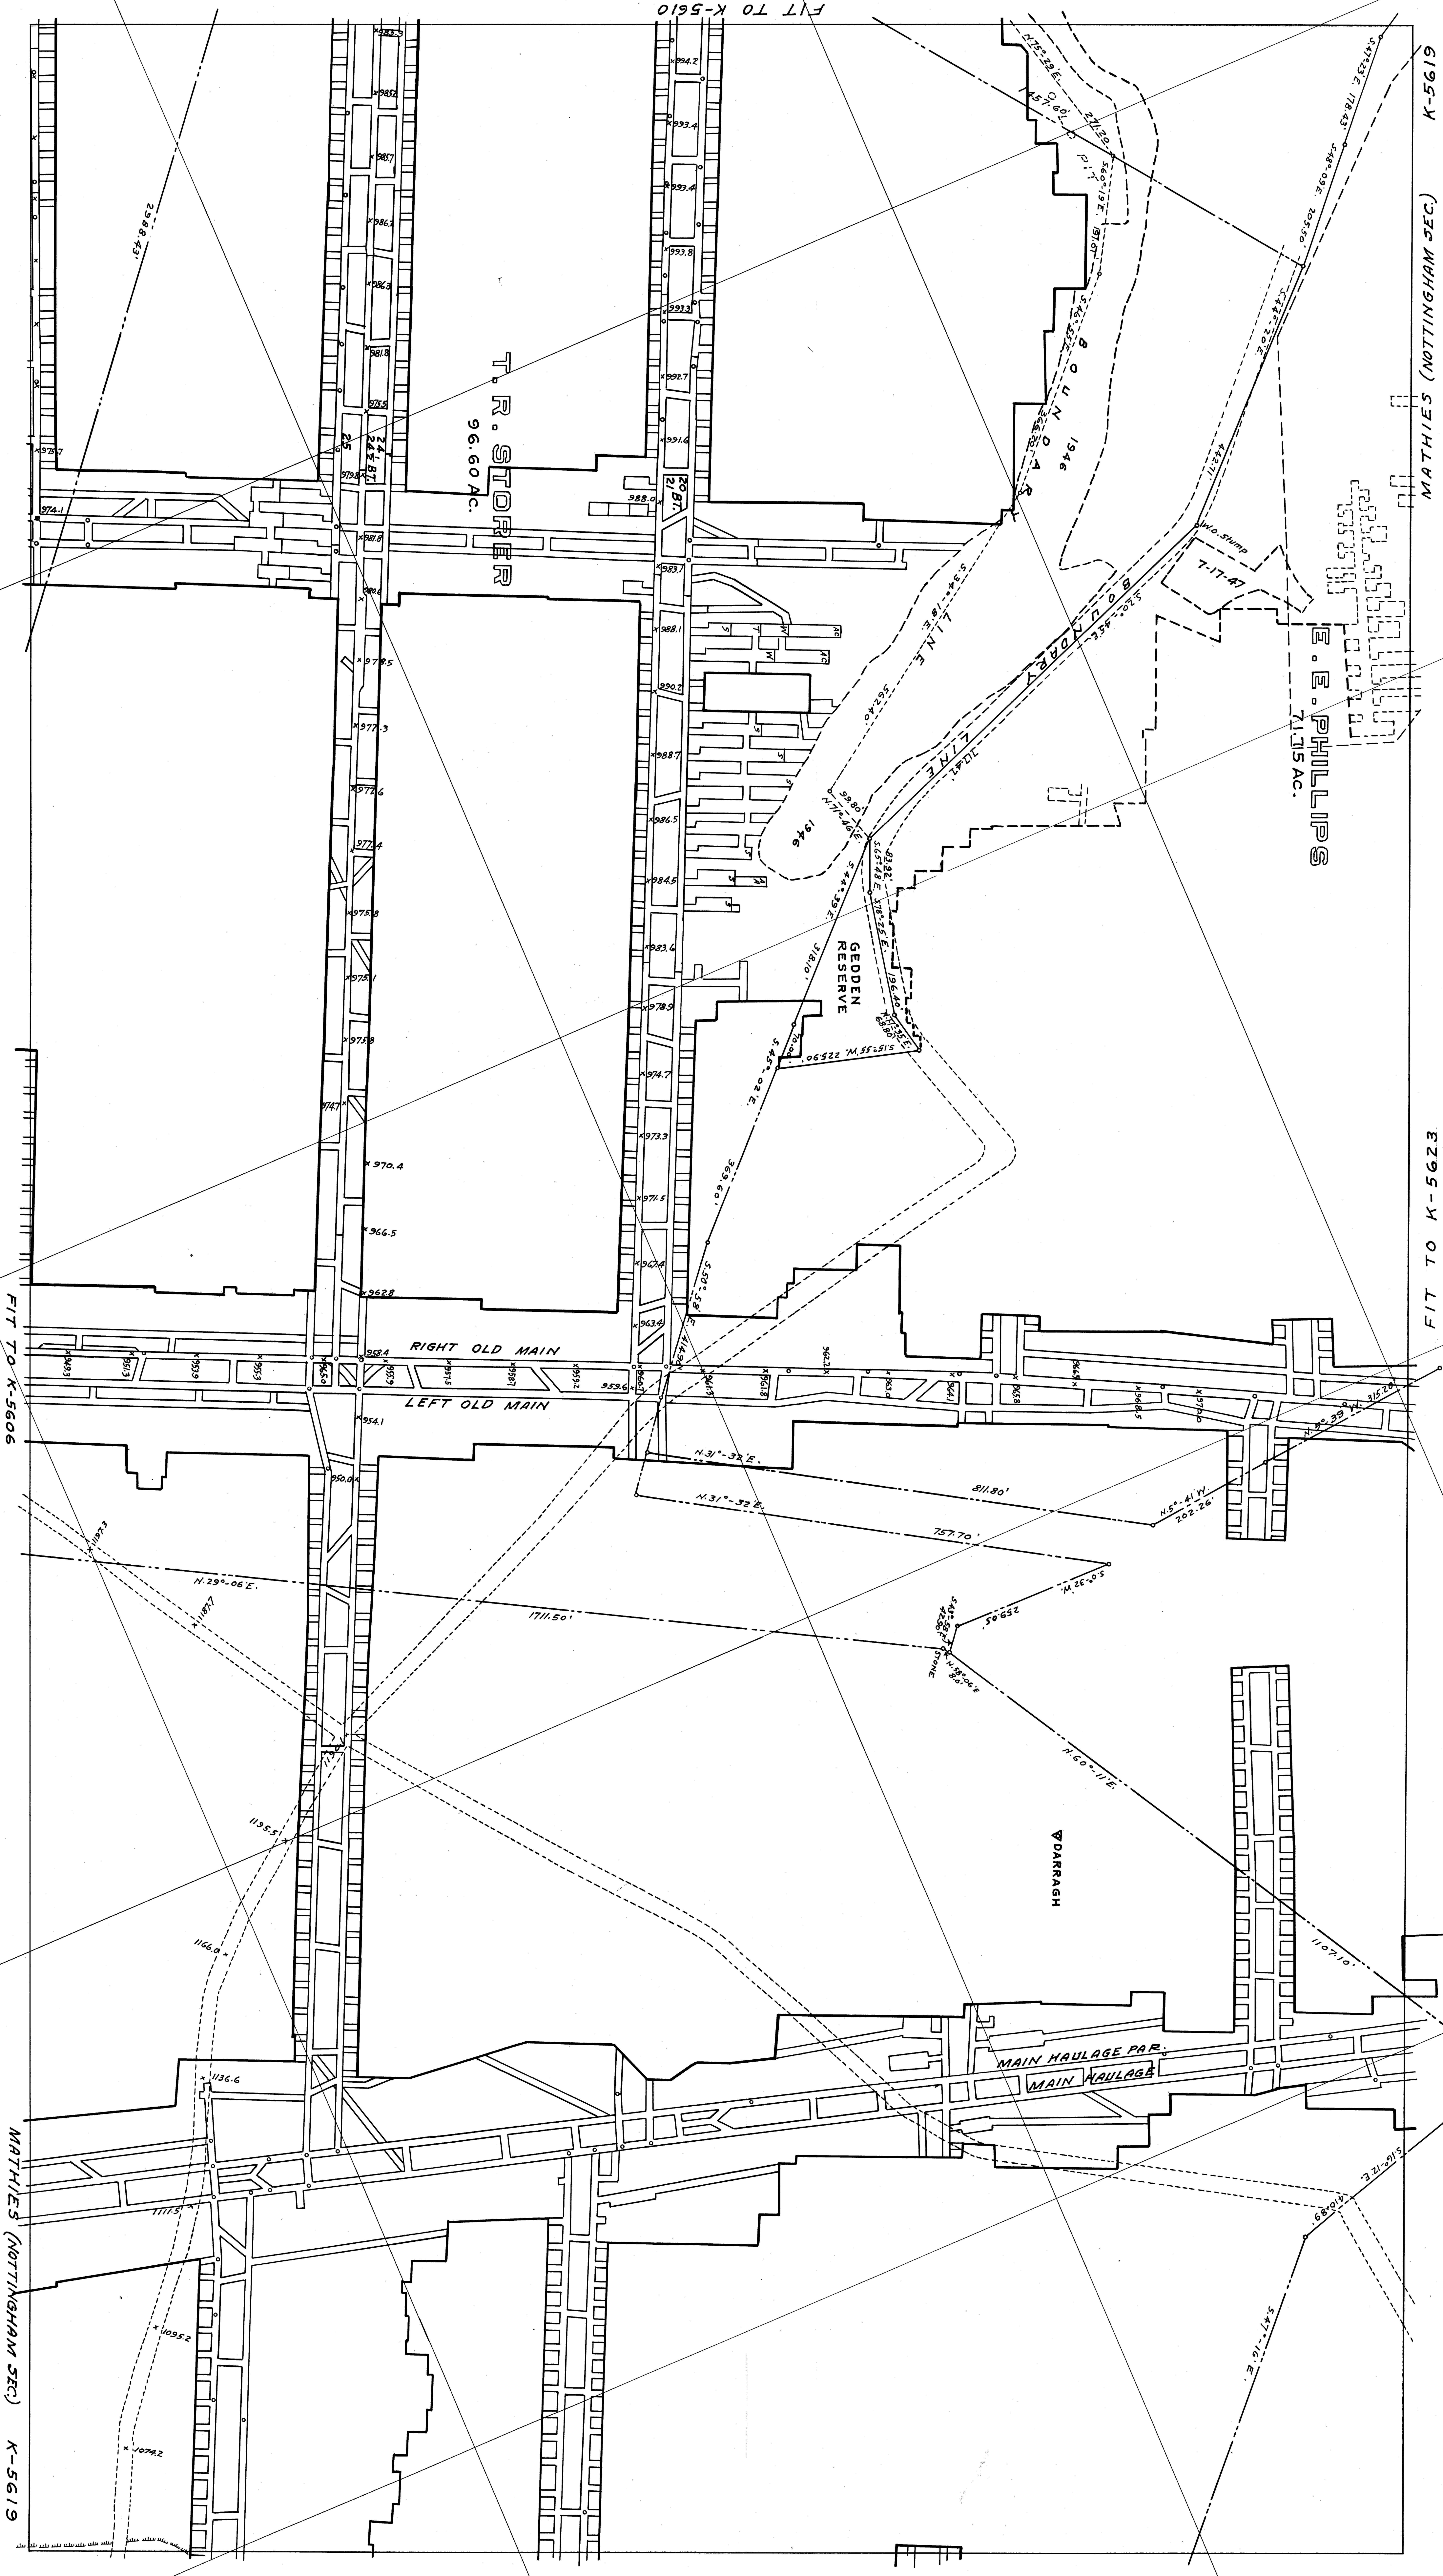

MATHIES (NOTTINGHAM SEC.) K-5619

FIT TO K-5623

FIT TO K-5606

MATHIES (NOTTINGHAM SEC.) K-5619

VOID See PLASTIC