

FIT TO K-5603

PETER DARR HRS.

104.76A.


FIT TO 5620

MATHIES MINE K-5605

MATHIES MINE K-5605

FIT TO K-5585

FIT TO K-5606

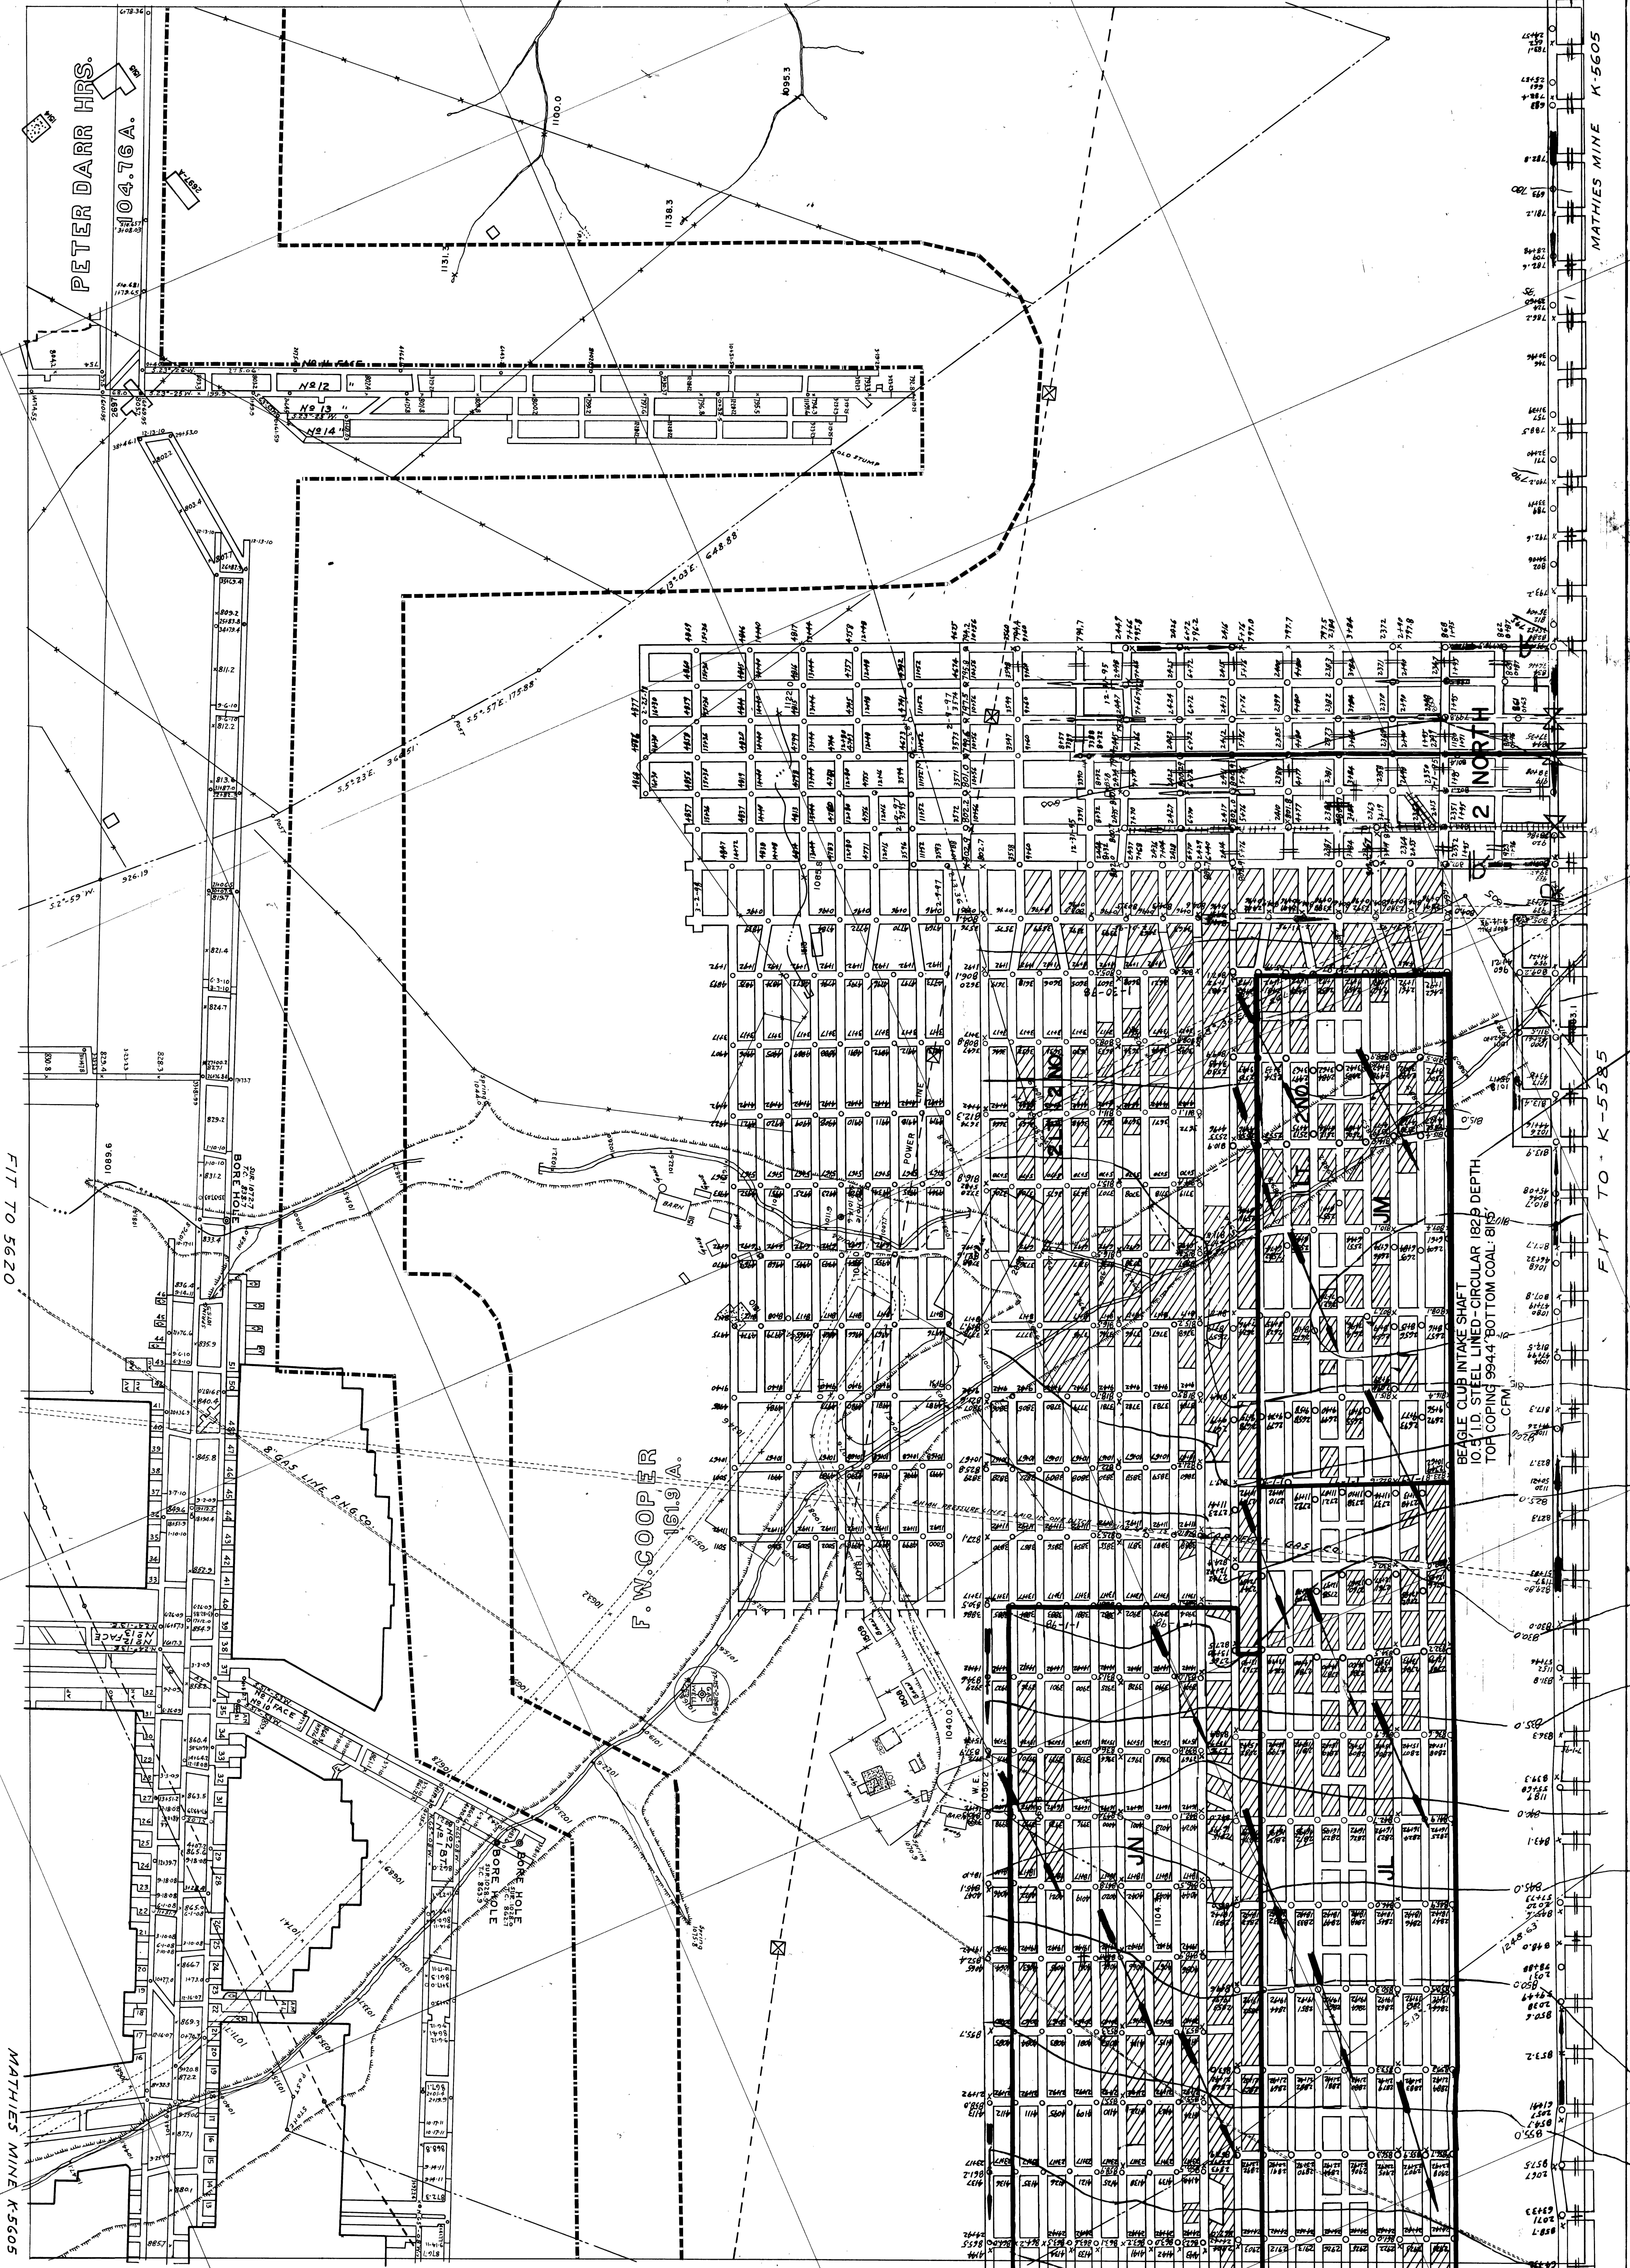

BEAGLE CLUB IN TAKE SHAFT
10.8 I.D. STEEL LINED - CIRCULAR 182.9 DEPTH
TOP COPING 994.4' BOTTOM COAL: 815.5'
CFM

F.W. COOPER

NORTH

PETER DARR HRS.

104.76A.

FIT TO 5620

MATHIES MINE K-5605

MATHIES MINE K-5605

FIT TO K-5585

FIT TO K-5606