



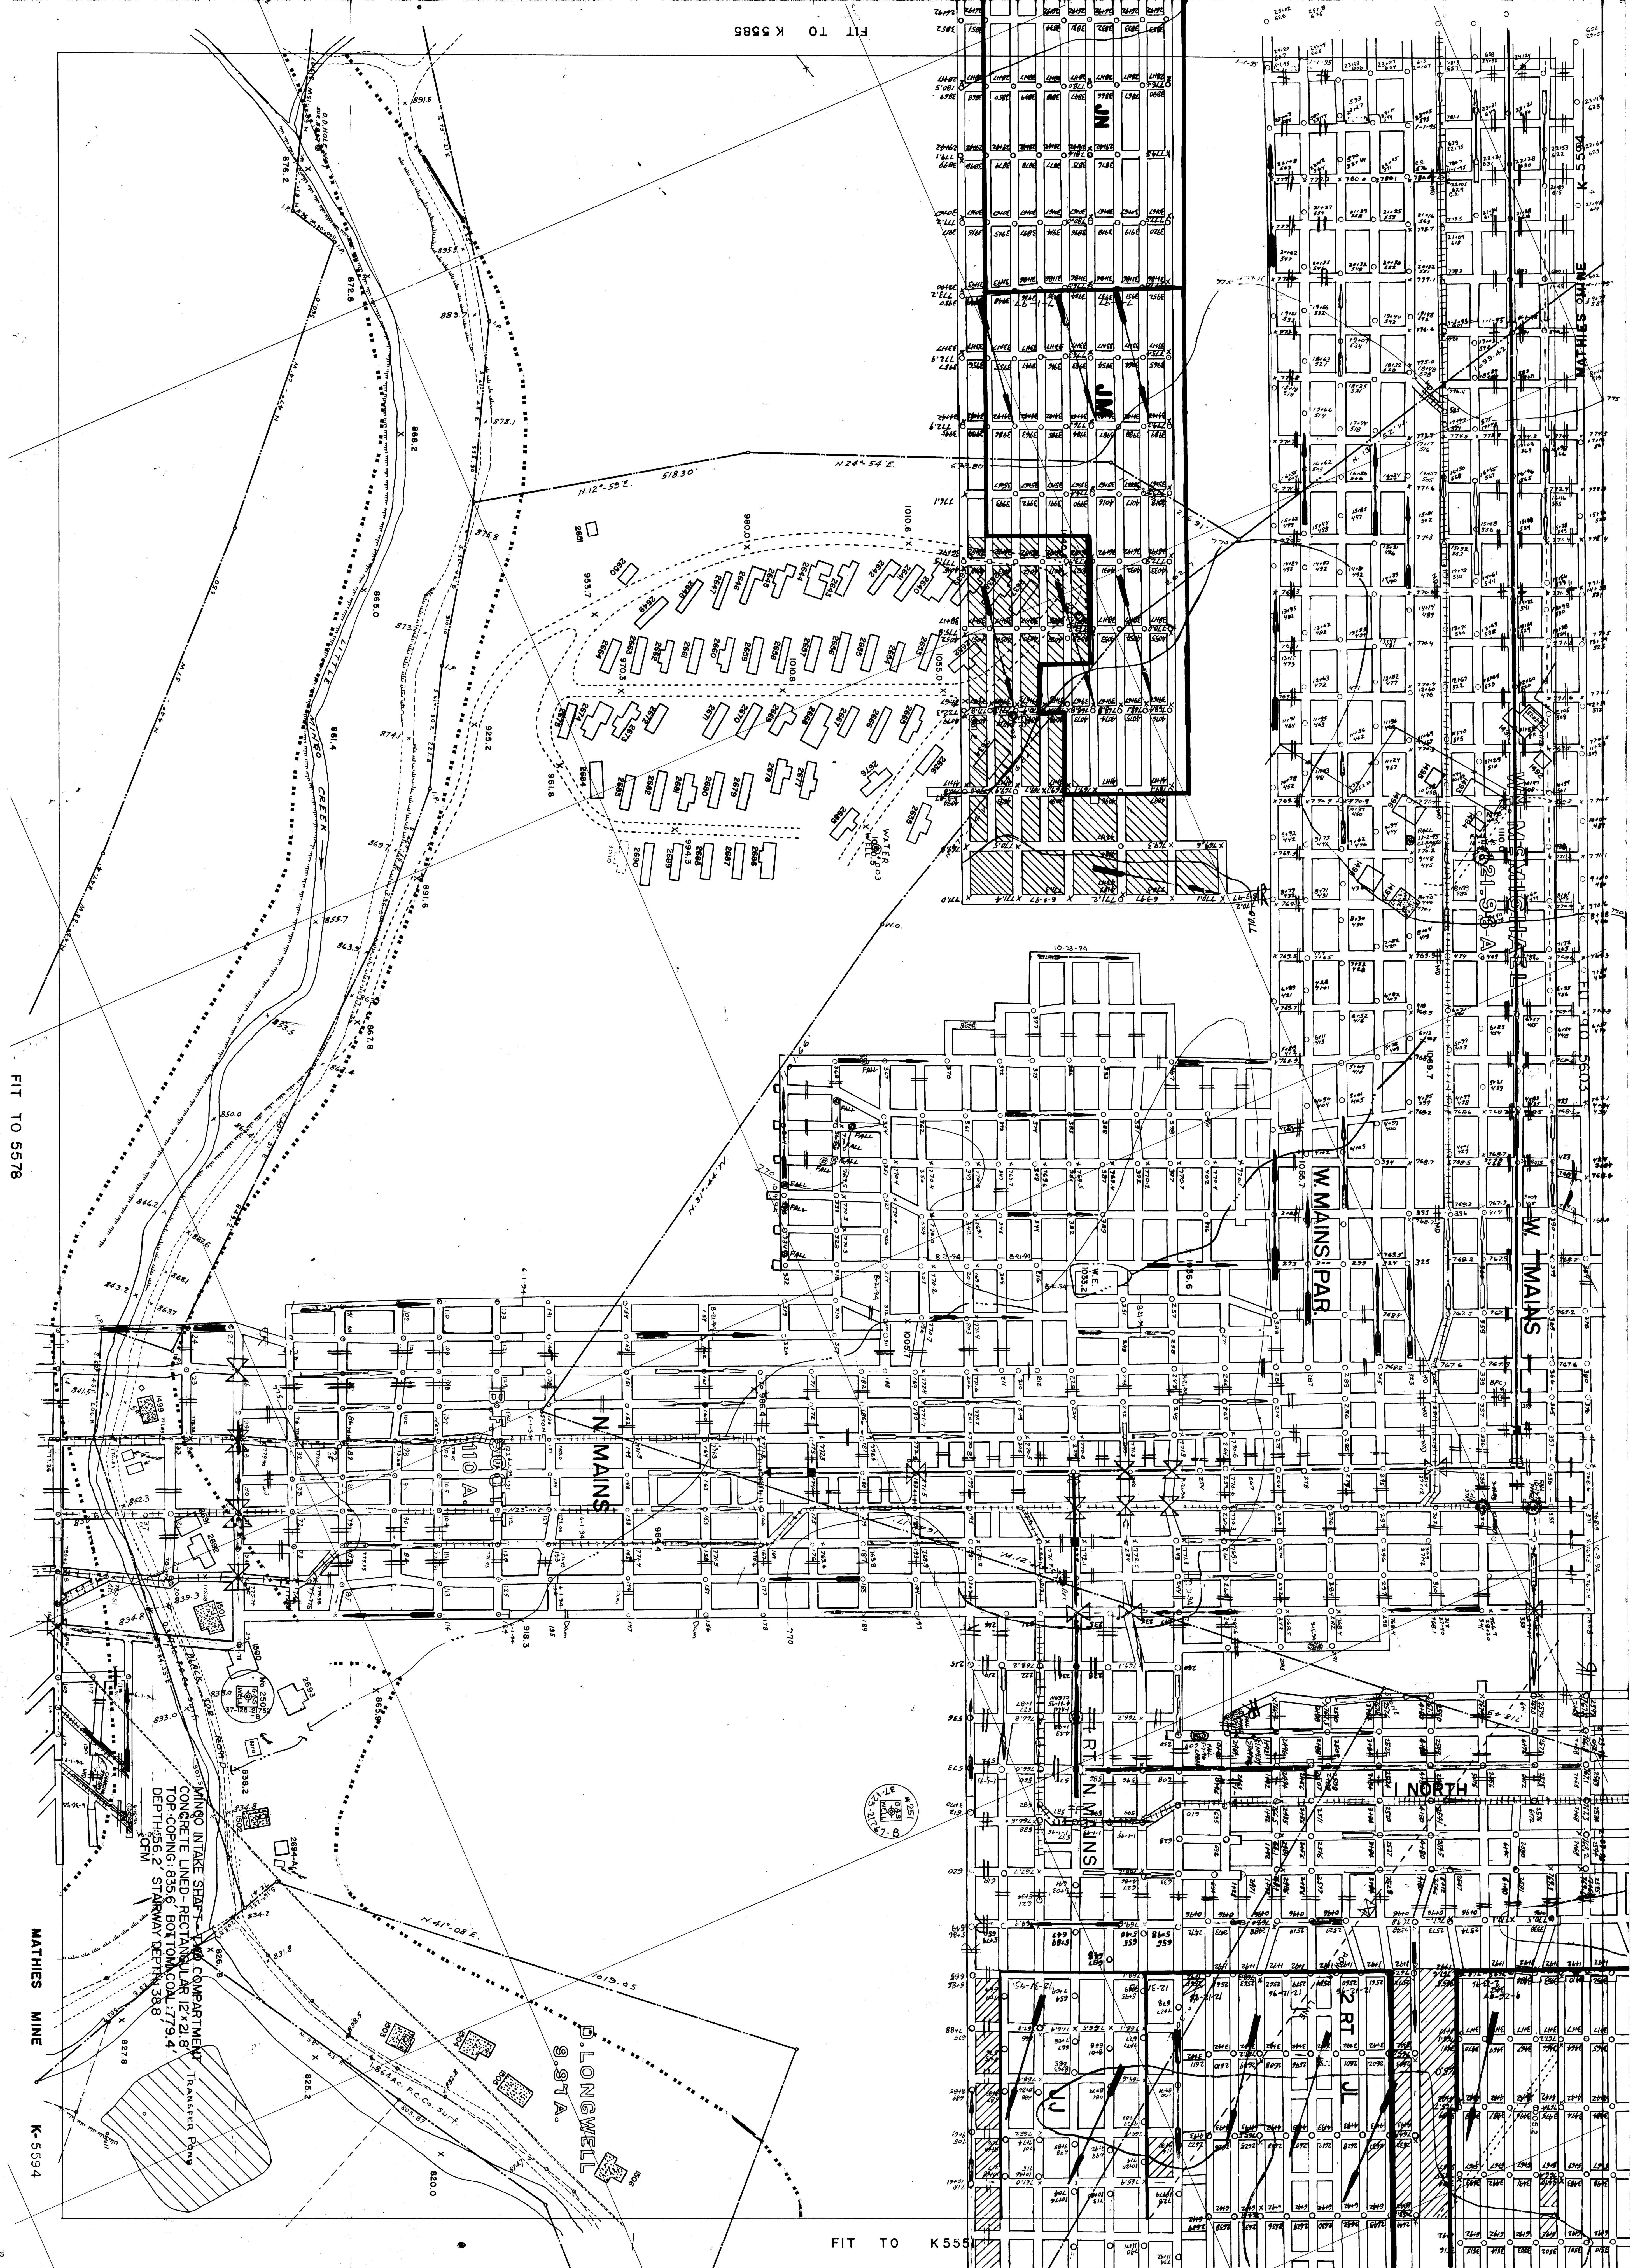

FIT TO K 5585