


UNITED STATES  
DEPARTMENT OF THE INTERIOR  
GEOLOGICAL SURVEY

CLYMER QUADRANGLE  
PENNSYLVANIA-INDIANA CO.  
7.5 MINUTE SERIES (TOPOGRAPHIC)  
NE 1/4 INDIANA 15' QUADRANGLE

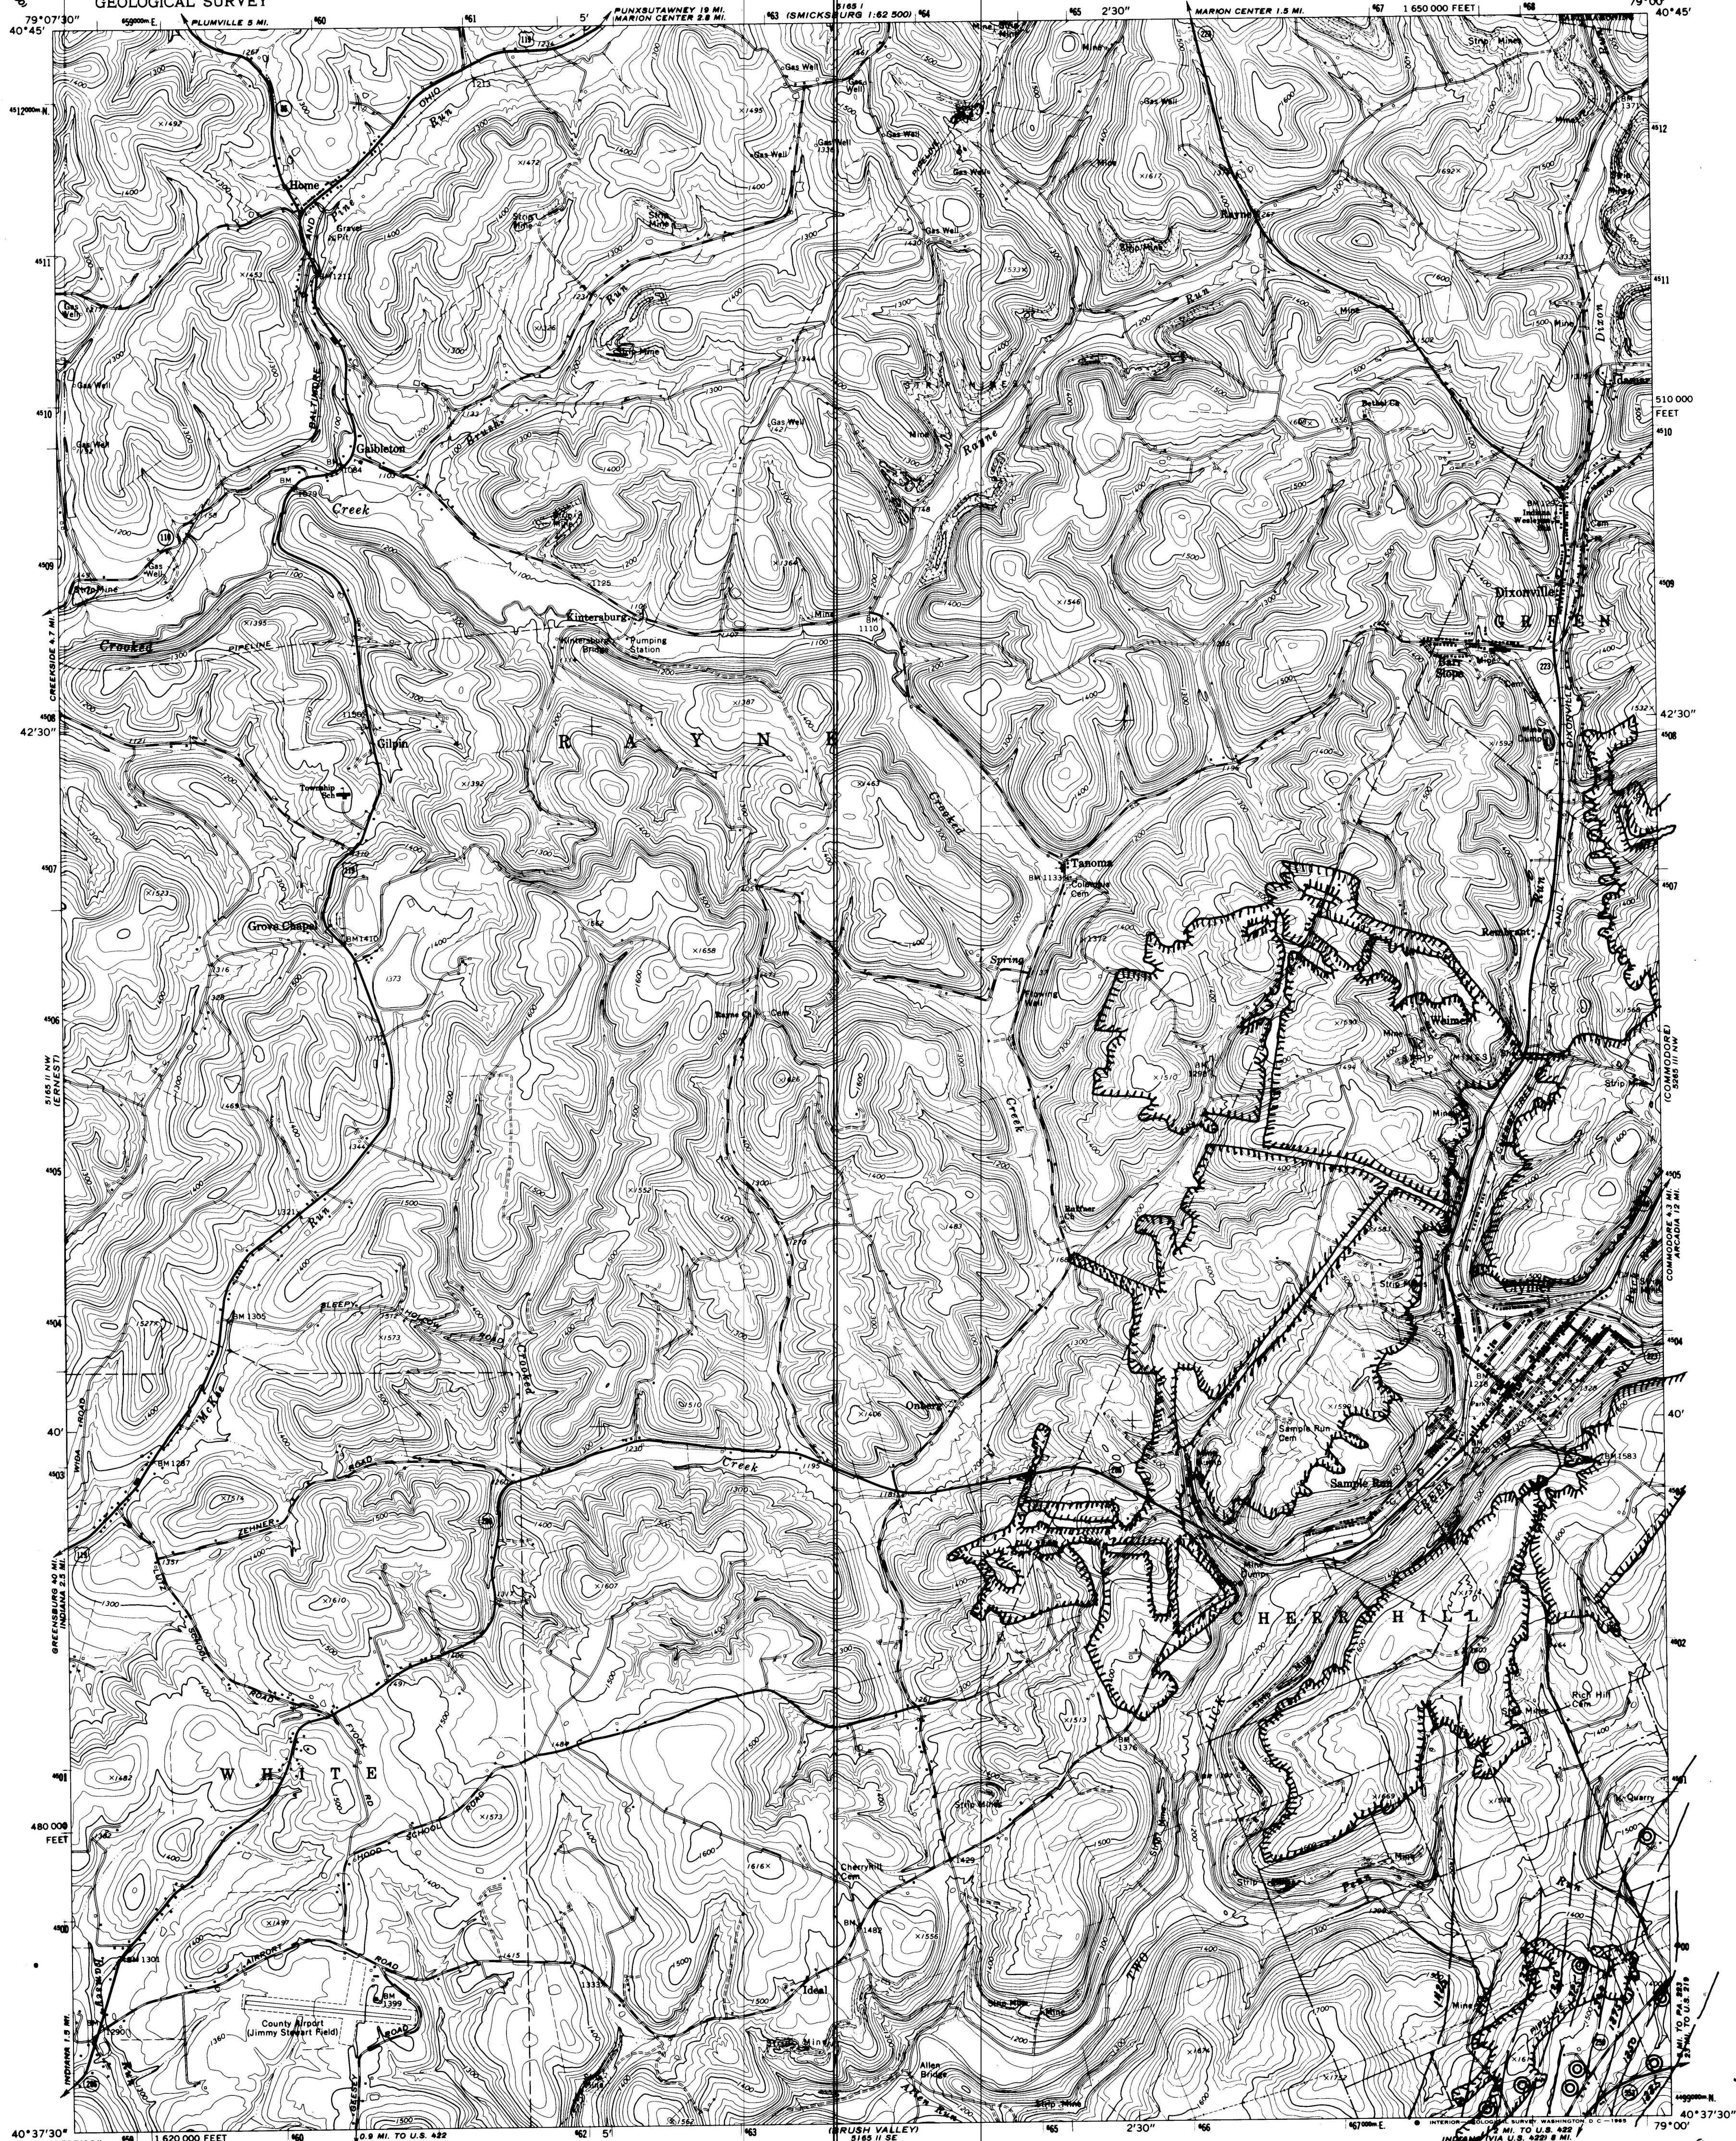


Maped, edited, and published by the Geological Survey  
Control by USGS and USC&GS  
Topography by photogrammetric methods from aerial  
photographs taken 1961. Field checked 1963.  
Polyconic projection. 1927 North American datum.  
10,000-foot grid based on Pennsylvania coordinate system, south zone  
1000-meter Universal Transverse Mercator grid ticks,  
zone 17, shown in blue.  
Fine red dashed lines indicate selected fence and field lines where  
generally visible on aerial photographs. This information is unchecked.

UTM GRID AND 1963 MAGNETIC NORTH  
DECLINATION AT CENTER OF SHEET

SCALE 1:24,000  
CONTOUR INTERVAL 20 FEET  
DATUM IS MEAN SEA LEVEL

ROAD CLASSIFICATION  
Heavy-duty ——— Light-duty ———  
Medium-duty ——— Unimproved dirt ———  
U.S. Route ——— State Route ———

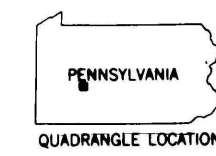

CLYMER, PA.  
NE 1/4 INDIANA 15' QUADRANGLE  
N4037.5-W7900/7.5

1963  
AMS 5165 II NE—SERIES V831