


FIT TO K5608

MATHIES MINE K-5550

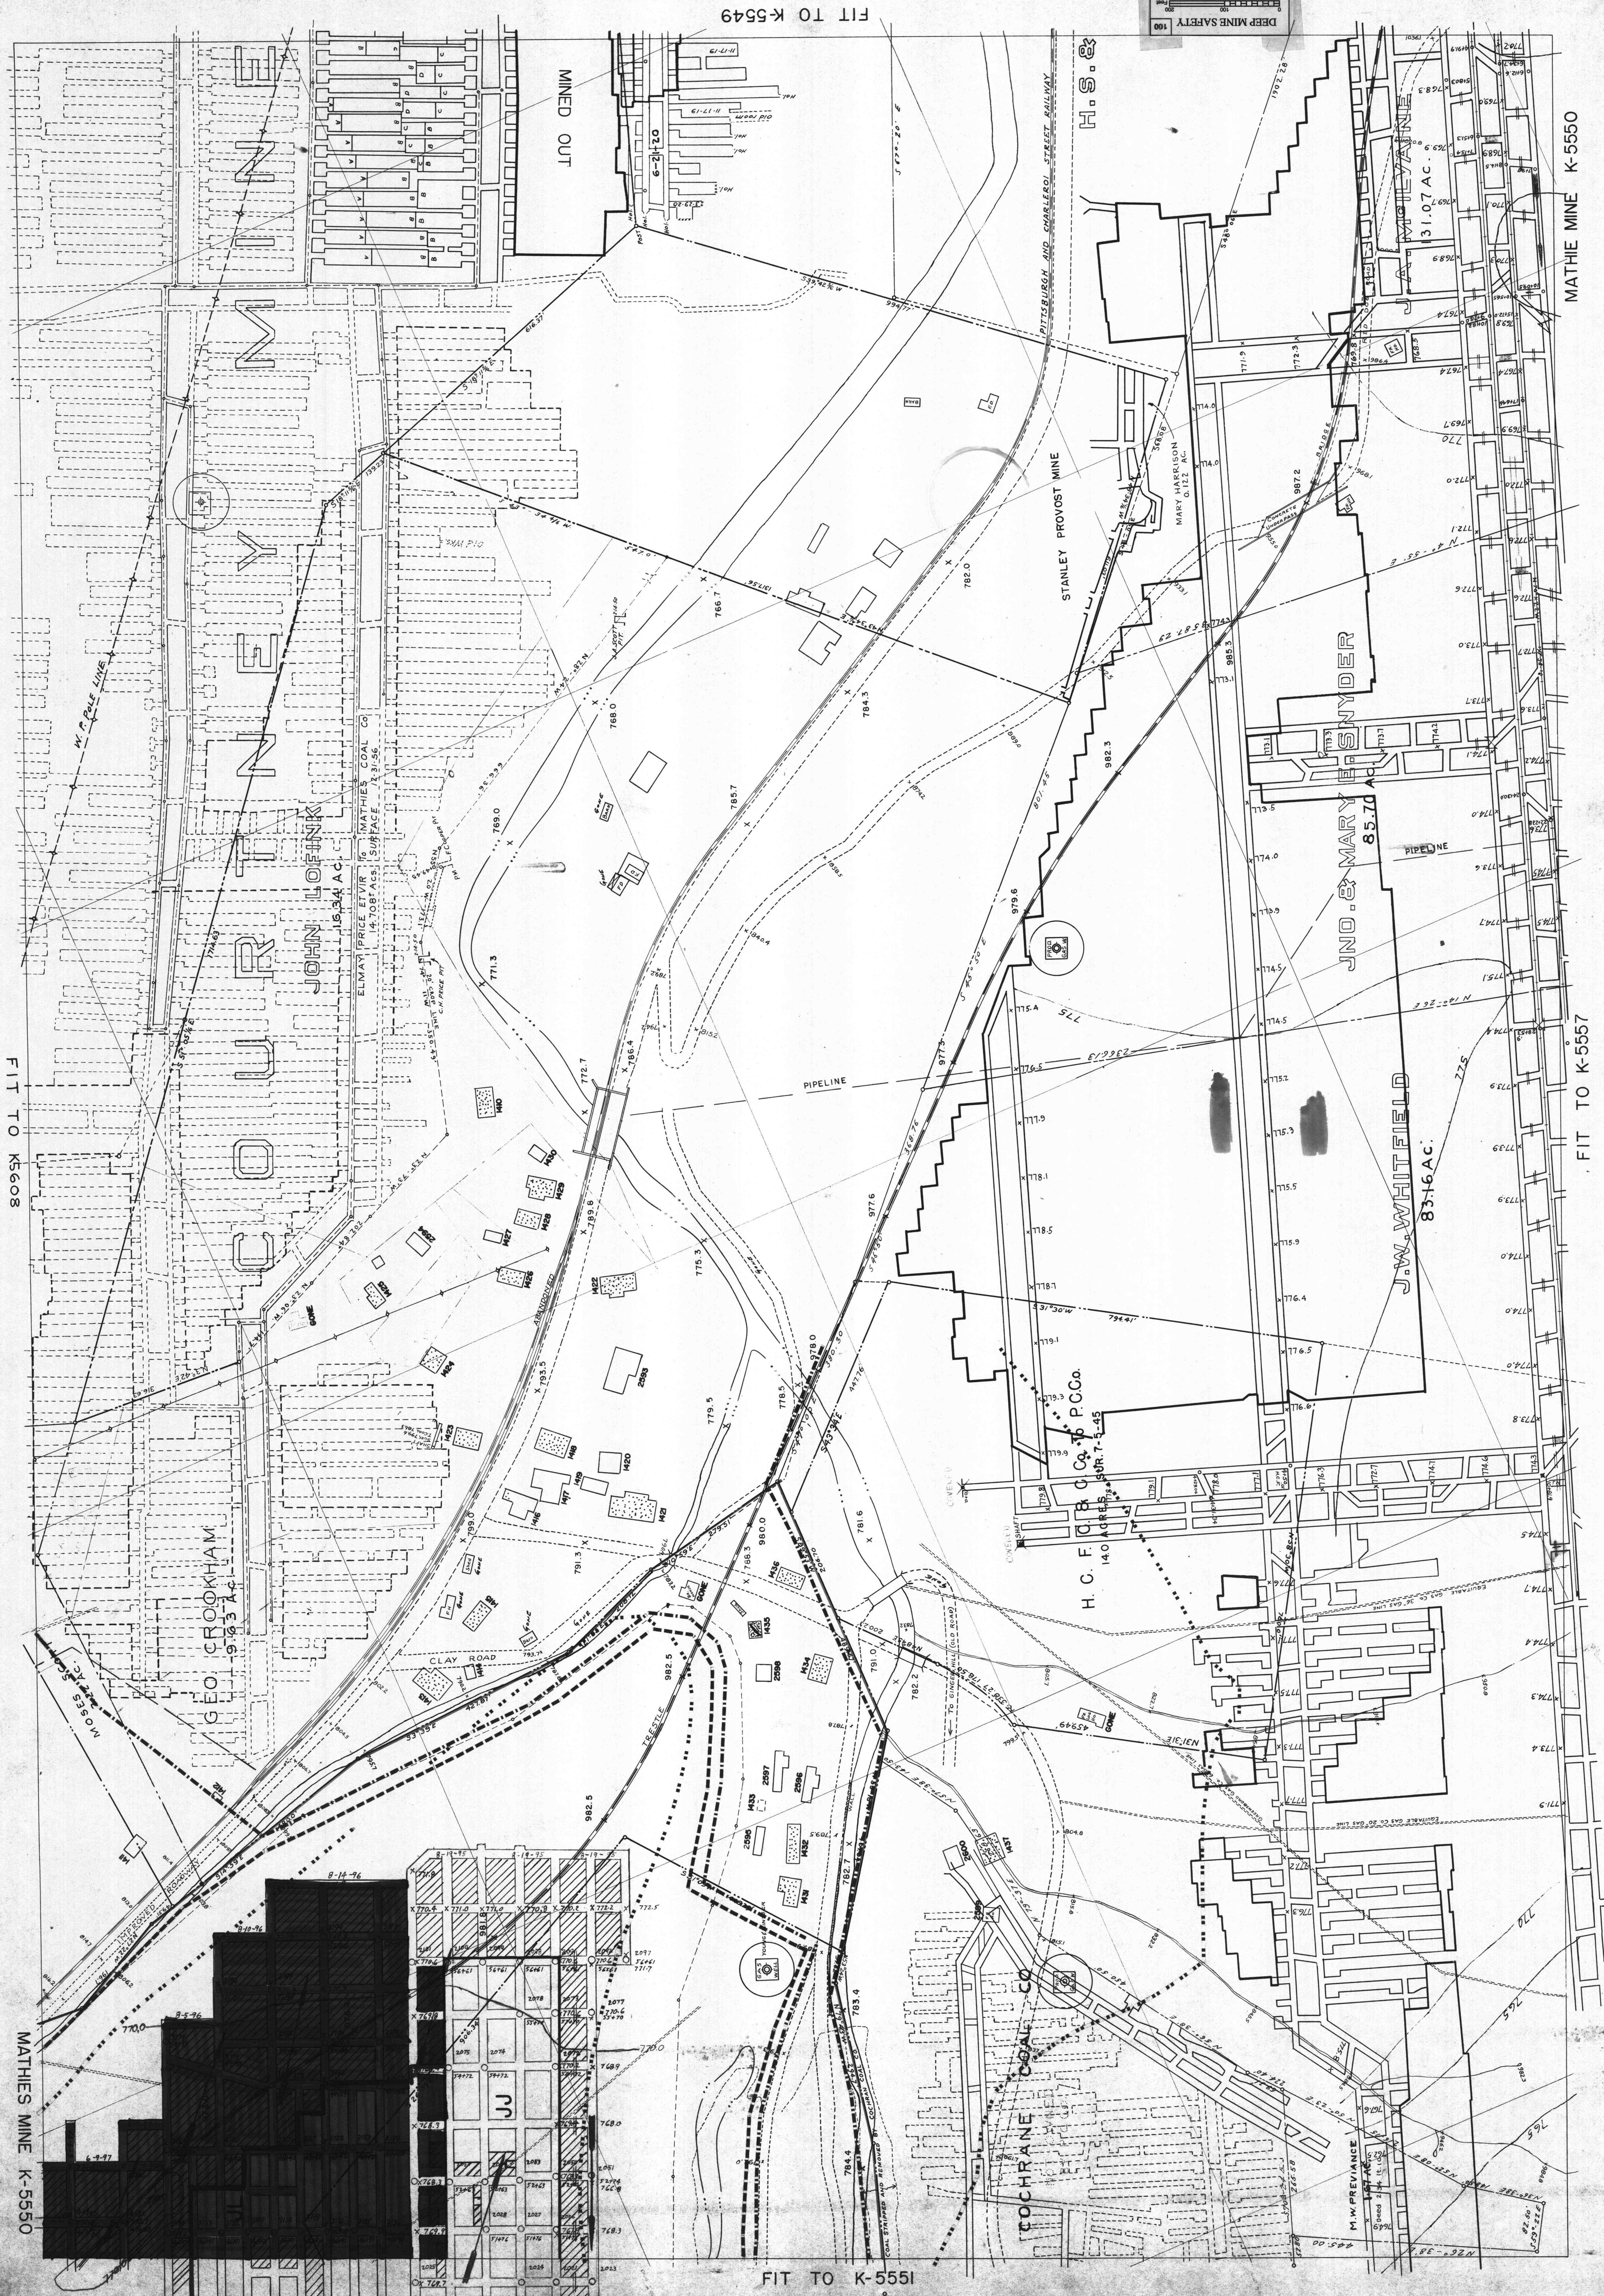

FIT TO K-5549

FIT TO K-5551

MATHIE MINE K-5550

FIT TO K-5557