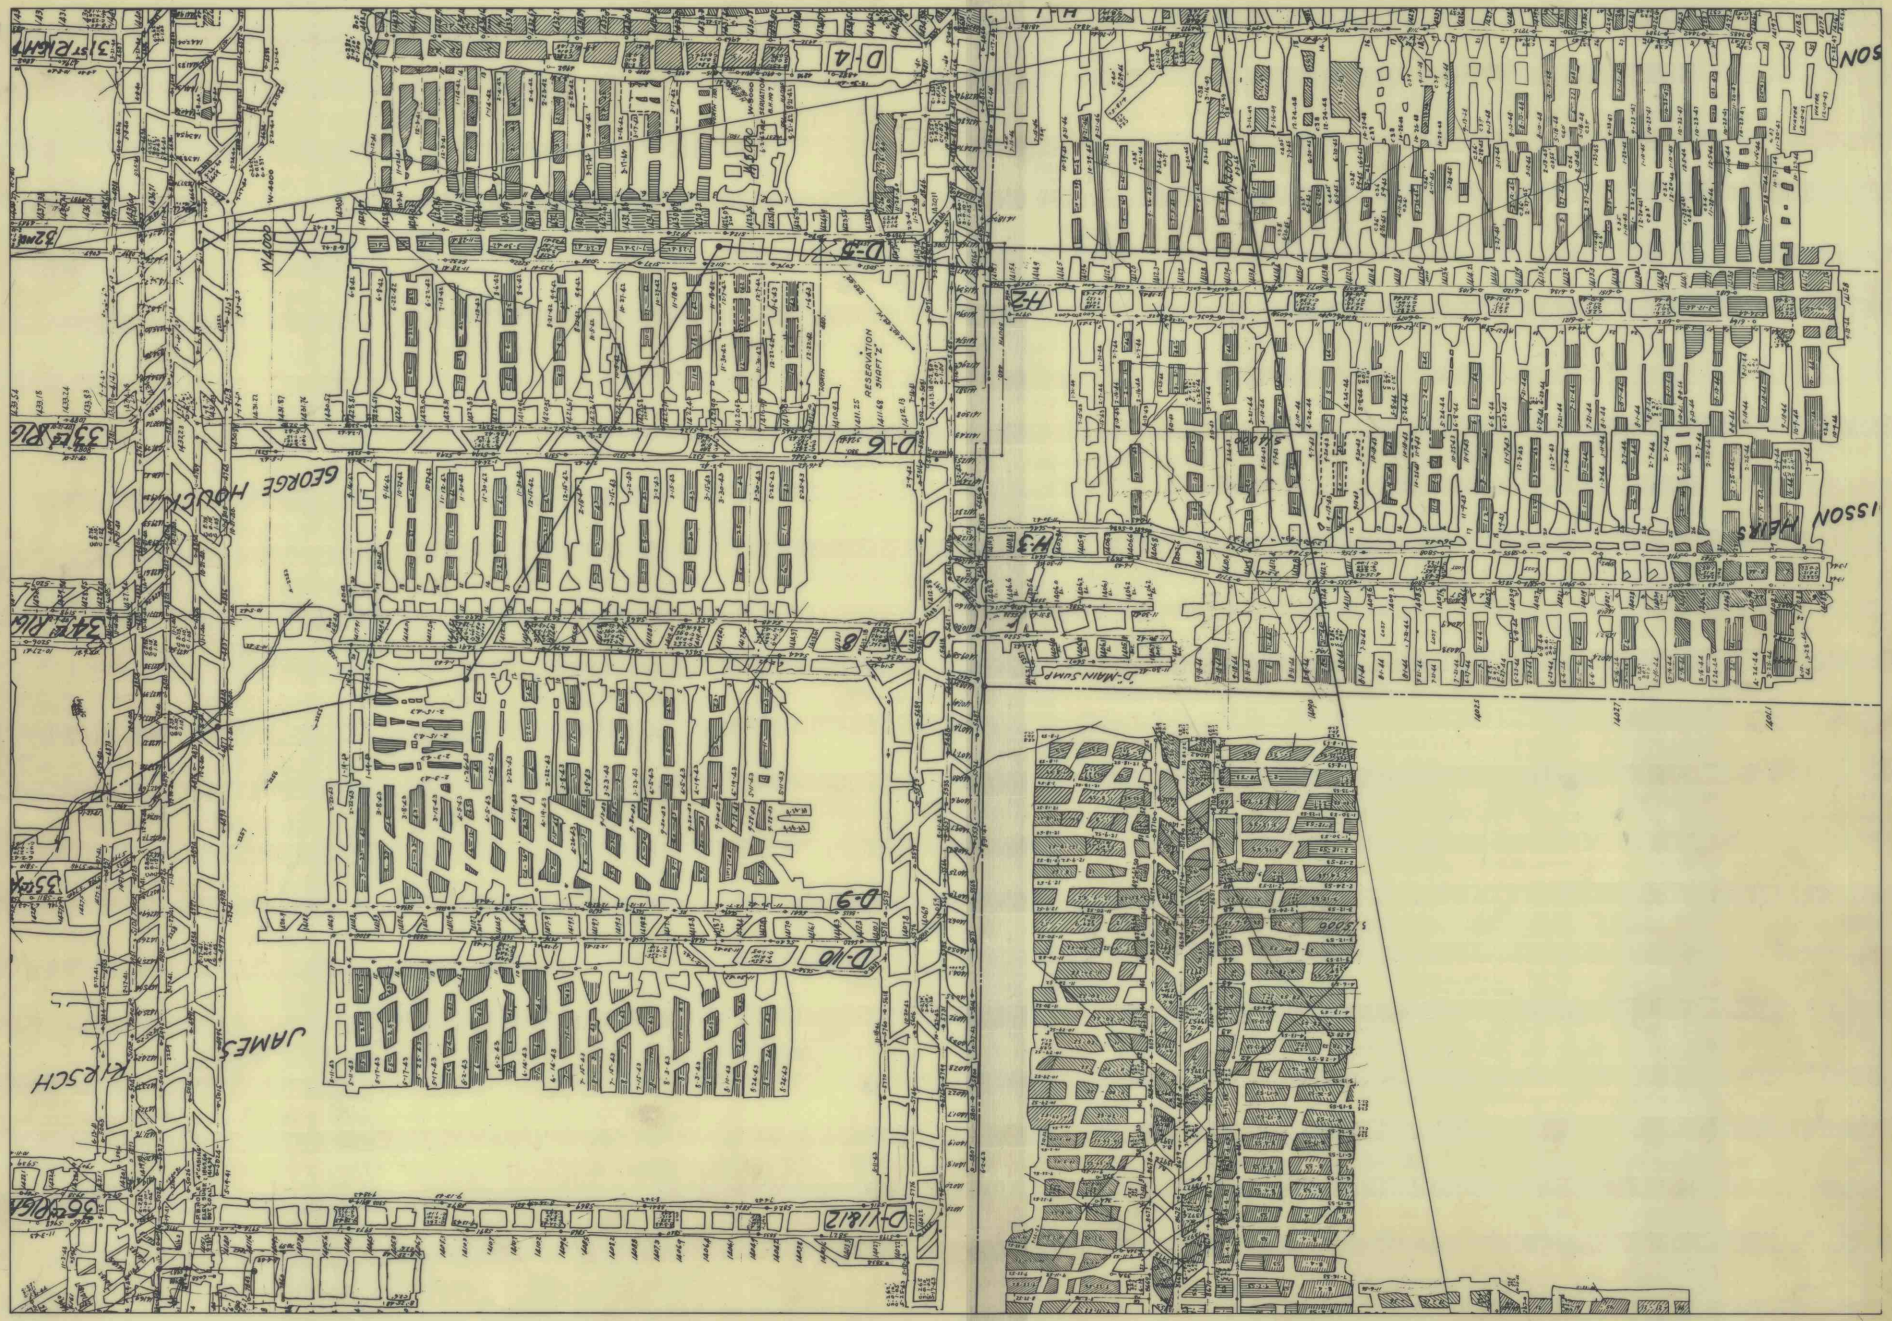

MOSS CREEK MINE