


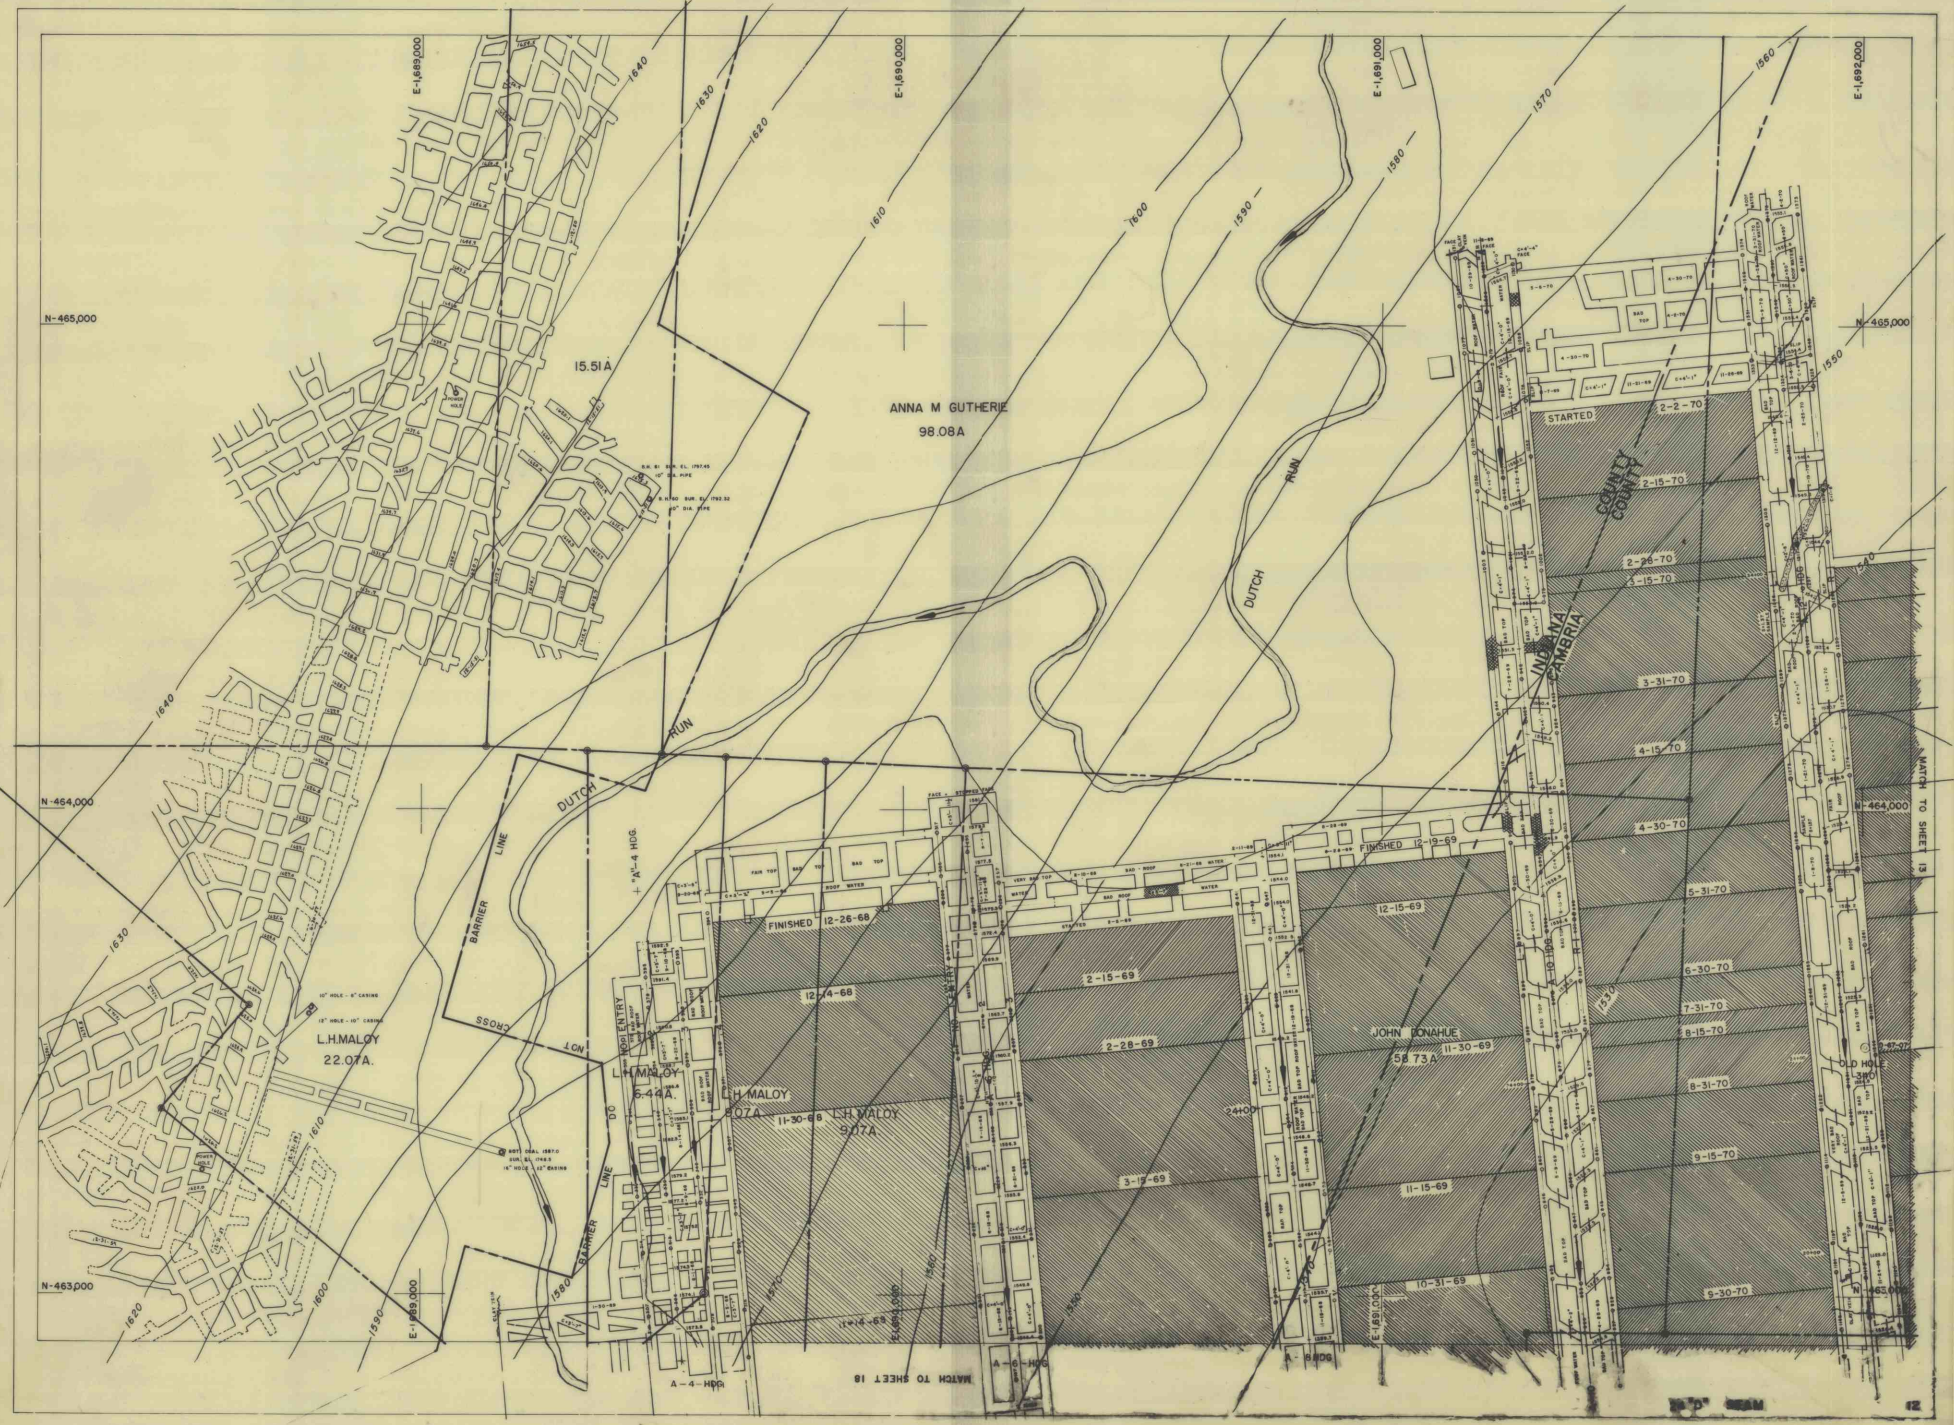

N-465,000

N-464,000

N-463,000





ANNA M GUTHERIE
98.08A

L.H. MALOY
22.07A

L.H. MALOY
6.44A

L.H. MALOY
9.07A

L.H. MALOY
9.07A

JOHN DONAHUE
58.73A

STARTED
COUNTY
COUNTY

MATCH TO SHEET 13

MATCH TO SHEET 18

