


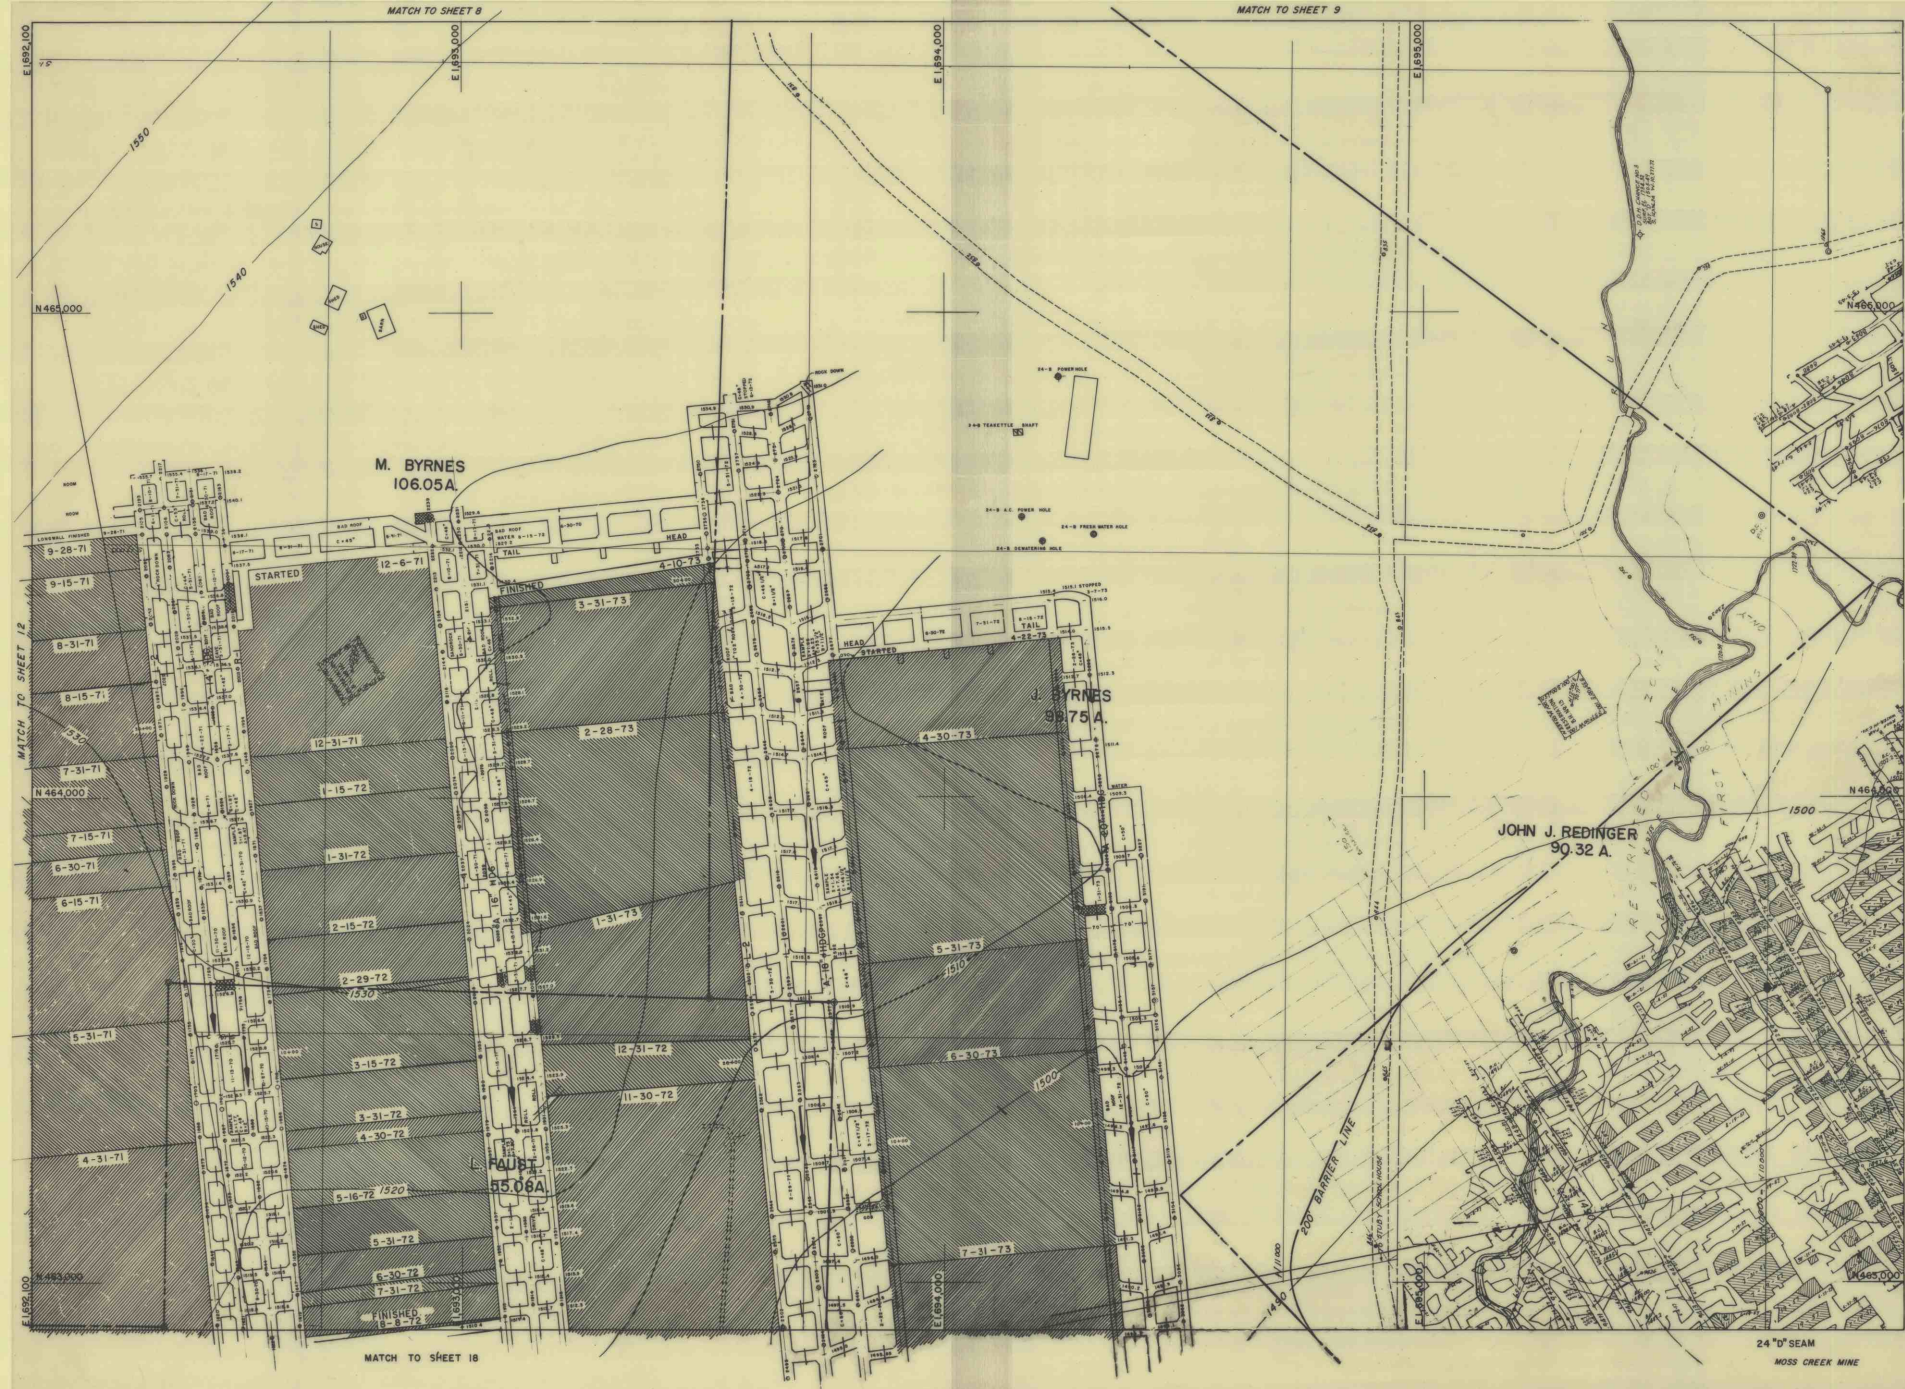

MATCH TO SHEET 18

MATCH TO SHEET 9

24" D SEAM
MOSS CREEK MINE