


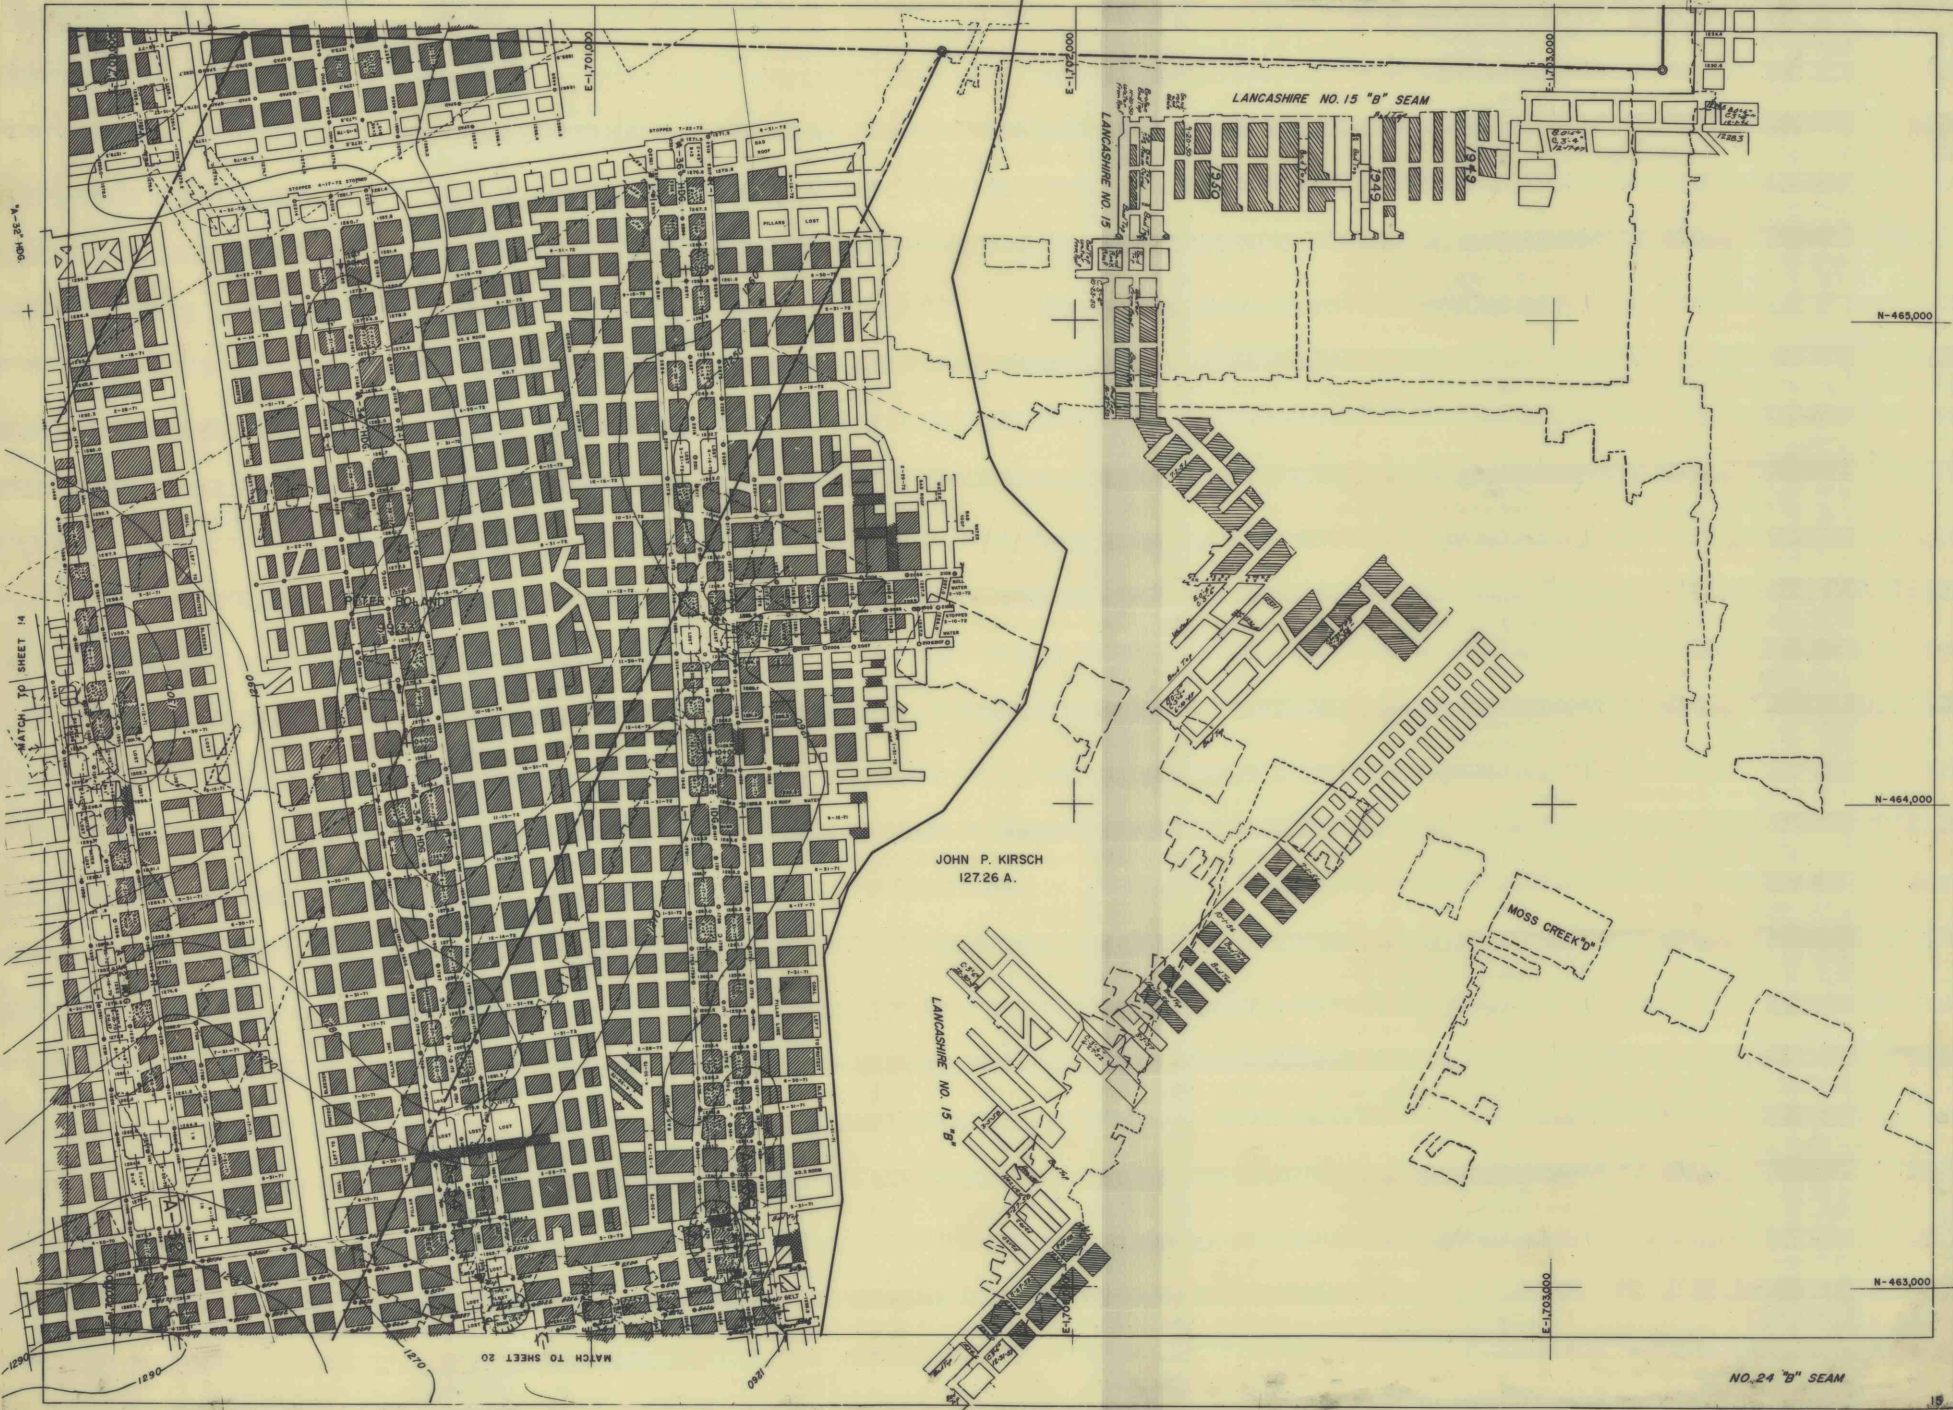

N-465,000

N-464,000

N-463,000

NO. 24 "B" SEAM