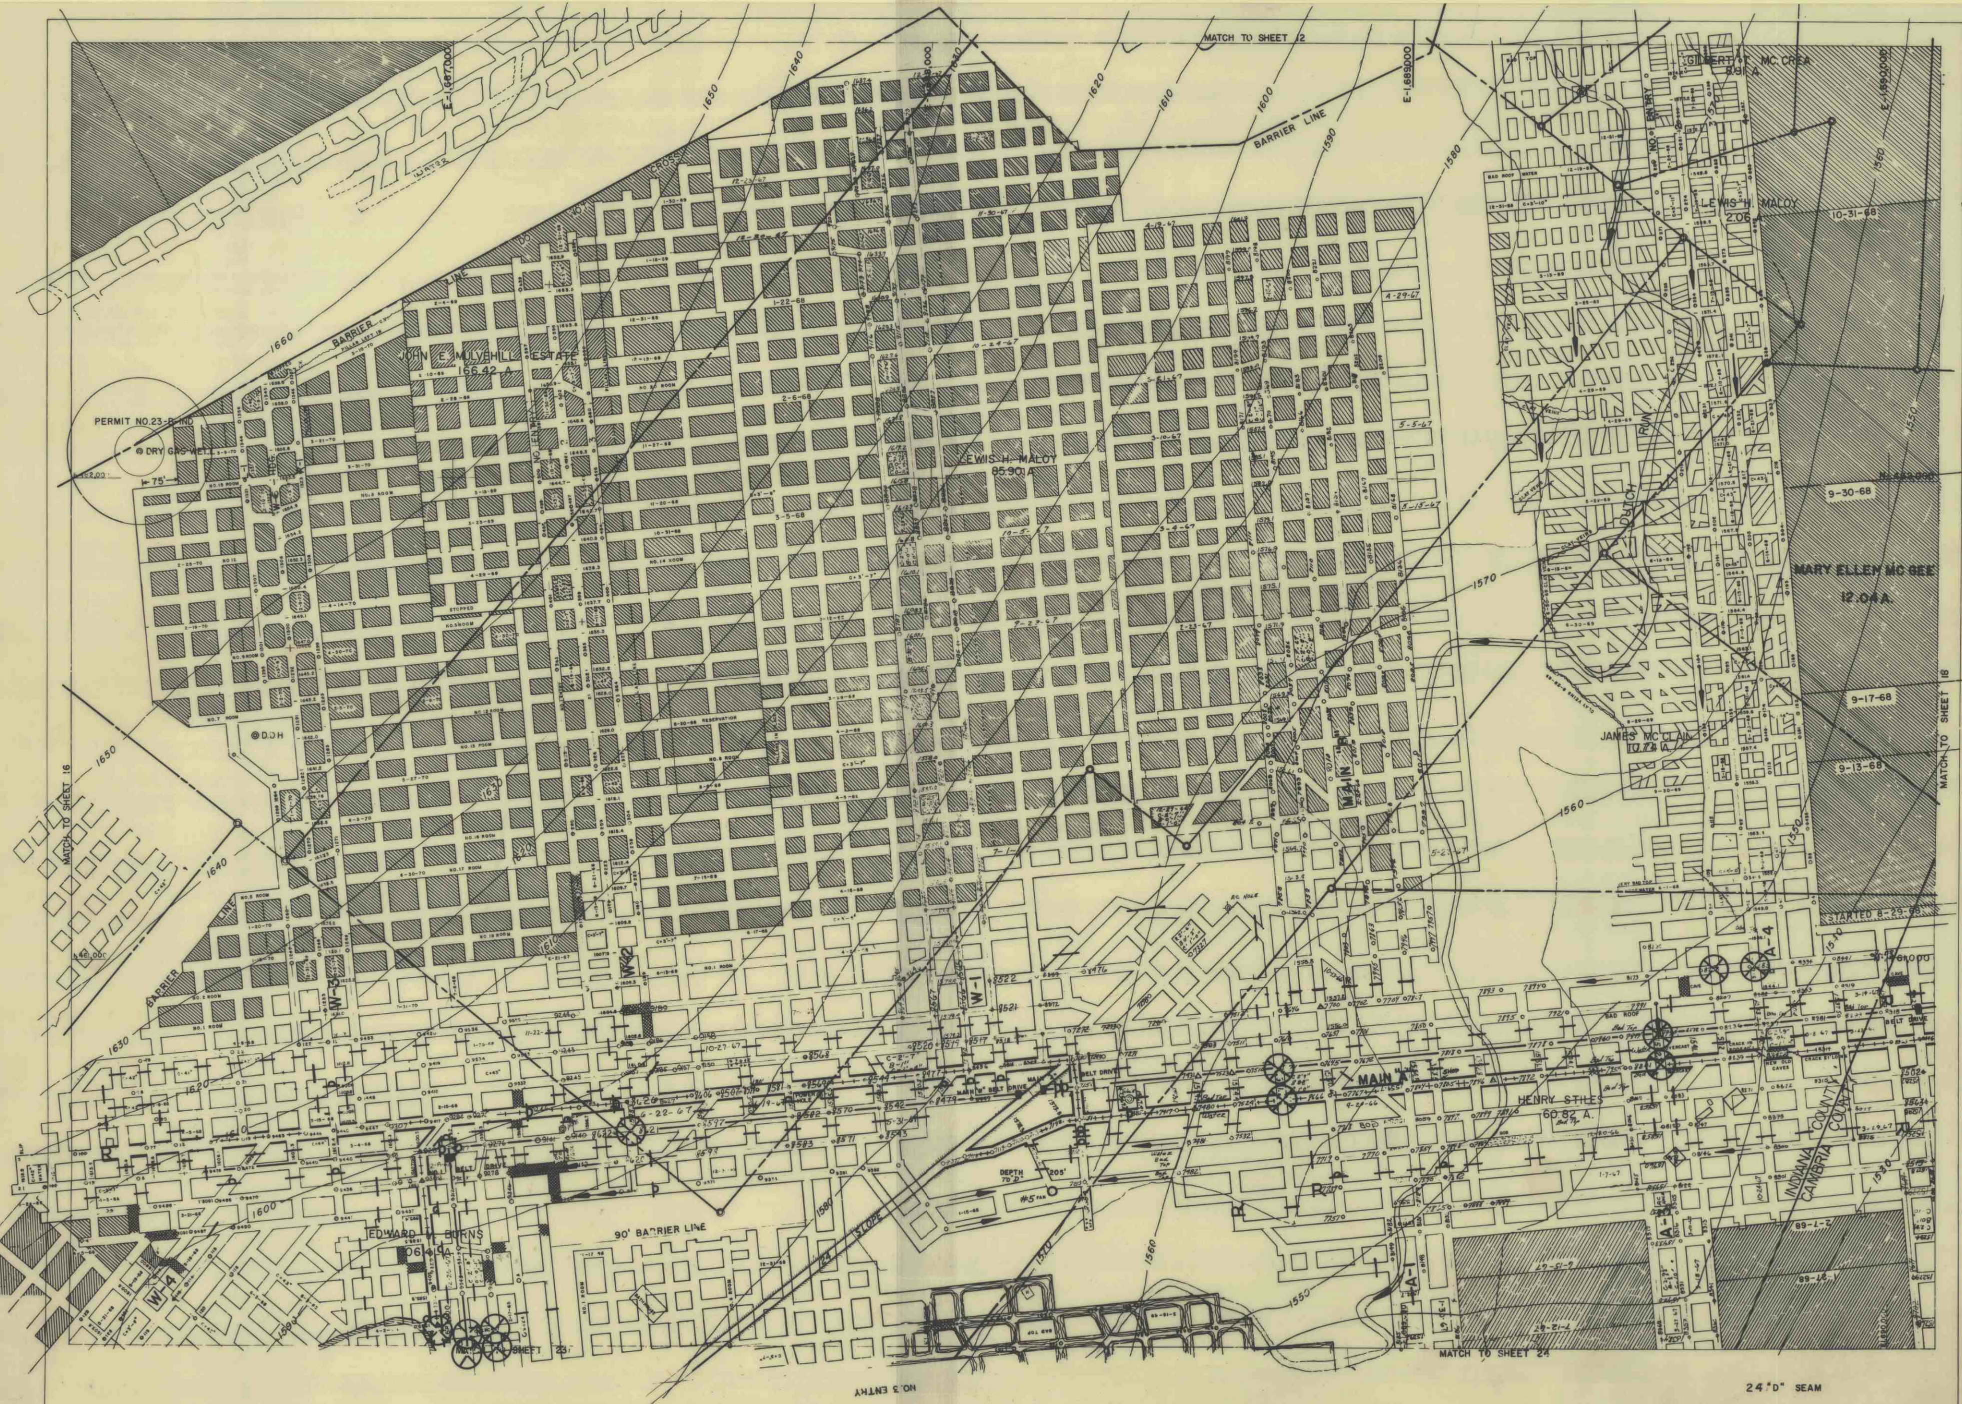
MATCH TO SHEET 12
MATCH TO SHEET 16
MATCH TO SHEET 18
MATCH TO SHEET 23
MATCH TO SHEET 24
E-1,687,000
E-1,688,000
E-1,689,000
E-1,690,000
N-461,000
N-462,000
BARRIER LINE
BARRIER
90' BARRIER LINE
PERMIT NO.23-B IND
DRY GAS WELL
75'
D.D.H
JOHN E. MULVEHILL ESTATE
166.42 A.
LEWIS H. MALOY
85.90 A.
LEWIS H. MALOY
2.06 A.
GILBERT T. MC CREA
8.91 A.
MARY ELLEN MC GEE
12.04 A.
JAMES MC CLAIN
10.74 A.
HENRY STILES
60.82 A.
EDWARD M. BURNS
106.41 A.
DUTCH RUN
NO. 1 ENTRY
NO. 3 ENTRY
MAIN "A"
MAIN "B"
W-1
W-2
W-3
W-4
A-1
A-3
A-4
24" SLOPE
DEPTH TO "D" 205'
#5 FAN
BELT DRIVE
INDIANA COUNTY
CAMBRIA COUNTY
STARTED 8-29-68
10-31-68
9-30-68
9-17-68
9-13-68
1660
1650
1640
1630
1620
1610
1600
1590
1580
1570
1560
1550
1540
1530
24" "D" SEAM